

ORONO COPY

CERTIFICATE OF SURVEY

Survey for: MIKE JOHNSRUD

N

SCALE: 1" = 20'

- Denotes Iron Monument Found
- Denotes Iron Monument Set

DESCRIPTION: Lot 5, Block 1, PAINTERS CREEK

I hereby certify that this survey was prepared by me or under my direct supervision, and that I am a registered land surveyor under the laws of the State of Minnesota. Dated this 17th day of November, 2016.

CARLSON & CARLSON, INC.
LAND SURVEYORS
Tele. No. (952) 888-2084

BY Larry R. Couture
Larry R. Couture, Land Surveyor
Minnesota License No. 9018


Proposed Grades: Garage Floor 1037.3

NOTE: Circled elevations are proposed, others are existing. Arrows denote direction of drainage.

S88°15'00"W
422.73

Drainage & Utility
Easement

S57°29'
S38°00'00"E

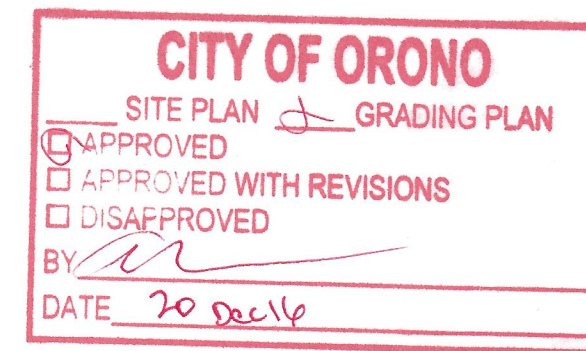

REVISED 12-15-16



352-36

City of Orono
Planning & Zoning Plan Review
Site Plan Review Date: 1-3-17
☒ APPROVED
☐ APPROVED WITH REVISIONS (see notes)
☐ DENIED
Staff: Chattman

135 Luce Line Ridge
2016-01405
Accessory Structure

ORONO COPY