
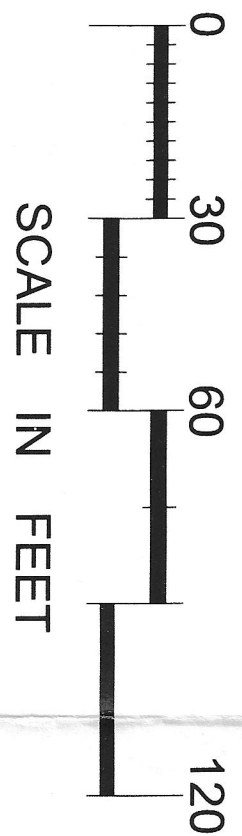


ASBUILT SURVEY FOR
N JAMES CONSTRUCTION
OF LOT 1, BLOCK 1, PINEVIEW
HENNEPIN COUNTY, MINNESOTA

667.34

6TH AVENUE NORTH (C.S.A.H. NO. 6)

OLD
CRYSTAL
BAY
ROAD

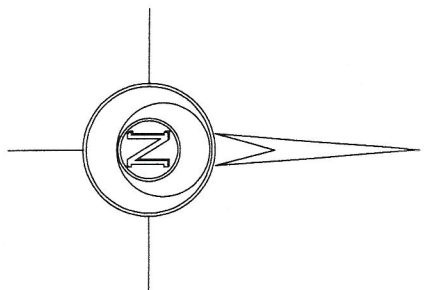

LEGAL DESCRIPTION OF PREMISES:

o : denotes iron marker

— 908 — denotes existing contour line


Bearings shown are based upon an assumed datum.

PROJECT

DATE
6-10-15

SCALE
1"=30'

JOB NO
15-022A

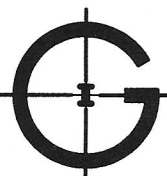

GRONBERG & ASSOCIATES, INC.
CIVIL ENGINEERS, LAND SURVEYORS, LAND PLANNERS
445 NORTH WILLOW DRIVE LONG LAKE, MN 55356
952-473-4141

I hereby certify that this survey, plan, or specification was prepared by me, or under my direct supervision, and that I am a duly Licensed Land Surveyor under the laws of the State of Minnesota.


Mark S. Gronberg Minnesota License Number 12755

REVISIONS	
DATE	REMARKS