


CERTIFICATE OF SURVEY FOR
MATTHEW AND JENNIFER NYQUIST
OF LOT 1, BLOCK 1, PINE VIEW
HENNEPIN COUNTY, MINNESOTA

ORONO COPY

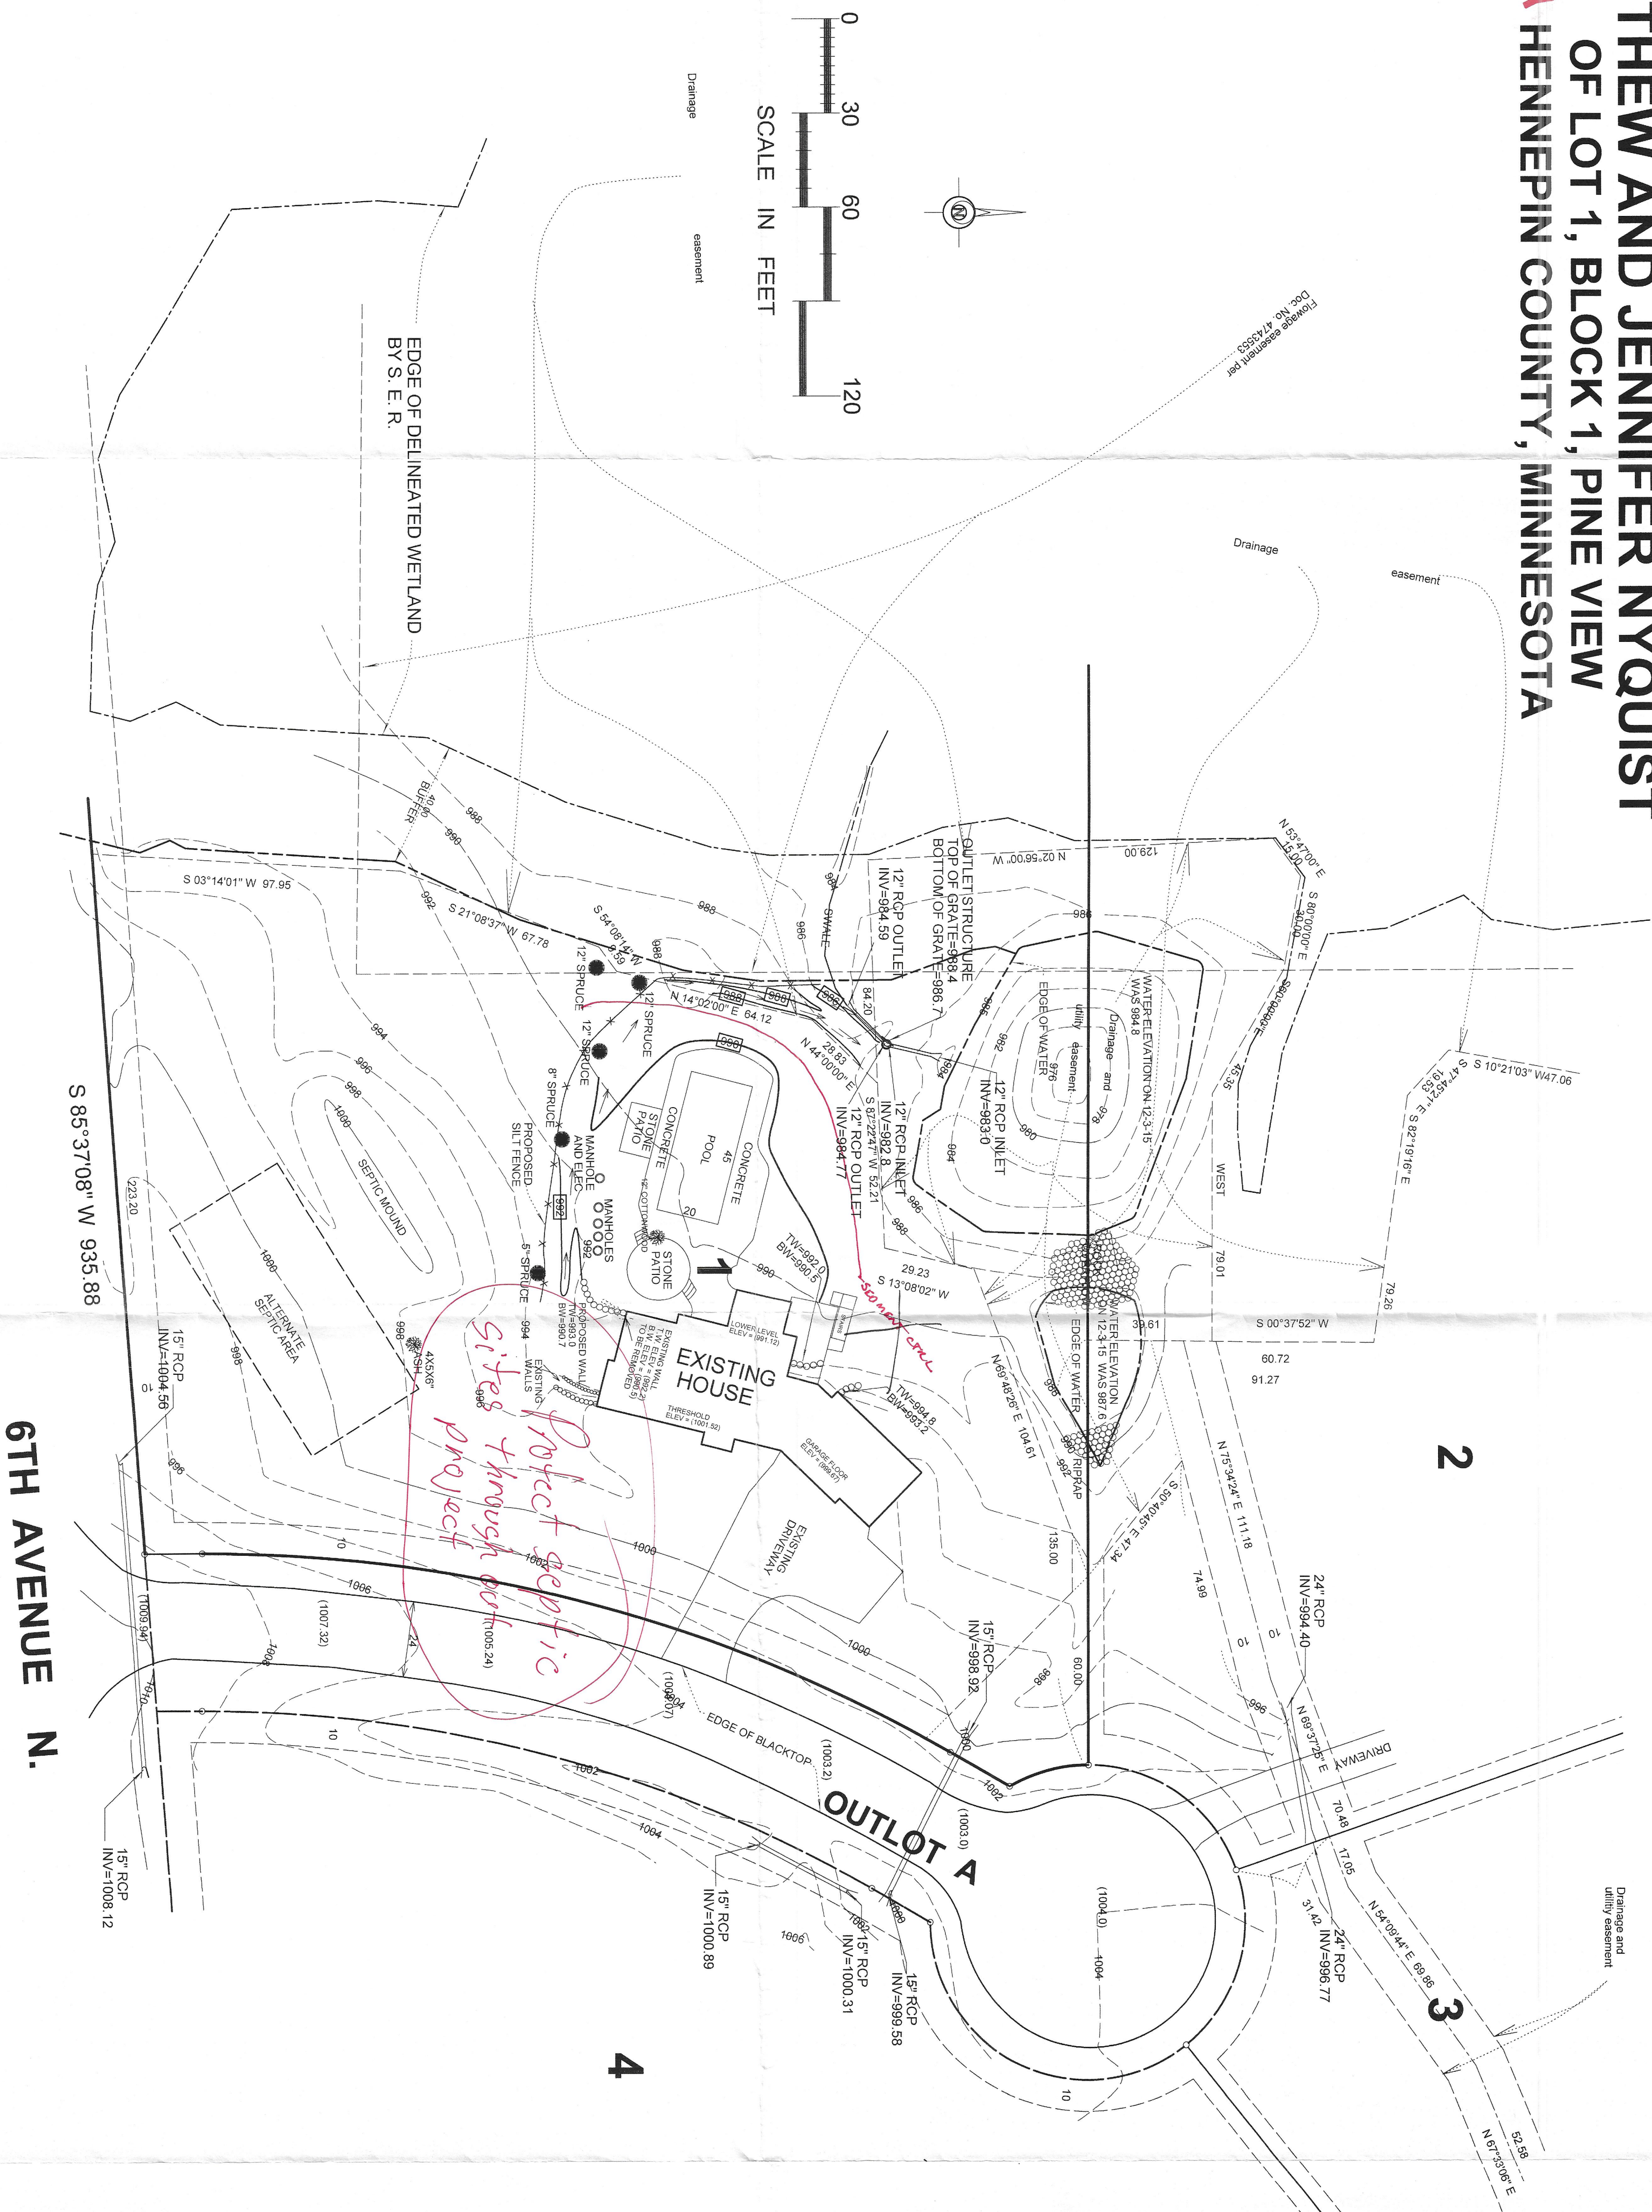

6TH AVENUE N.

ORONO COPY

CITY OF ORONO
SITE PLAN ☒ GRADING PLAN
☐ APPROVED
☒ APPROVED WITH REVISIONS
BY [Signature]
DATE 22 OCT 16

Stamper confirms
to be valid
prior to submission

City of Orono
Planning & Zoning Plan Review
Site Plan Review Date: 11-4-16
APPROVED
BY [Signature]
Staff: Chadler

RECEIVED
OCT 12 2016
CITY OF ORONO

REVISIONS		
DATE	BY	REMARKS

DESIGNED
DRAWN
CHECKED

I hereby certify that this plan, specification, or report was prepared by me or under my direct supervision and that I am a duly Licensed Land Surveyor under the laws of the State of Minnesota.

DATE 10-11-16 MINN. LICENSE NUMBER 12755

DATE
SCALE
1"=30'
16-391
SHEET
5
SHEETS



GRONBERG & ASSOCIATES, INC.
CIVIL ENGINEERS, LAND SURVEYORS, LAND PLANNERS
445 N. WILLOW DRIVE LONG LAKE, MN 55356
PHONE: 952-473-4141 FAX: 952-473-4435

1125 Pine View W.
2016-0339
In-ground pool