


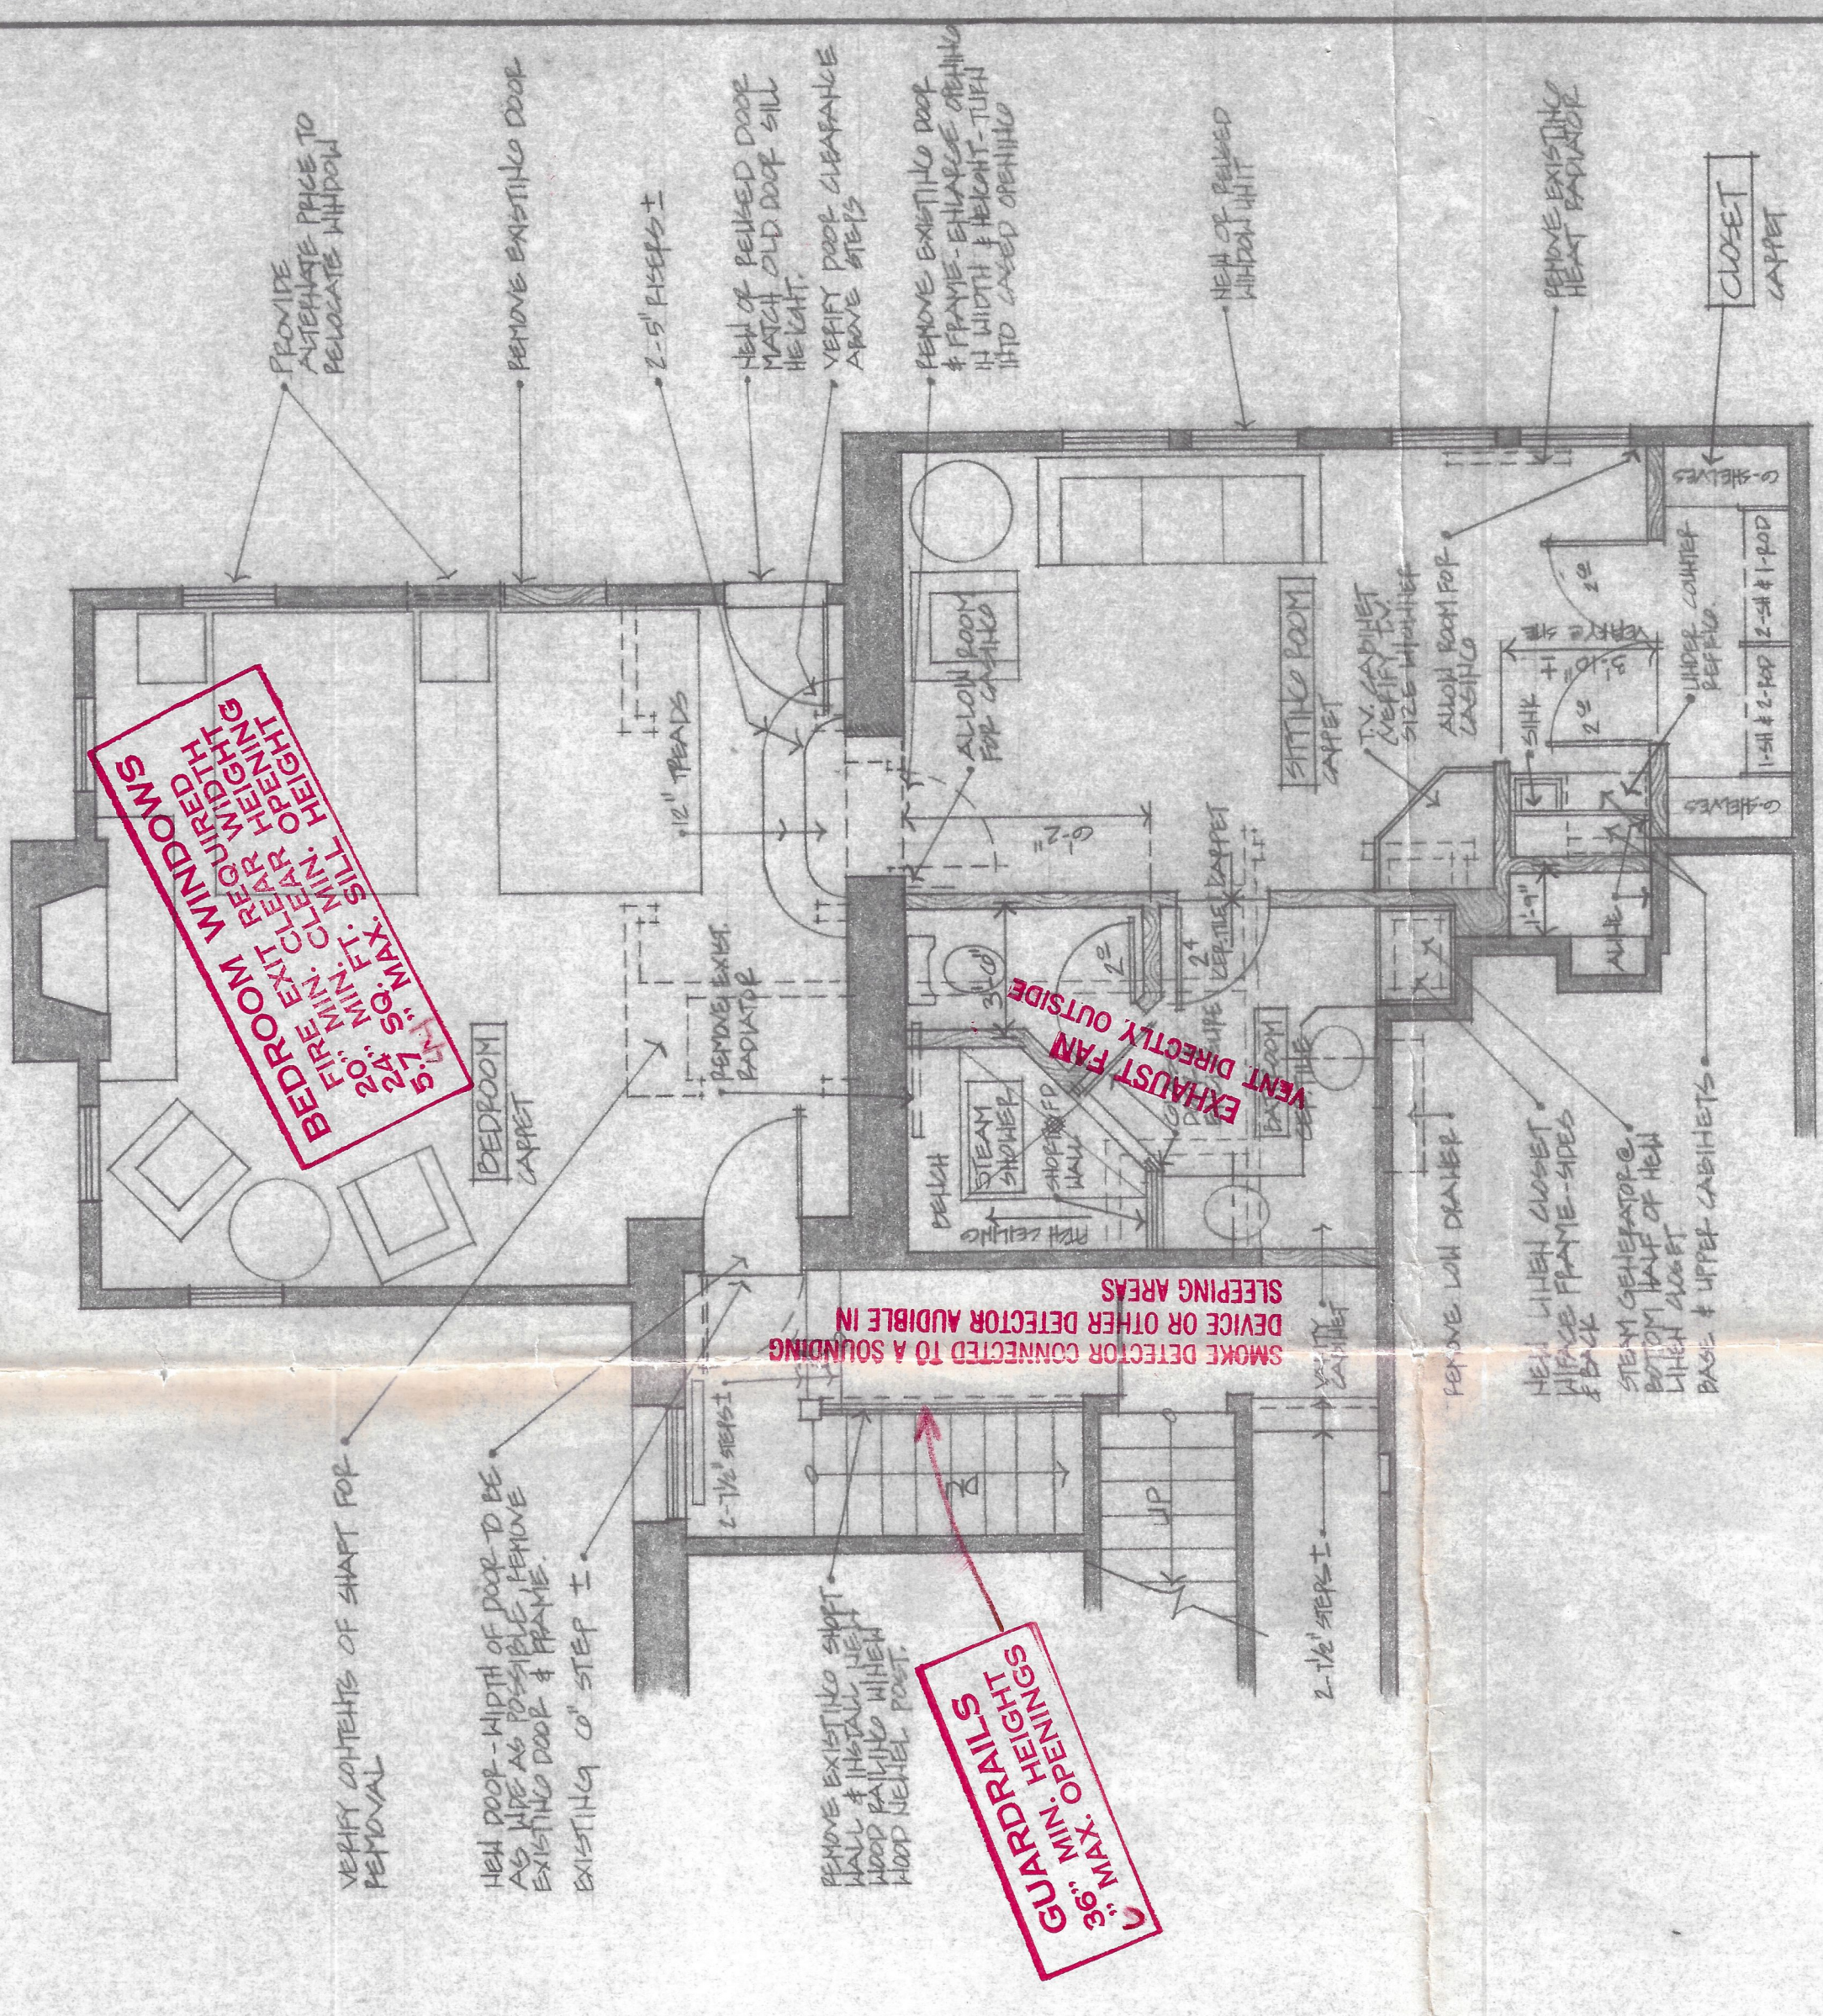


PARTIAL SECOND FLOOR PLAN
SCALE: 1/4" = 1'-0"

CITY OF ORONO
BUILDING PERMIT PLAN REVIEW
INSPECTOR: *[Signature]*
DATE: 2-12-91
PERMIT NO. *[Blank]*
APPROVED AS SUBMITTED
NOT APPROVED WITH CORRECTIONS AS NOTED
NOT APPROVED — CORRECT & RESUBMIT
These comments are for your information. All work must be done in accordance with the City of Orono Building Code. If you have any questions, please call the Building Department at 553-5551. KEEP THIS PLAN SET ON SITE AT ALL TIMES.

GENERAL NOTES:
1. UNLESS OTHERWISE NOTED, ALL MATERIALS TO BE REMOVED ARE INDICATED BY DASHED LINES.

*Permit
1991-549*

ORONO COPY

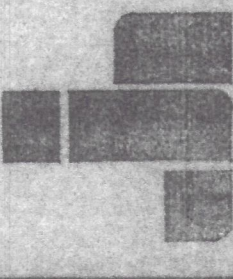BRUCE W. SCHMITT & ASSOCIATES, P.A. 319 BARRY AVENUE, SOUTH WINZATA, MINNESOTA 55391 (612) 476-6222	RESIDENTIAL REMODELING FOR MR. & MRS. IRWIN JACOBS ORONO, MINNESOTA	 JENSEN HOMES, INC.	PRELIMINARY: DECEMBER 19, 1990 REVISED: PRELIMINARY JAN. 31, 1991 SHEET NO. 1 OF 1
--	---	--	--