


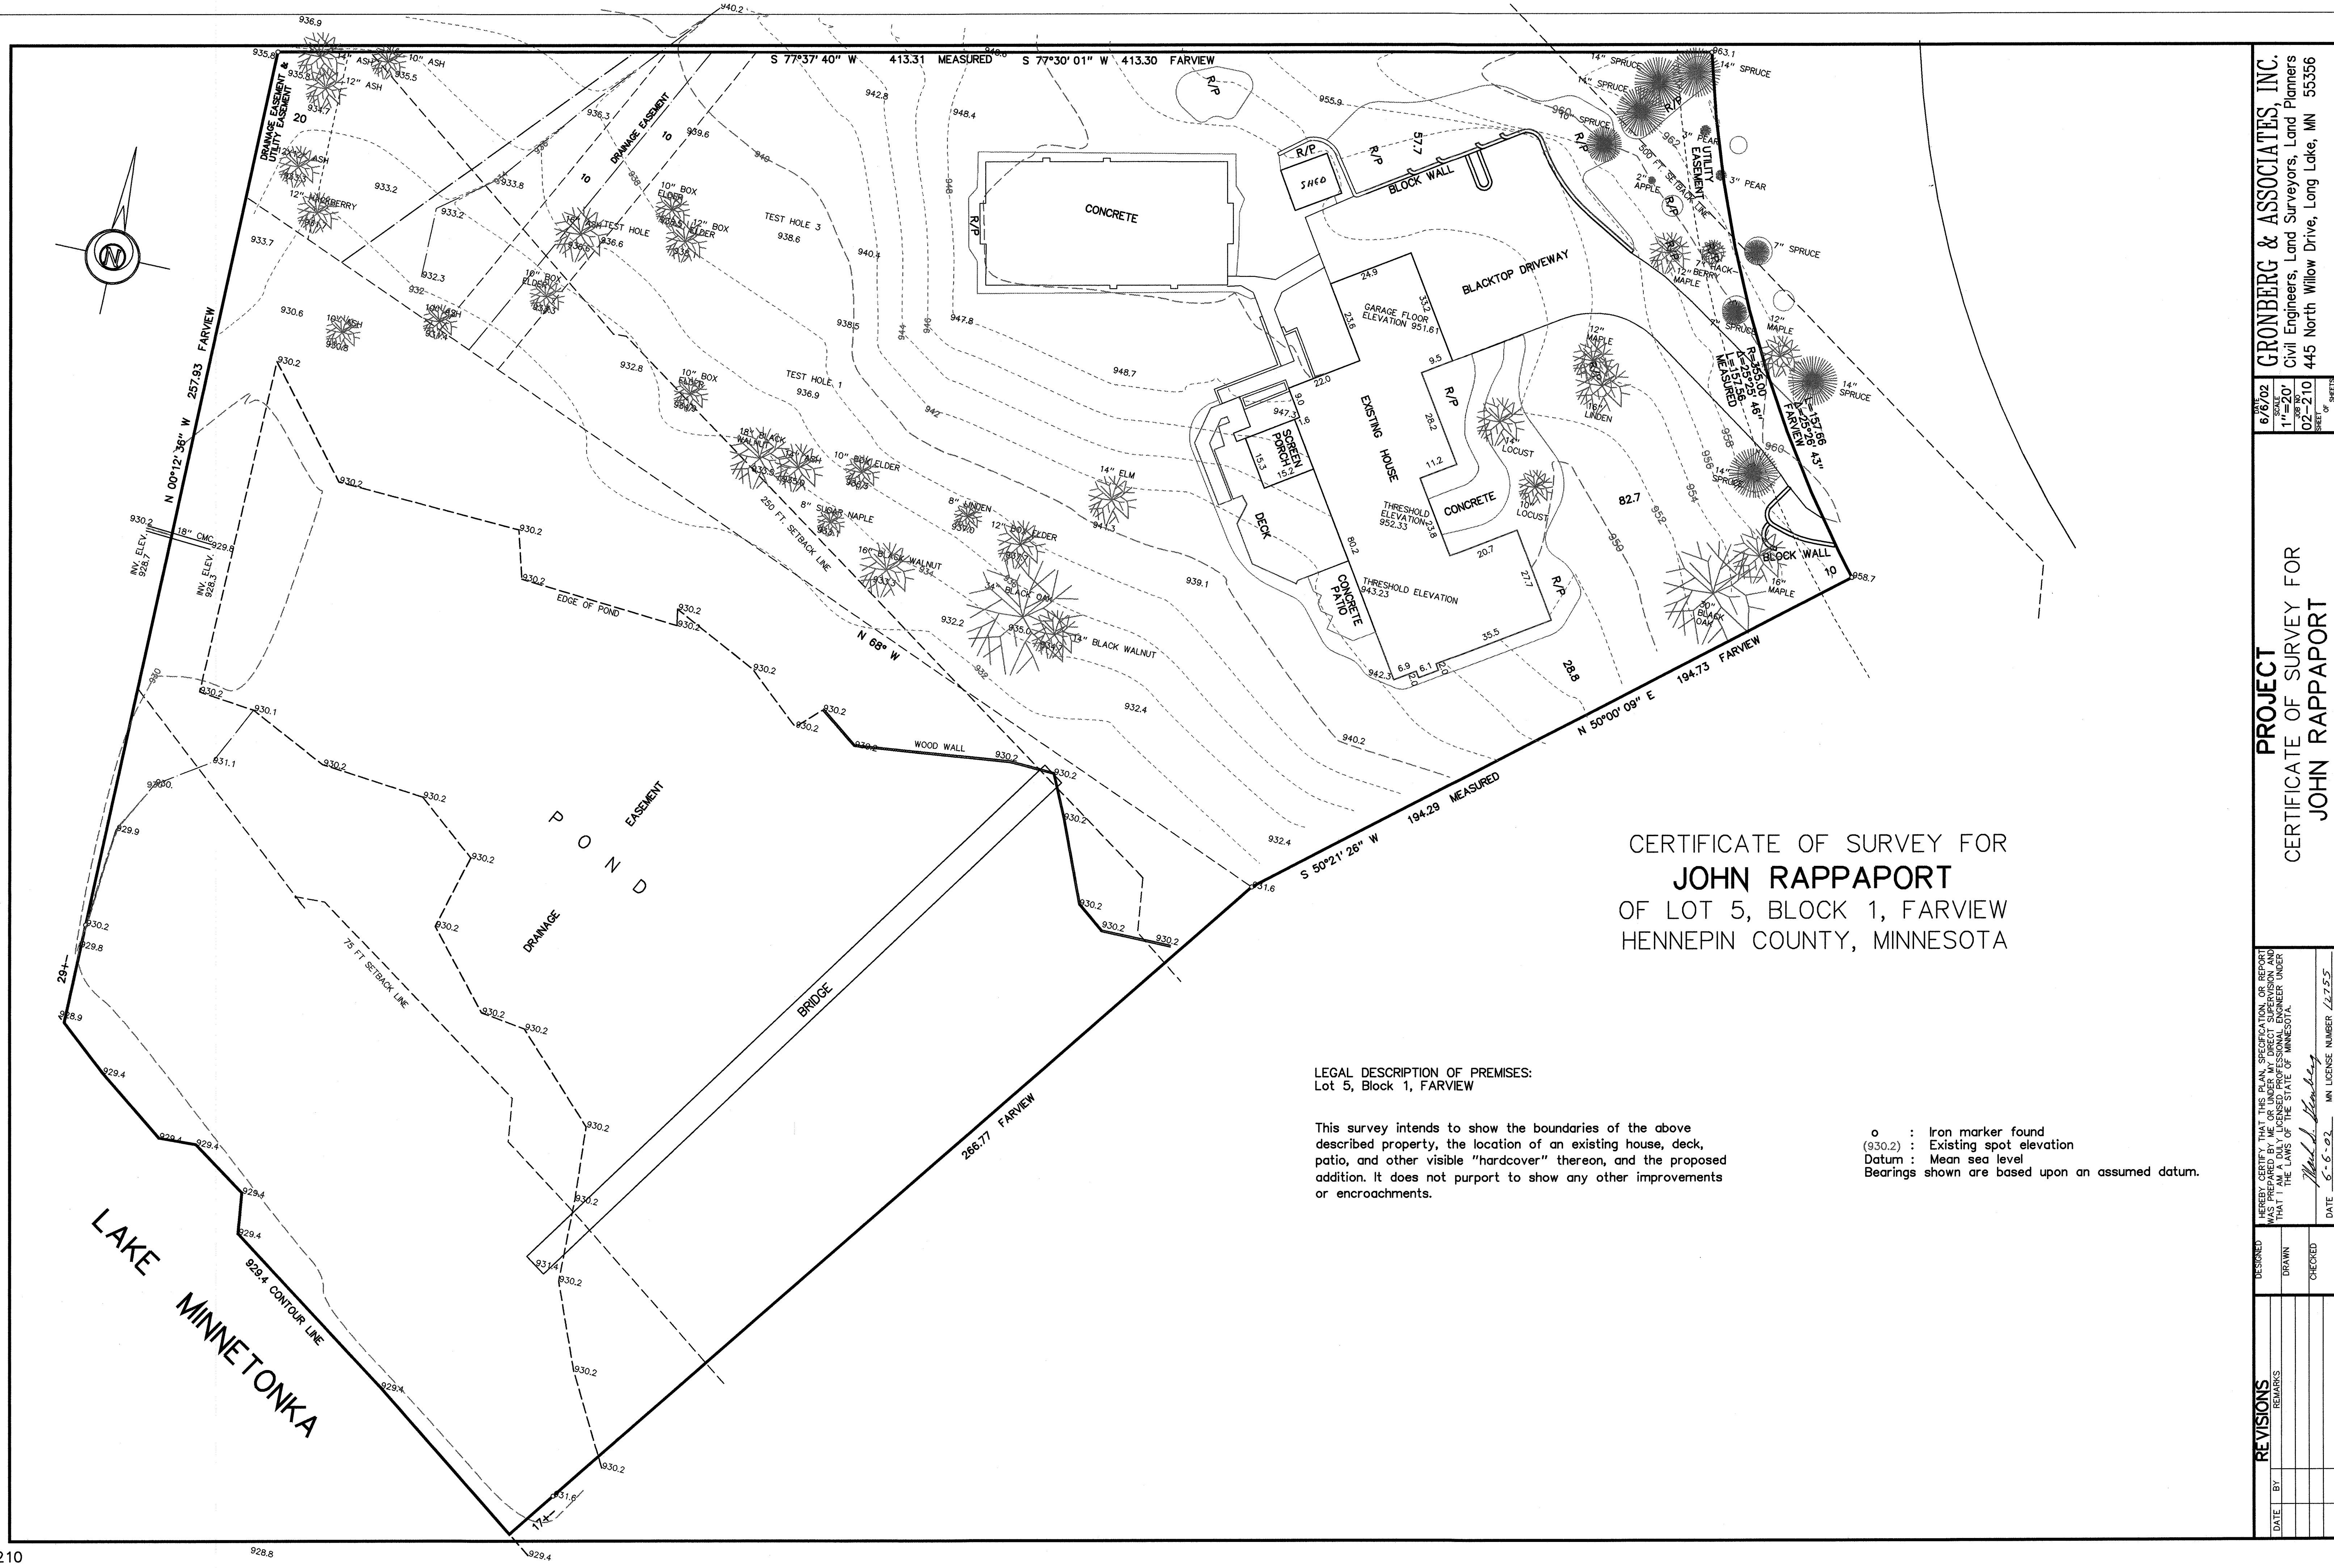

LAKE MINNETONKA

CERTIFICATE OF SURVEY FOR
JOHN RAPPAPORT
OF LOT 5, BLOCK 1, FARVIEW
HENNEPIN COUNTY, MINNESOTA

LEGAL DESCRIPTION OF PREMISES:
Lot 5, Block 1, FARVIEW

This survey intends to show the boundaries of the above described property, the location of an existing house, deck, patio, and other visible "hardcover" thereon, and the proposed addition. It does not purport to show any other improvements or encroachments.

- o : Iron marker found
- (930.2) : Existing spot elevation
- Datum : Mean sea level
- Bearings shown are based upon an assumed datum.

REVISIONS			DESIGNED	DRAWN	CHECKED
DATE	BY	REMARKS			

WE HEREBY CERTIFY THAT THE PLAN, SPECIFICATION OR REPORT
HEREBY SUBMITTED BY US OR UNDER OUR SUPERVISION
AND IN ACCORDANCE WITH THE LAWS OF THE STATE OF MINNESOTA
THAT I AM A FULLY LICENSED PROFESSIONAL ENGINEER UNDER
THE LAWS OF THE STATE OF MINNESOTA.
Mark A. Hennepin
DATE 6-6-22 MN LICENSE NUMBER 22755

PROJECT
CERTIFICATE OF SURVEY FOR
JOHN RAPPAPORT

6/6/22
6/6/22
1"=20'
02-210
SHEET 1 OF 2
GRONBERG & ASSOCIATES, INC.
Civil Engineers, Land Surveyors, Land Planners
445 North Willow Drive, Long Lake, MN 55356