


WILKINSON COUNTY, MINNESOTA

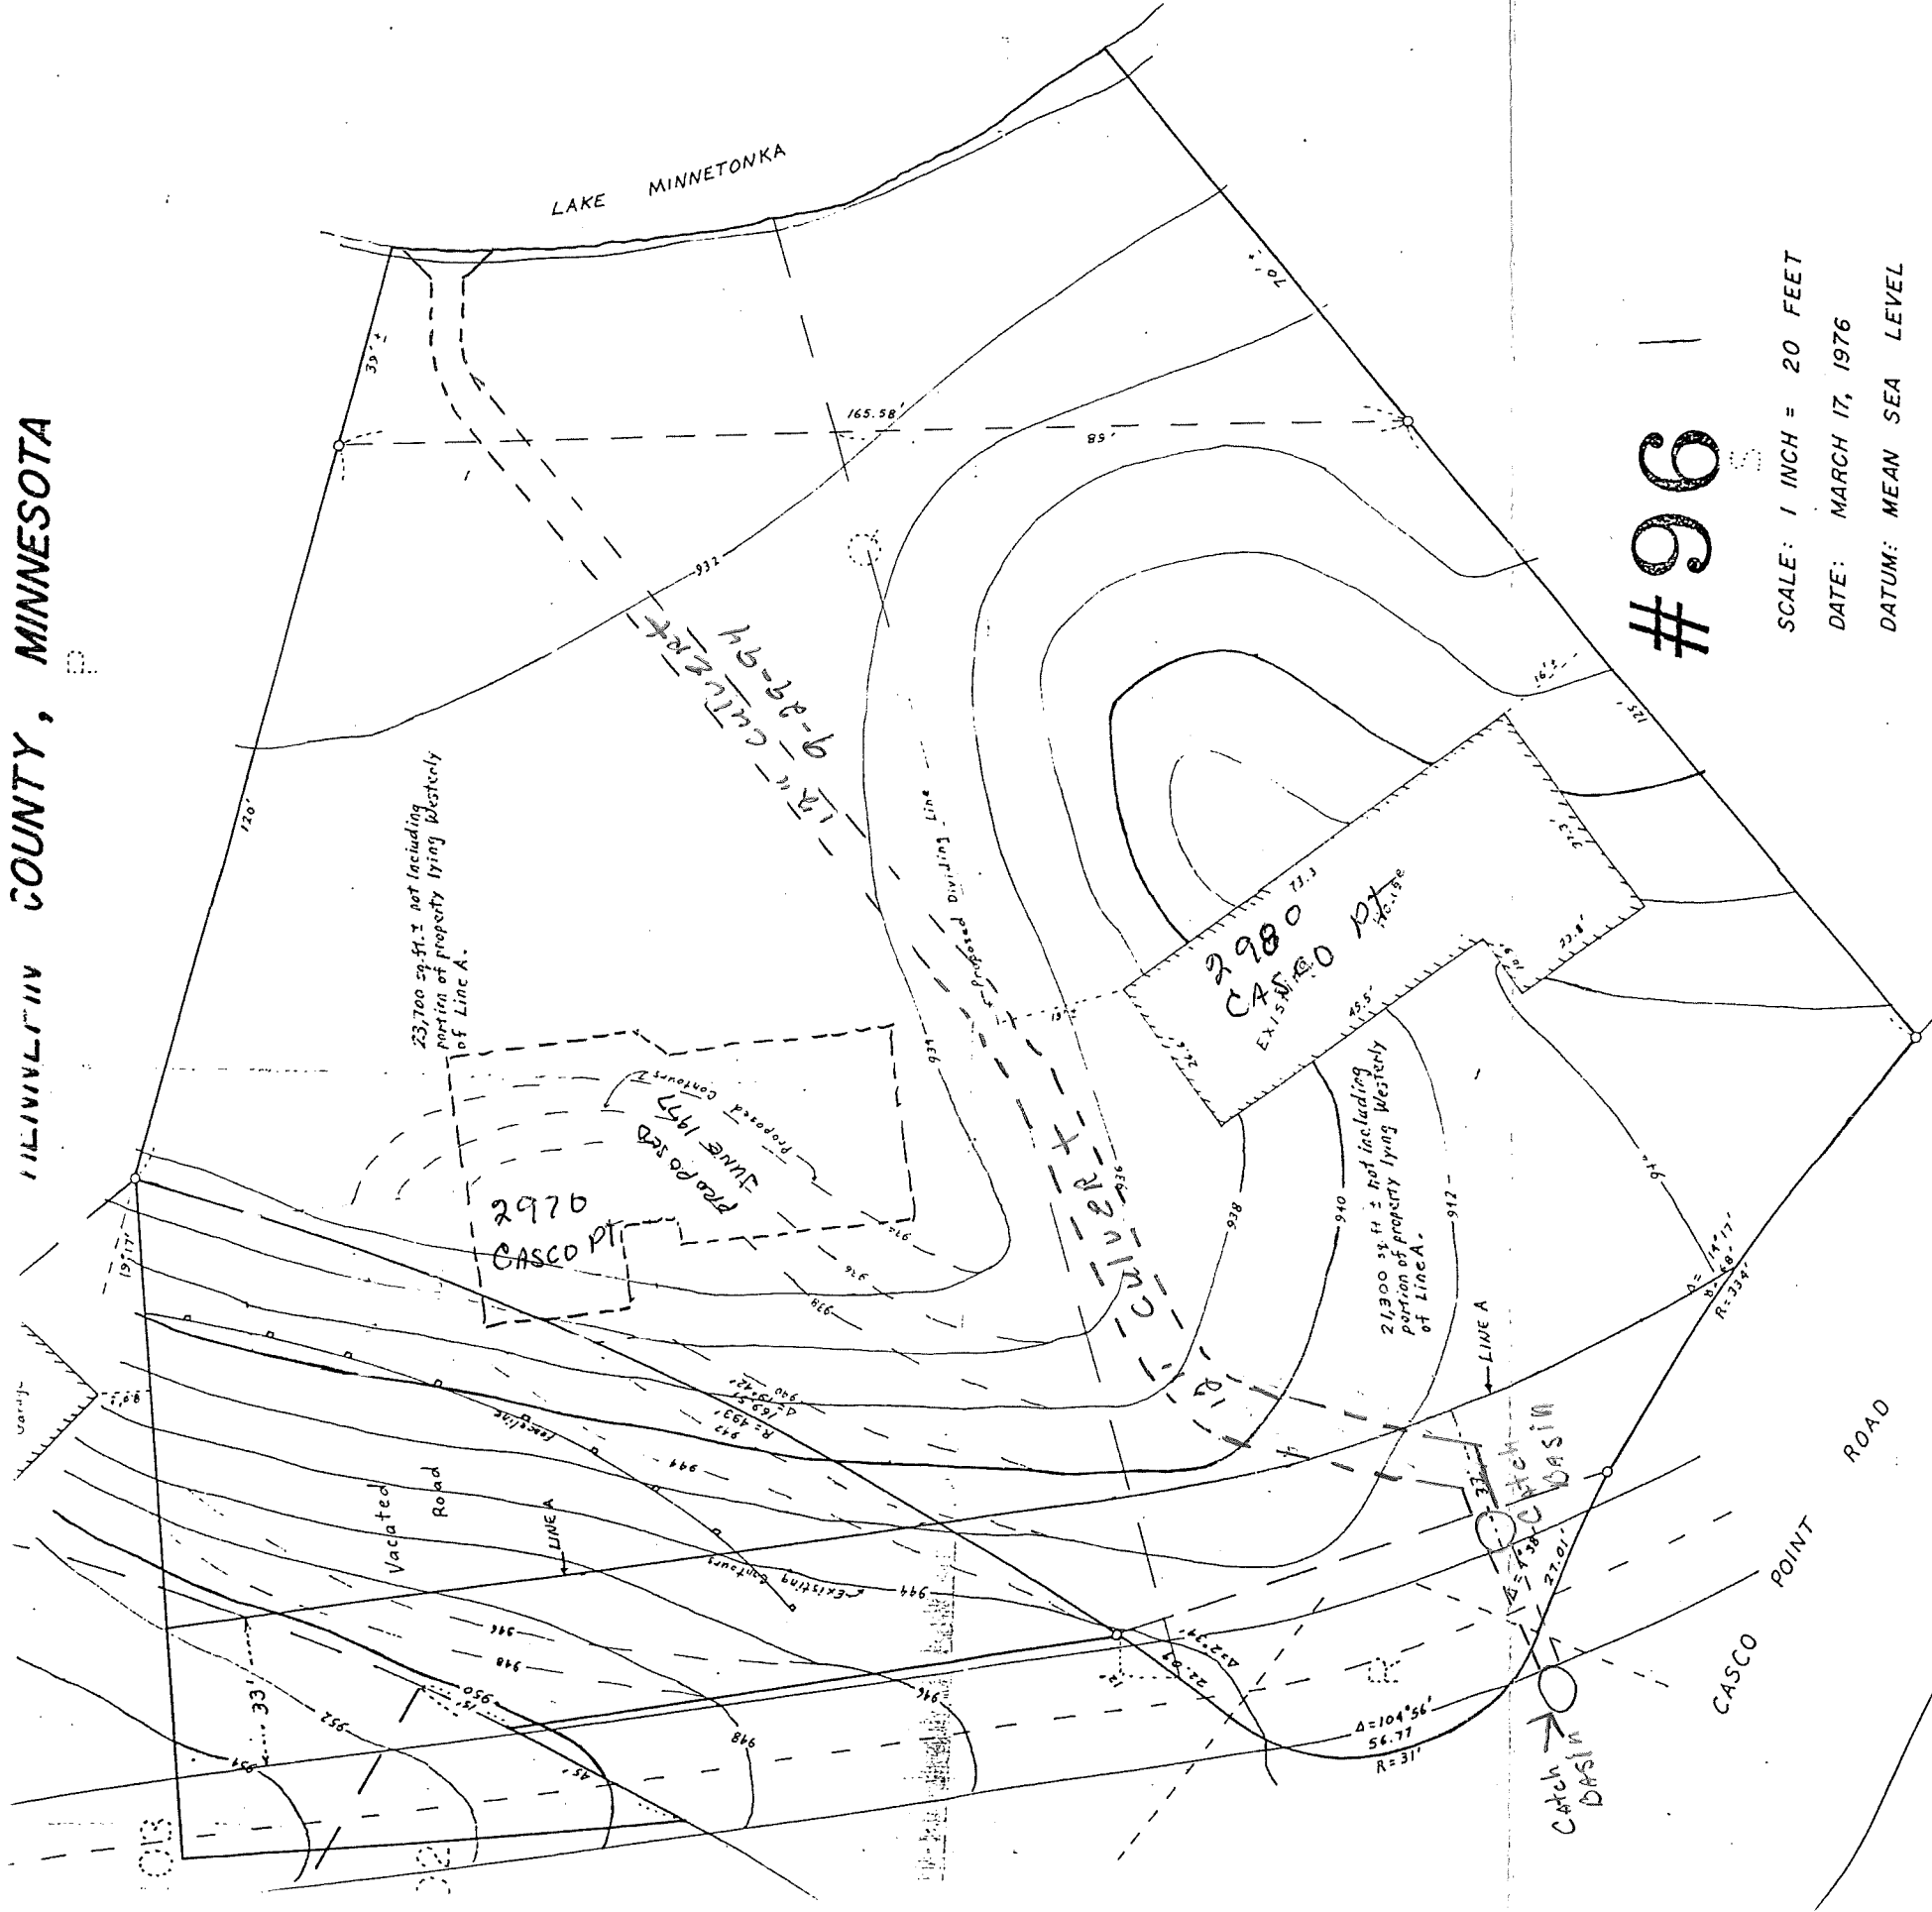

#96

SCALE: 1 INCH = 20 FEET

DATE: MARCH 17, 1976

DATUM: MEAN SEA LEVEL

GORDON R. CL  
LAND SURVEYOR &  
LONG LAKE, MINNE

I hereby certify that this survey  
was prepared by me or under my

1"=30'