

AS-BUILT ELEVATIONS:

LOTS 1, 2, & 3  
TOP OF FOUNDATION / SOG = 1023.4  
GARAGE FLOOR 1 STEP = 1022.3  
\*GARAGE TO BE RAISE .30 AFTER FINAL POUR\*

LOTS 4 & 5  
TOP OF FOUNDATION / SOG = 1023.4  
GARAGE FLOOR = 1022.7  
\*GARAGE TO BE RAISE .30 AFTER FINAL POUR\*

FOUNDATION AS-BUILT FOR:  
DAVID WEEKLEY HOMES

12900 Whitewater Drive, Suite 180  
Minnetonka, MN 55343

DAVID WEEKLEY HOMES PLAN:

B763 - "BRINLEY"  
-SLAB ON GRADE-  
(ELEV. A)  
PLAN DATE: 10/26/2021

B764 - "HALL"  
-SLAB ON GRADE-  
(ELEV. A)  
PLAN DATE: 10/26/2021

B764 - "HALL"  
-SLAB ON GRADE-  
(ELEV. B)  
PLAN DATE: 10/26/2021

LEGAL DESCRIPTION

LOTS 1, 2, 3, 4, & 5, BLOCK 4,  
ORONO CROSSINGS, ORONO, MINNESOTA.

ADDRESS:

605, 609, 613, 617, & 621  
BLOSSOM CIRCLE

LOT AREA:

LOT 1- 605 BLOSSOM CIRCLE  
LOT AREA = 2,019 SQ. FT. OR 0.046 ACRES  
IMPERVIOUS AREA = 1,375 SQ. FT. (68%)  
BUILDING FOOTPRINT AREA = 1,155 SQ. FT.  
DRIVEWAY = 192 SQ. FT.  
COVERED PORCH = 10 SQ. FT.  
CONCRETE PAD = 18 SQ. FT.

LOT 2 - 609 BLOSSOM CIRCLE  
LOT AREA = 1,641 SQ. FT. OR 0.038 ACRES  
IMPERVIOUS AREA = 1,345 SQ. FT. (82%)  
BUILDING FOOTPRINT AREA = 1,139 SQ. FT.  
DRIVEWAY = 195 SQ. FT.  
COVERED PORCH = 11 SQ. FT.

LOT 3 - 613 BLOSSOM CIRCLE  
LOT AREA = 1,565 SQ. FT. OR 0.035 ACRES  
IMPERVIOUS AREA = 1,393 SQ. FT. (89%)  
BUILDING FOOTPRINT AREA = 1,139 SQ. FT.  
DRIVEWAY = 240 SQ. FT.  
COVERED PORCH = 14 SQ. FT.

LOT 4 - 617 BLOSSOM CIRCLE  
LOT AREA = 1,540 SQ. FT. OR 0.035 ACRES  
IMPERVIOUS AREA = 1,420 SQ. FT. (92%)  
BUILDING FOOTPRINT AREA = 1,139 SQ. FT.  
DRIVEWAY = 267 SQ. FT.  
COVERED PORCH = 14 SQ. FT.

LOT 5 - 621 BLOSSOM CIRCLE  
LOT AREA = 1,890 SQ. FT. OR 0.043 ACRES  
IMPERVIOUS AREA = 1,461 SQ. FT. (77%)  
BUILDING FOOTPRINT AREA = 1,155 SQ. FT.  
DRIVEWAY = 275 SQ. FT.  
COVERED PORCH = 13 SQ. FT.  
CONCRETE PAD = 18 SQ. FT.

NOTES:

1. SURVEY PREPARED FROM ALLIANT ENGINEERING, GRADING PLAN DATED NOVEMBER 10, 2021.
2. BEARINGS ARE ASSUMED PER PLAT.
3. BUILDING DIMENSIONS SHOWN ARE BASED ON FIRST FLOOR ARCHITECTURAL PLANS. ALL DIMENSIONS AND LOCATIONS ARE TO BE VERIFIED IN THE FIELD WITH THE ARCHITECTURAL PLANS.


PROPOSED ELEVATIONS:

LOTS 1, 2, & 3  
TOP OF FOUNDATION / SOG = 1023.4  
GARAGE FLOOR 1 STEP = 1022.3  
REAR = 1022.7

LOTS 4 & 5  
TOP OF FOUNDATION / SOG = 1023.4  
GARAGE FLOOR = 1023.0  
REAR = 1022.7

LEGEND:

- 934.0 EXISTING ELEVATION  
934.0 PROPOSED ELEVATION  
DIRECTION OF DRAINAGE  
CS CURB STOP  
EOF EMERGENCY OVERFLOW  
LFE LOWEST POSSIBLE FLOOR  
TW TOP OF WALL  
TC TOP OF CURB  
E ELECTRIC BOX  
T TELEPHONE BOX  
C CABLE TV BOX  
O SET CAP IRON MONUMENT 44110  
(P) PROPOSED ELEVATION  
900 PROPOSED CONTOURS  
WETLAND MONUMENT  
BUILDING PAD

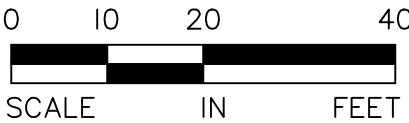

David Weekley Job #: 33-37	Date Staked: 6/15/22	I hereby certify that this survey, plan, or report was prepared by me or under my direct supervision and that I am a duly Licensed Land Surveyor under the laws of the state of Minnesota.
Alliant Job # 20-0101	Checked By: PG	PETER GOERS Print Name
Field Crew: CE	Drawn By: TL	Signature JUNE 16, 2022 Date 44110 License Number

ORONO CROSSINGS  
LOTS 1, 2, 3, 4, & 5, BLOCK 4  
ORONO, MINNESOTA



Alliant Engineering, Inc.  
733 Marquette Ave, Ste 700  
Minneapolis, MN 55402  
612.758.3080 MAIN  
612.758.3099 FAX  
www.alliant-inc.com