**From:** gnelson@ci.orono.mn.us **Sent:** 02/17/2023 - 01:31 PM

**To:** jesherman@dwhomes.com,lhamling@dwhomes.com

**CC:** gnelson@ci.orono.mn.us **Subject:** Inspection Report Individual



CITY OF ORONO 2750 KELLEY PARKWAY ORONO, MN 55356 PH: (952) 249-4600

FAX: (952) 249-4616

### **Inspection Report**

617 Blossom Circle

Permit Number: RPS22-000040

Site Address: 617 Blossom Circle, Orono, MN 00000

Property Owner:

Description: New 5 unit town home

Inspection Date: 02/17/2023 Inspection Type: Building Final Inspection Results: **Permit Finaled** 

Sincerely,

Gary Nelson 952-242-4442

To schedule your inspections please call: (952) 249-4600

CODE REQUIREMENTS ARE FOR YOUR PERSONAL HEALTH AND SAFETY!

#### **AS-BUILT ELEVATIONS:**

LOTS 1, 2, & 3


TOP OF FOUNDATION / SOG = 1023.4 GARAGE FLOOR 1 STEP = 1022.3 \*GARAGE TO BE RAISE .30 AFTER FINAL POUR\*

#### LOTS 4 & 5

TOP OF FOUNDATION / SOG = 1023.4 GARAGE FLOOR = 1022.7 \*GARAGE TO BE RAISE .30 AFTER FINAL POUR\*

# FOUNDATION AS-BUILT FOR: DAVID WEEKLEY HOMES

12900 Whitewater Drive, Suite 180 Minnetonka, MN 55343

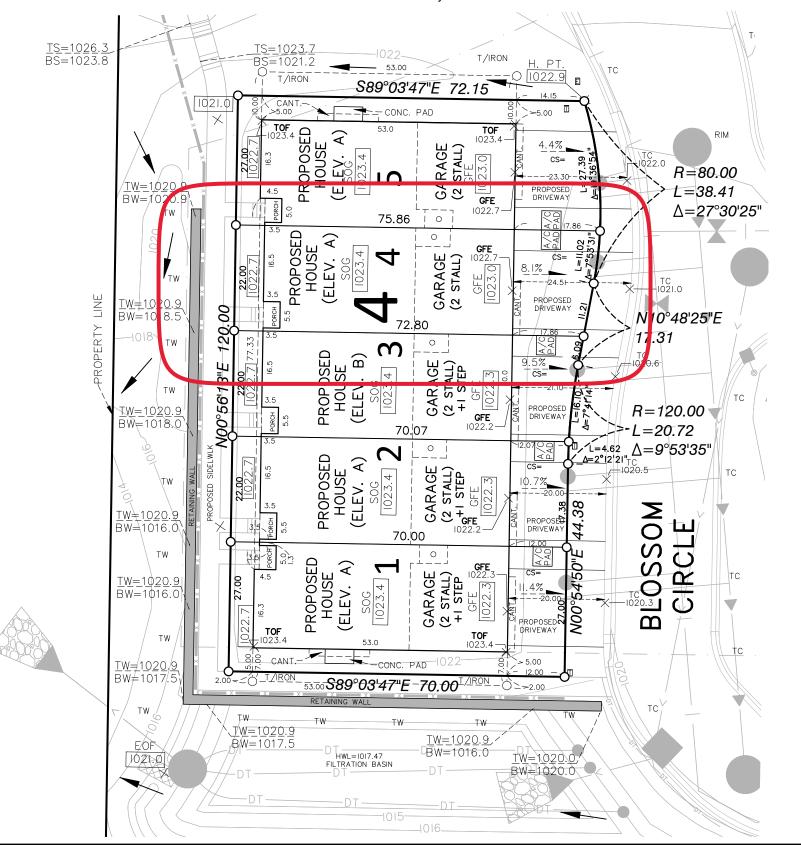

#### DAVID WEEKLEY HOMES PLAN:

B763 - "BRINLEY" -SLAB ON GRADE-(ELEV. A)

PLAN DATE: 10/26/2021

B764 - "HALL" B764 - "HALL" - SLAB ON GRADE- (ELEV. A) (ELEV. B)
PLAN DATE: 10/26/2021 PLAN DATE: 10/26/2021

#### PROPOSED ELEVATIONS:

LOTS 1, 2, & 3
TOP OF FOUNDATION / SOG = 1023.4
GARAGE FLOOR 1 STEP = 1022.3
REAR = 1022.7

OTS 4 & 5

#### LEGEND:

934.0 **EXISTING ELEVATION** 

934.0 PROPOSED ELEVATION

DIRECTION OF DRAINAGE

Ocs CURB STOP

EOF EMERGENCY OVERFLOW

LFE LOWEST POSSIBLE FLOOR

TOP OF CURB

CABLE TV BOX

TW TOP OF WALL

E ELECTRIC BOX

TC

SCALE

☐ TELEPHONE BOX

O SET CAP IRON MONUMENT 44110

(P) PROPOSED ELEVATION

—— 900 —— PROPOSED CONTOURS

WETLAND MONUMENT

BUILDING PAD

**FEET** 

#### LEGAL DESCRIPTION

LOTS 1, 2, 3, 4, & 5, BLOCK 4, ORONO CROSSINGS, ORONO, MINNESOTA.

#### ADDRESS:

605, 609, 613, 617, & 621 BLOSSOM CIRCLE

#### LOT AREA:

LOT 1- 605 BLOSSOM CIRCLE LOT AREA = 2,019 SQ. FT. OR 0.046 ACRES IMPERVIOUS AREA = 1,375 SQ. FT. (68%)

BUILDING FOOTPRINT AREA = 1,155 SQ. F DRIVEWAY = 192 SQ. FT. COVERED PORCH = 10 SQ. FT. CONCRETE PAD = 18 SQ. FT.

LOT 2 - 609 BLOSSOM CIRCLE LOT AREA = 1,641 SQ. FT. OR 0.038 ACRES IMPERVIOUS AREA = 1,345 SQ. FT. (82%)

BUILDING FOOTPRINT AREA = 1,139 SQ. FT.

DRIVEWAY = 195 SQ. FT.

COVERED PORCH = 11 SQ. FT.

LOT 3 - 613 BLOSSOM CIRCLE LOT AREA = 1,565 SQ. FT. OR 0.035 ACRES IMPERVIOUS AREA = 1,393 SQ. FT. (89%)

BUILDING FOOTPRINT AREA = 1,139 SQ. FT.

DRIVEWAY = 240 SQ. FT.

COVERED PORCH = 14 SQ. FT.

LOT 4 - 617 BLOSSOM CIRCLE LOT AREA = 1,540 SQ. FT. OR 0.035 ACRES IMPERVIOUS AREA = 1,420 SQ. FT. (92%)

BUILDING FOOTPRINT AREA = 1,139 SQ. FT.

DRIVEWAY = 267 SQ. FT.

COVERED PORCH = 14 SQ. FT.

LOT 5 - 621 BLOSSOM CIRCLE

LOT AREA = 1,890 SQ. FT. OR 0.043 ACRES

IMPERVIOUS AREA = 1,461 SQ. FT. (77%)

BUILDING FOOTPRINT AREA = 1,155 SQ. FT.

DRIVEWAY = 275 SQ. FT.


 DRIVEWAY
 = 275 SQ. FT.

 COVERED PORCH
 = 13 SQ. FT.

 CONCRETE PAD
 = 18 SQ. FT.

#### NOTES:

- I. SURVEY PREPARED FROM ALLIANT ENGINEERING, GRADING PLAN DATED NOVEMBER 10, 2021.
- 2. BEARINGS ARE ASSUMED PER PLAT.
- 3. BUILDING DIMENSIONS SHOWN ARE BASED ON FIRST FLOOR ARCHITECTURAL PLANS. ALL DIMENSIONS AND LOCATIONS ARE TO BE VERIFIED IN THE FIELD WITH THE ARCHITECTURAL PLANS.

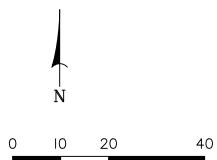

IN

	David Weekley Job #:	Date Staked:	I hereby certify that this survey, plan, or report was prepared by me or
	33-37	6/15/22	under my direct supervision and that I am a duly Licensed Land Surveyor under the laws of the state of Minnesota.  PETER OCCER Print Name Signature JUNE 16, 2022  44110
	Alliant Job #	Checked By:	
	20-0101	PG	
	Field Crew:	Drawn By:	
	CE	TL	Date License Number

ORONO CROSSINGS LOTS 1, 2, 3, 4, & 5, BLOCK 4

ORONO, MINNESOTA



Alliant Engineering, Inc. 733 Marquette Ave, Ste 700 Minneapolis, MN 55402 612.758.3080 MAIN 612.758.3099 FAX www.alliant-inc.com

## City of Orono CERTIFICATE OF OCCUPANCY

This certificate is issued pursuant to the requirements of 1300.0220 of the 2020 Minnesota Building Code verifying that at the time of issuance this structure was in compliance with the various ordinances of the local jurisdiction regulating building construction or use. For the following:

**Building Address:** 617 Blossom Circle Orono, MN 55356

**PIN**: 3311823110170

Lot/Block:

**Zoning District:** 

Permit Number: RPS22-000040
Construction Type: VB Residential

Occupancy Group: IRC-3

Fire Sprinkler:

Owner Name: David Weekley Homes

Owner Address: 12900 Whitewater Drive Suite 180 Minnetonka MN 55343

#### FOR YOUR INFORMATION

For any police, fire or medical emergency - Call: 911

In purchasing a new home, file for your homestead at Hennepin County offices. Register your address for voting, driver's license, and automobile registration. City Water and Sewer is billed monthly.

Septic inspection fees are billed annually. Permits are required for any additions or alterations on your property including garages, decks, patios or other accessory structure.

Special regulations prohibit any excavation, filling, grading, dredging, tree removal, or construction of any kind within 75 feet of any lakeshore or within 25 feet of any wetlands.

Please Note: The property owner is responsible for all Legal/Engineering charges resulting from this project. Due to varying billing cycles, bills may be mailed up to 90 days after the issuance of this Certificate of Occupancy

Cottober 25, 2023

LAURA OAKDEN
ZONING ADMINISTRATOR

October 25, 2023

NICOLE EGAN BUILDING OFFICIAL

Nicole Egan