


55 Landmar K Drive

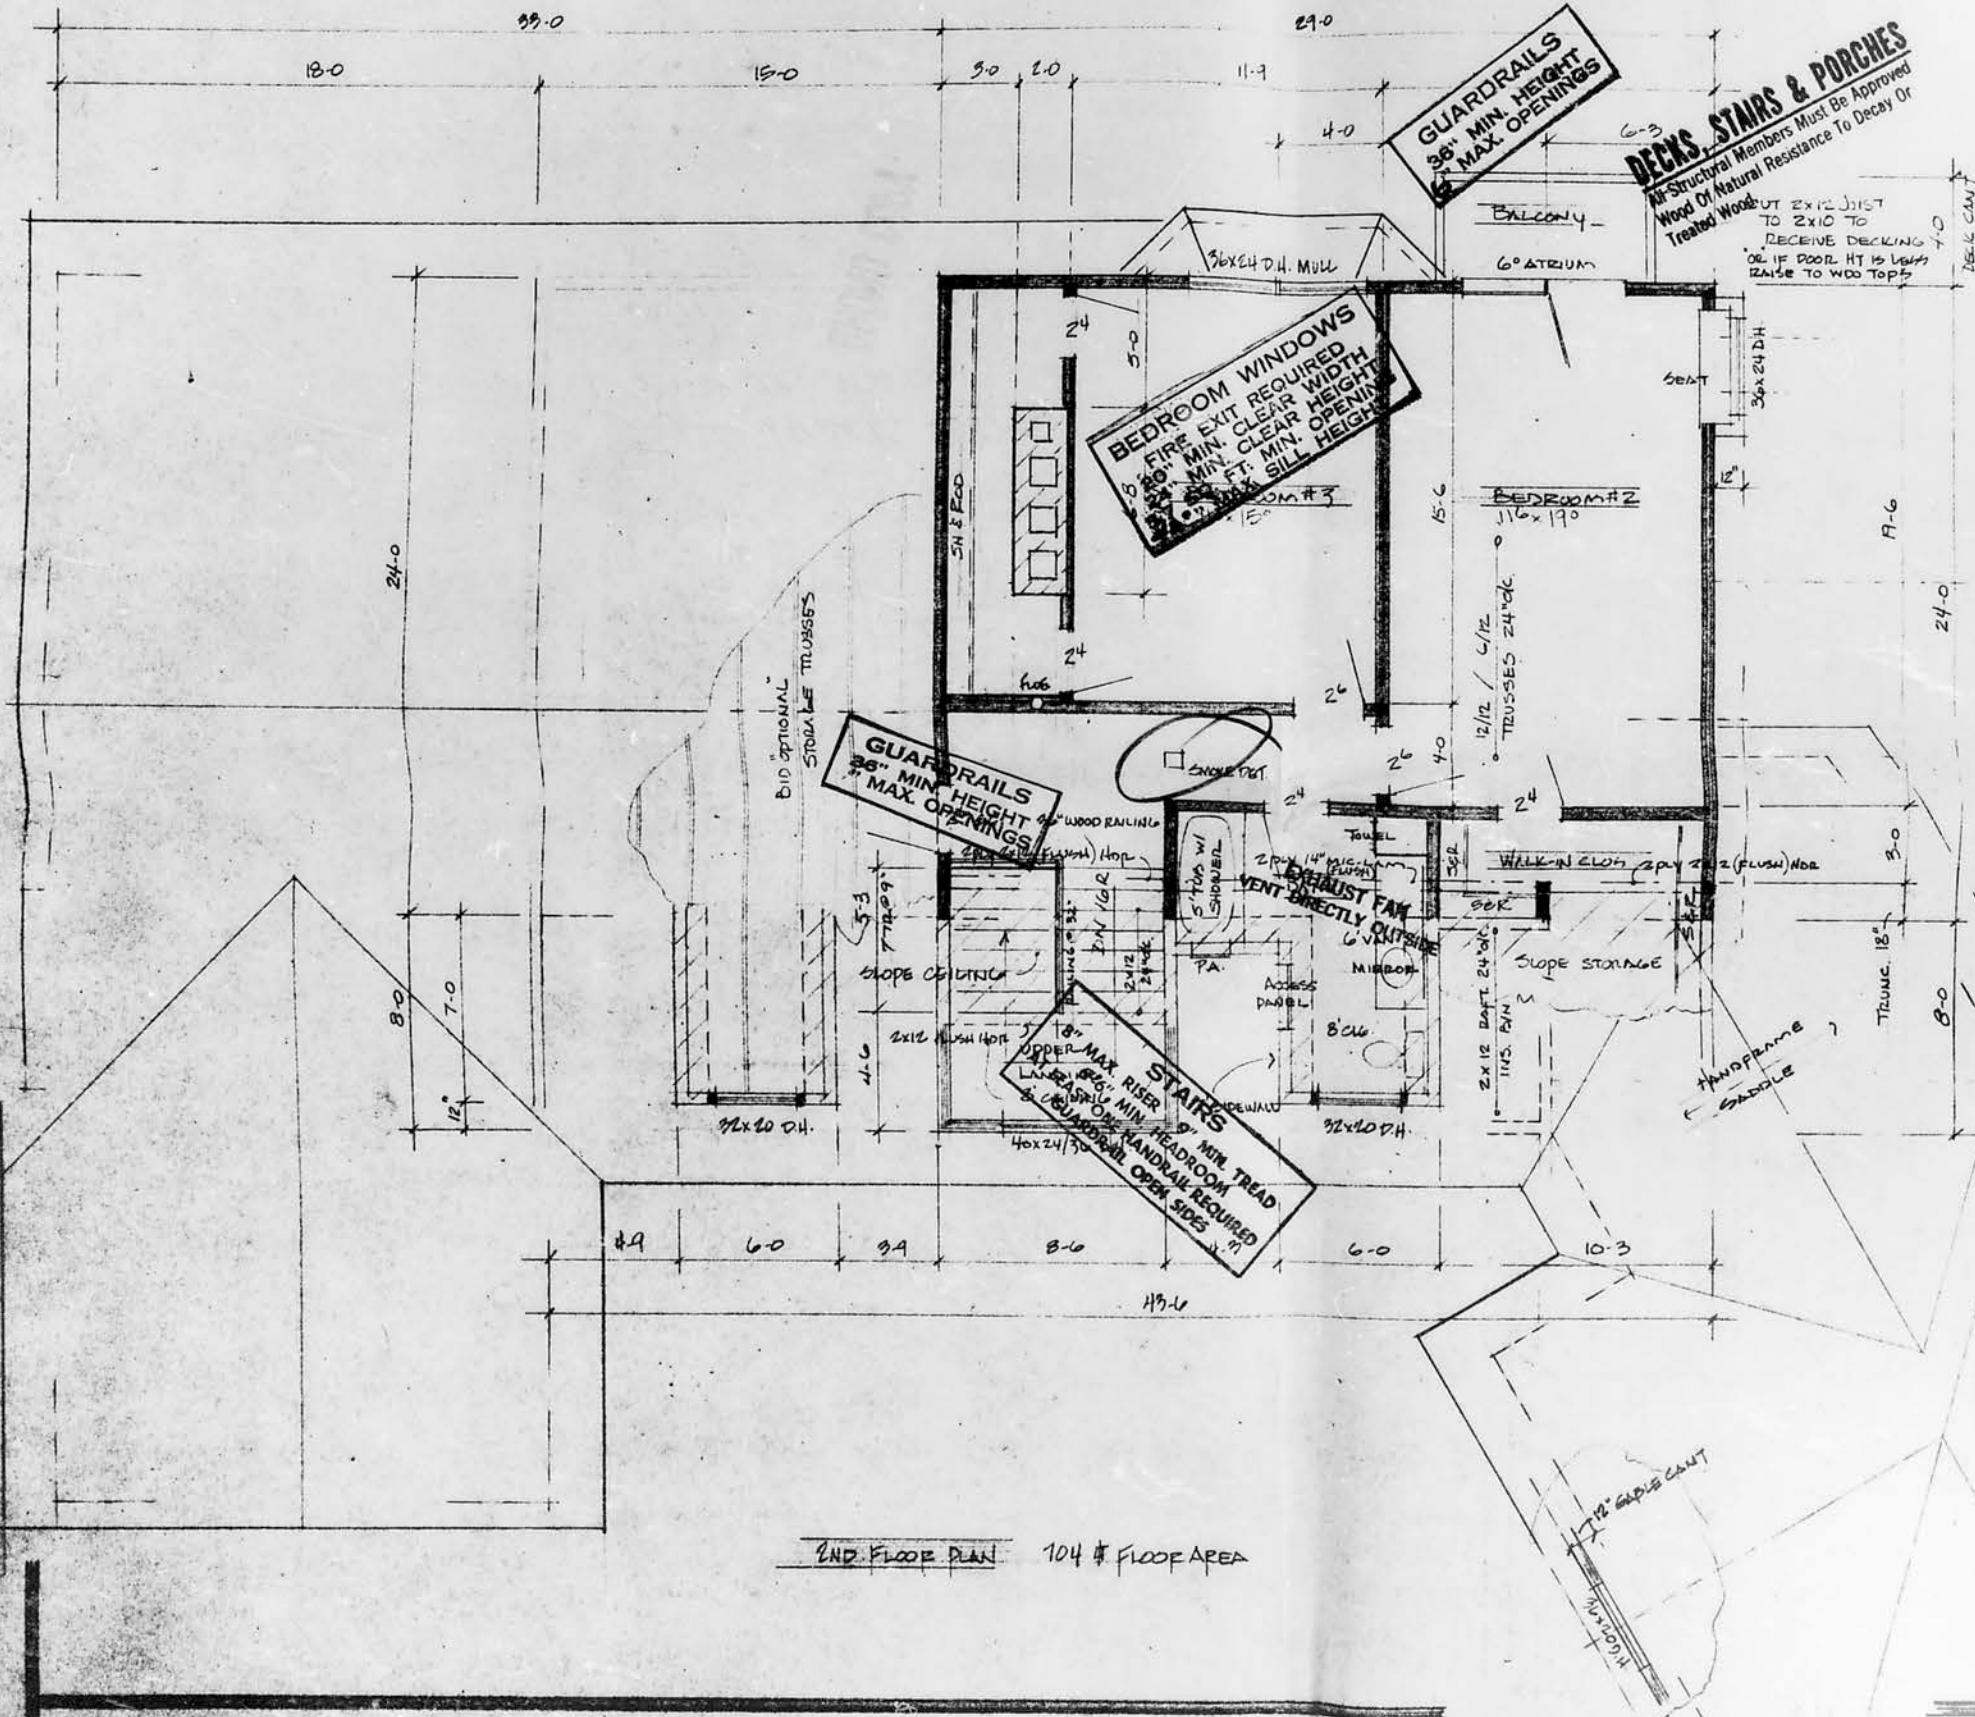

CITY OF ORONO
BUILDING PERMIT PLAN REVIEW

INSPECTOR J. J. Ryan
DATE 2-5-89 PERMIT NO. _____

☐ APPROVED AS SUBMITTED
☒ APPROVED WITH CORRECTIONS AS NOTED
☐ NOT APPROVED — CORRECT & RESUBMIT

These comments are for your information. All work shall be done in full compliance with all applicable building & zoning code requirements including items not specifically noted in this review.

KEEP THIS PLAN SET ON SITE AT ALL TIMES.

2ND FLOOR PLAN 104 # FLOOR AREA

PLAN NO
88.11.18

SHEET
OF 8 8