

WELL OR BORING LOCATION  
County Name  
**HENNEPIN**

MINNESOTA DEPARTMENT OF HEALTH  
**WELL AND BORING SEALING RECORD**  
Minnesota Statutes, chapter 1031

Minnesota Well and Boring  
Sealing No.  
Minnesota Unique Well No.  
or W-series No.  
(Leave blank if not known)

**H 405915**

Township Name <b>ORONO</b>	Township No. <b>118</b>	Range No. <b>23</b>	Section No. <b>36</b>	Fraction (sm. → lg.) <b>NENESE 1/4</b>	Date Sealed <b>11/15/23</b> <b>72</b>	Date Well or Boring Constructed
-------------------------------	----------------------------	------------------------	--------------------------	-------------------------------------------	---------------------------------------------	---------------------------------

GPS LOCATION – decimal degrees (to four decimal places)  
Latitude \_\_\_\_\_ Longitude \_\_\_\_\_



Depth at Time of Sealing \_\_\_\_\_ ft. Original Depth \_\_\_\_\_ ft.

Numerical Street Address or Fire Number and City of Well or Boring Location  
**135 CHEVY CHASE DR., WAYZATA, MN 55391**

WELL/BORING  
☒ Single Aquifer ☐ Multiaquifer  
☒ Water-Supply Well ☐ Env. Well  
☐ Temp. Boring ☐ Other \_\_\_\_\_

STATIC WATER LEVEL  
☒ Measured Date Measured **11/15/23** ☐ Estimated  
**70** ft. ☒ below ☐ above land surface

Show exact location of well or boring in section grid with "X."

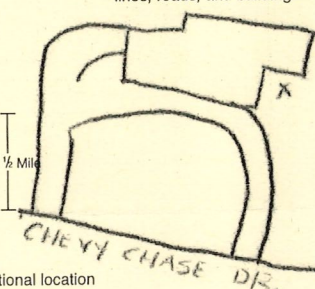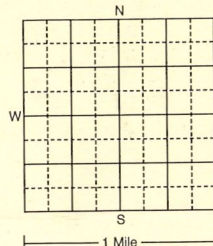

CASING TYPE(S)  
☒ Steel ☐ Plastic ☐ Tile ☐ Other \_\_\_\_\_

WELLHEAD COMPLETION  
Outside: ☒ Pitless Adapter/Unit ☐ At Grade ☐ Well Pit ☐ Other \_\_\_\_\_  
Inside: ☐ Basement Offset ☐ Well House ☐ Well Pit ☐ Buried ☐ Other \_\_\_\_\_

CASING(S)  
Diameter **4** in. from **1** to **68** ft. Set in oversize hole? ☐ Yes ☐ No Annular space initially grouted? ☐ Yes ☐ No ☒ Unknown  
\_\_\_\_\_ in. from \_\_\_\_\_ to \_\_\_\_\_ ft. ☐ Yes ☐ No ☐ Yes ☐ No ☐ Unknown  
\_\_\_\_\_ in. from \_\_\_\_\_ to \_\_\_\_\_ ft. ☐ Yes ☐ No ☐ Yes ☐ No ☐ Unknown

SCREEN/OPEN HOLE  
Screen from **68** to **72** ft. Open Hole from \_\_\_\_\_ to \_\_\_\_\_ ft.

OBSTRUCTIONS  
☒ Rods/Drop Pipe ☐ Check Valve(s) ☐ Debris ☐ Fill ☐ No Obstruction  
Type of Obstructions (Describe) **DROP PIPE**  
Obstructions removed? ☒ Yes ☐ No Describe \_\_\_\_\_

PUMP  
☐ Not Present ☒ Present, Removed Prior to Sealing ☐ Other \_\_\_\_\_  
Type **SUBMERSIBLE**

METHOD USED TO SEAL ANNULAR SPACE BETWEEN 2 CASINGS, OR CASING AND BORE HOLE  
☒ No Annular Space Exists ☐ Annular Space Grouted with Tremie Pipe ☐ Casing Perforation/Removal  
Casing Diameter \_\_\_\_\_ in. from \_\_\_\_\_ to \_\_\_\_\_ ft. ☐ Perforated ☐ Removed  
\_\_\_\_\_ in. from \_\_\_\_\_ to \_\_\_\_\_ ft. ☐ Perforated ☐ Removed  
Type of Perforator \_\_\_\_\_

VARIANCE  
Was a variance granted from the MDH for this well? ☐ Yes ☒ No TN# \_\_\_\_\_

GROUTING MATERIAL(S)  
Grouting Material **NEAT CEMENT** from **1** to **72** ft. \_\_\_\_\_ yards **6** bags  
\_\_\_\_\_ from \_\_\_\_\_ to \_\_\_\_\_ ft. \_\_\_\_\_ yards \_\_\_\_\_ bags  
\_\_\_\_\_ from \_\_\_\_\_ to \_\_\_\_\_ ft. \_\_\_\_\_ yards \_\_\_\_\_ bags

OTHER WELLS AND BORINGS  
Other unsealed and unused well or boring on property? ☐ Yes ☒ No How many? \_\_\_\_\_

LICENSED OR REGISTERED CONTRACTOR CERTIFICATION  
This well or boring was sealed in accordance with Minnesota Rules, Chapter 4725. The information contained in this report is true to the best of my knowledge.

**DON STODOLA WELL DRILLING CO., INC. 1691**  
Licensee Business Name \_\_\_\_\_ License or Registration No. \_\_\_\_\_  
**558 11/15/23**  
Certified Representative Signature \_\_\_\_\_ Certified Rep. No. \_\_\_\_\_ Date \_\_\_\_\_

**JERRY BARR**  
Name of Person Sealing Well or Boring

REMARKS, SOURCE OF DATA, DIFFICULTIES IN SEALING

LOCAL COPY **H 405915**