

CONSTRUCTION PLANS FOR



THE MARSH AT LAFAYETTE

SANITARY SEWER, WATERMAIN,

STORM SEWER AND STREET CONSTRUCTION

CITY OF ORONO, MINNESOTA

FEBRUARY, 1991

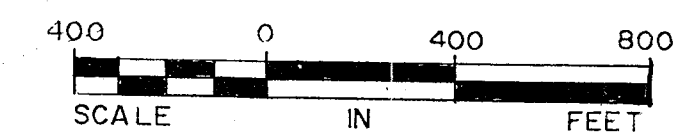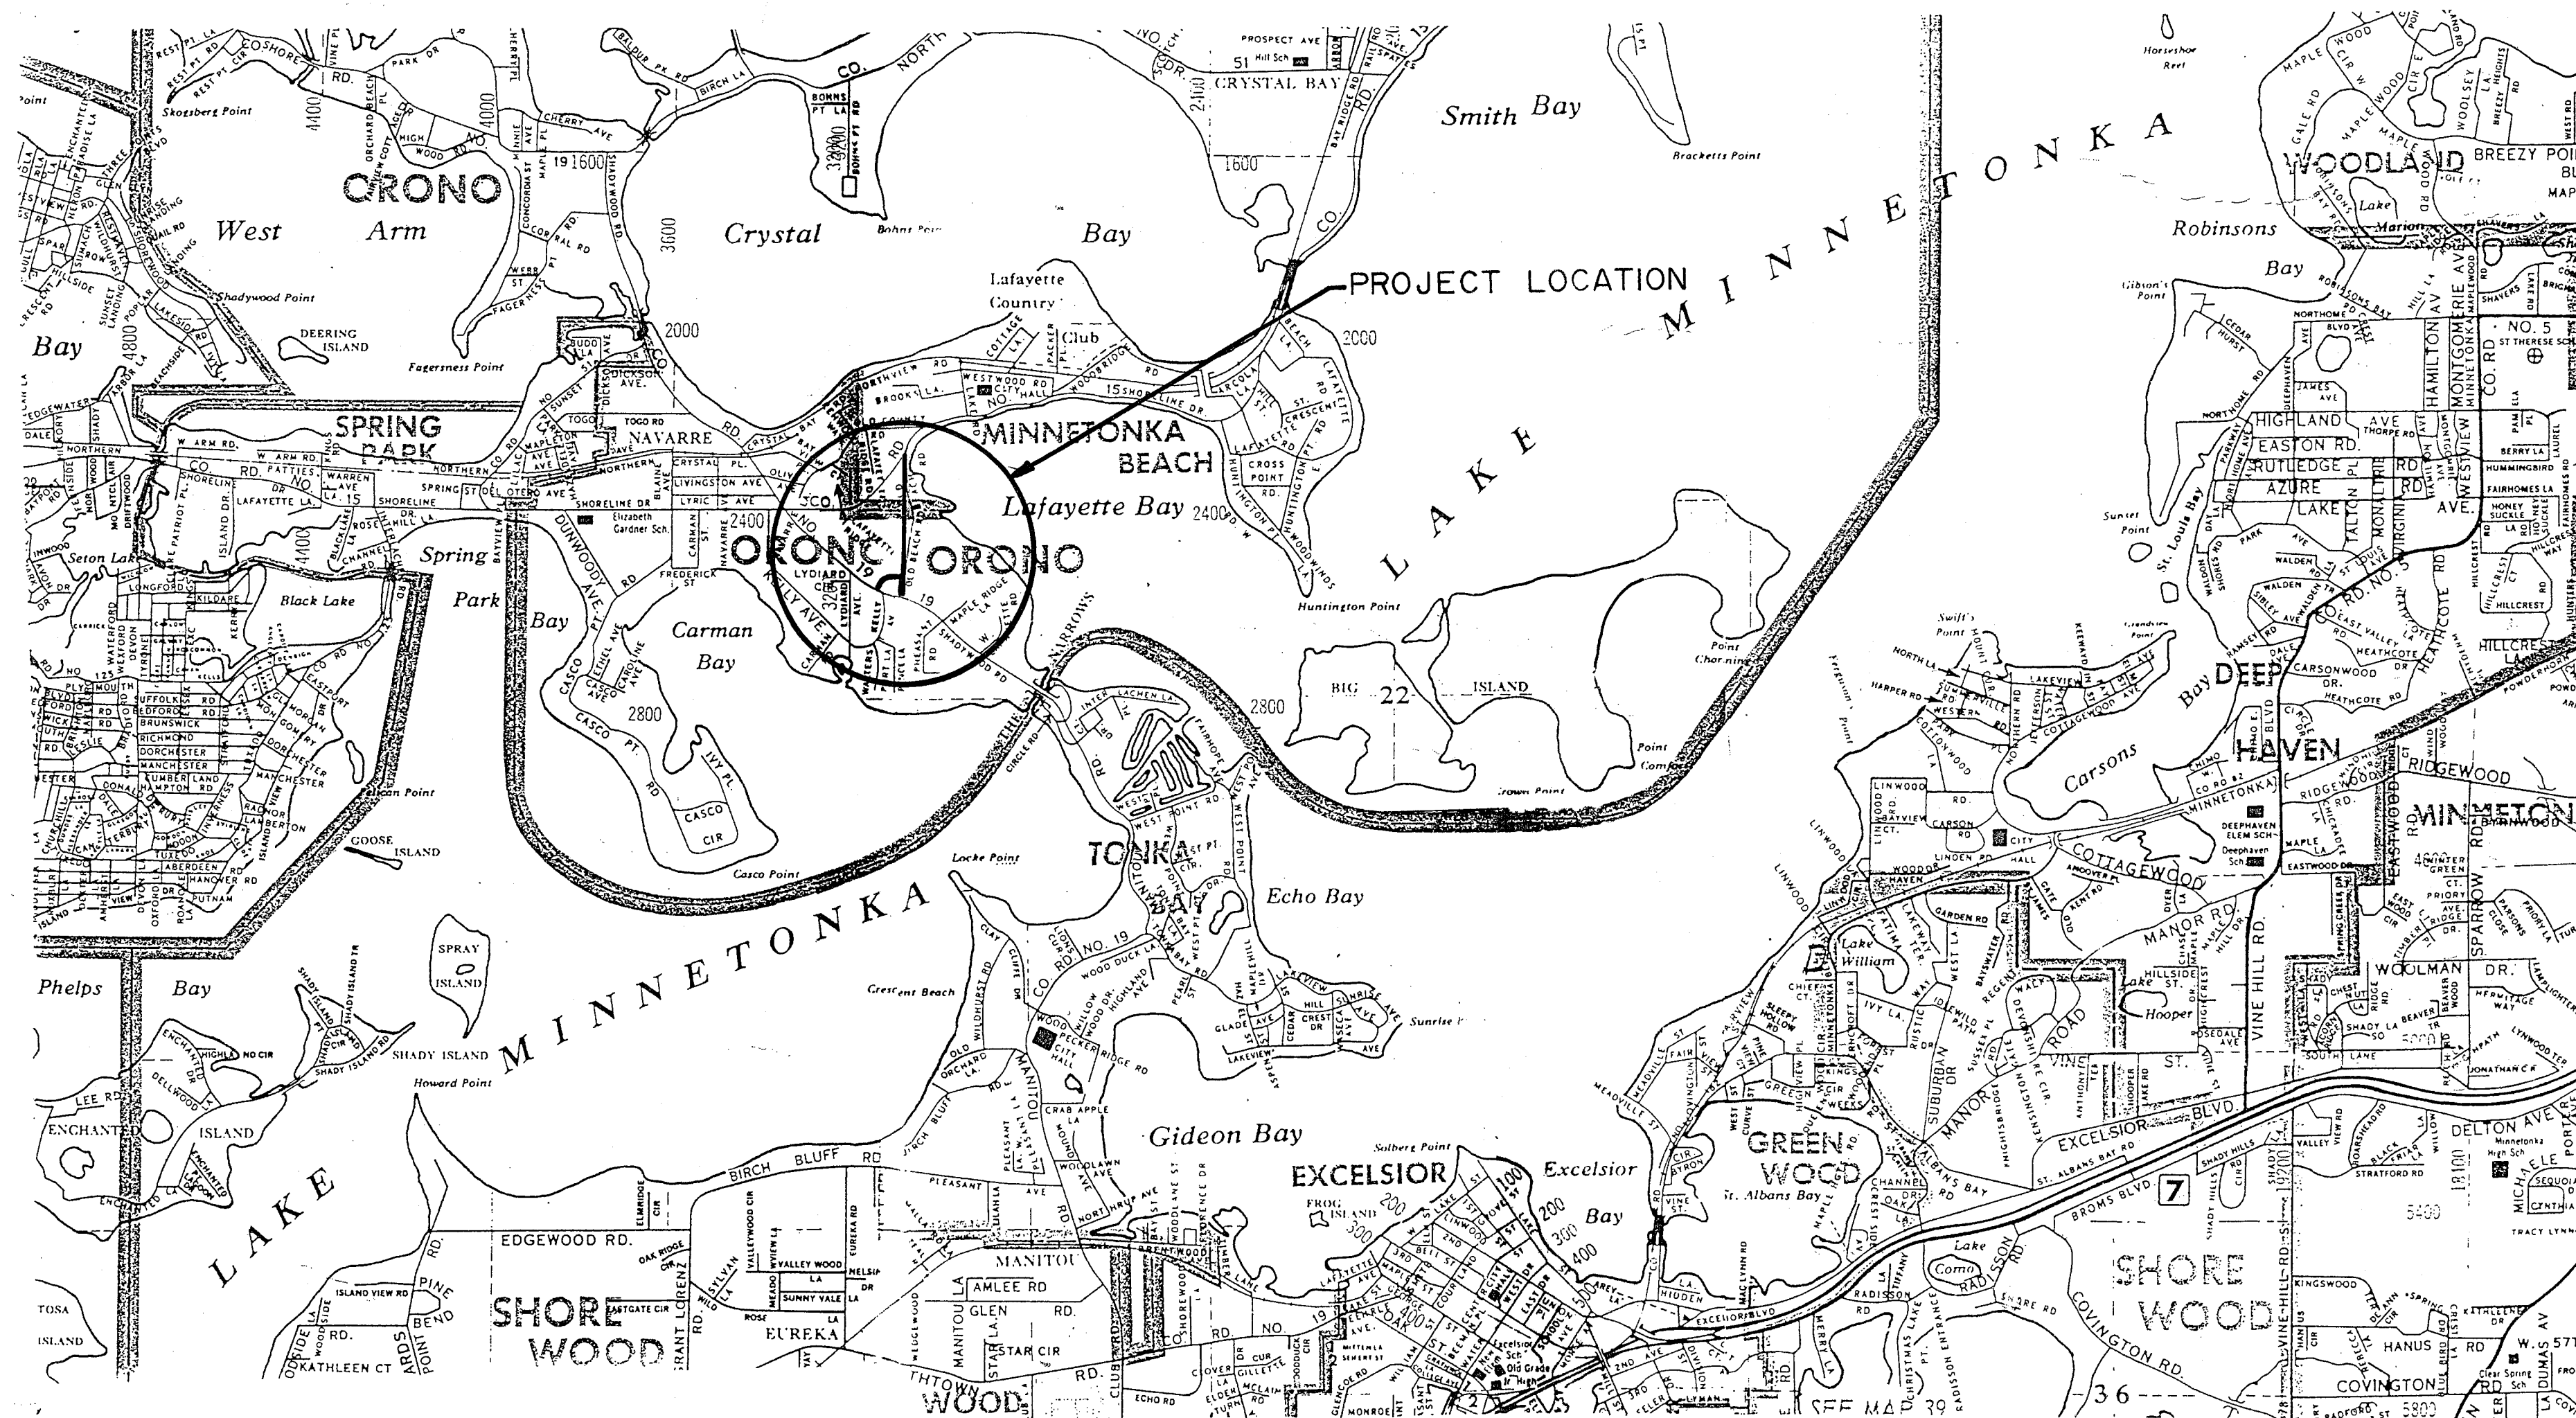

LEGEND

- EROSION CONTROL
- EXISTING CONTOURS
- PROPOSED CONTOURS

RECORD PLAN 2-28-92

NOTE: All hydrant bench marks are to top of nut of hydrant.

INDEX

NOTE: All ties and distances are to center of surface structure.


SHEET NO.

- 1
- 2
- 3

TITLE

TITLE SHEET
SANITARY SEWER
CO. RD 19 AND OLD BEACH ROAD
SANITARY SEWER & WATERMAIN
OLD BEACH ROAD

NOTE: All sewer services are located 3' downstream of water services if sewer and water are in the same trench (unless otherwise noted).

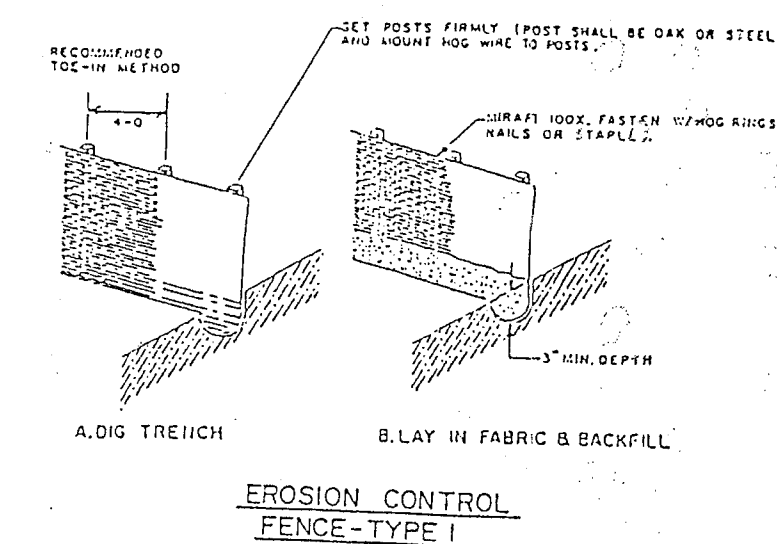

PREPARED BY:
WILLIAM R. ENGELHARDT ASSOCIATES, INC.
CONSULTING ENGINEERS
1107 HAZELTINE BLVD., SUITE 480
CHASKA, MINNESOTA 55318
(612) 448-8838

I HEREBY CERTIFY THAT THIS PLAN, SPECIFICATION OR REPORT WAS PREPARED BY ME OR UNDER MY DIRECT SUPERVISION AND THAT I AM A DULY REGISTERED PROFESSIONAL ENGINEER UNDER THE LAWS OF THE STATE OF MINNESOTA.