
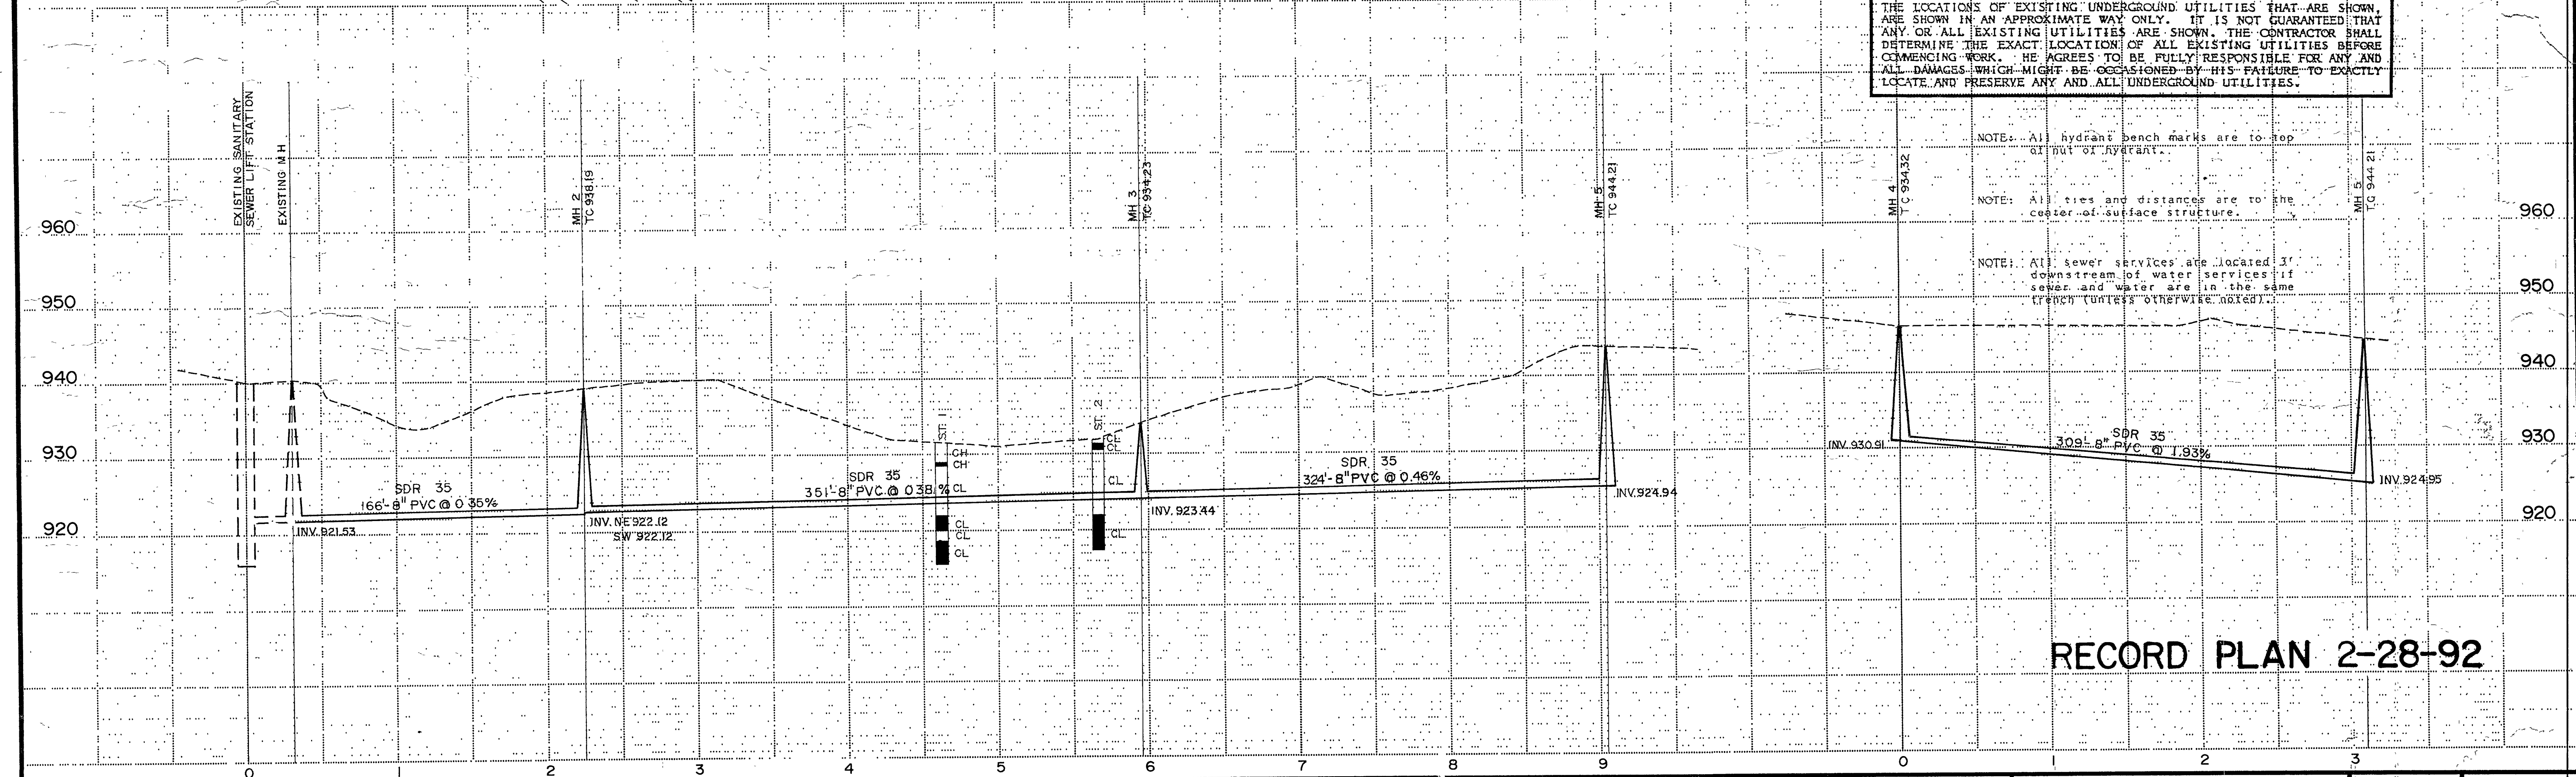
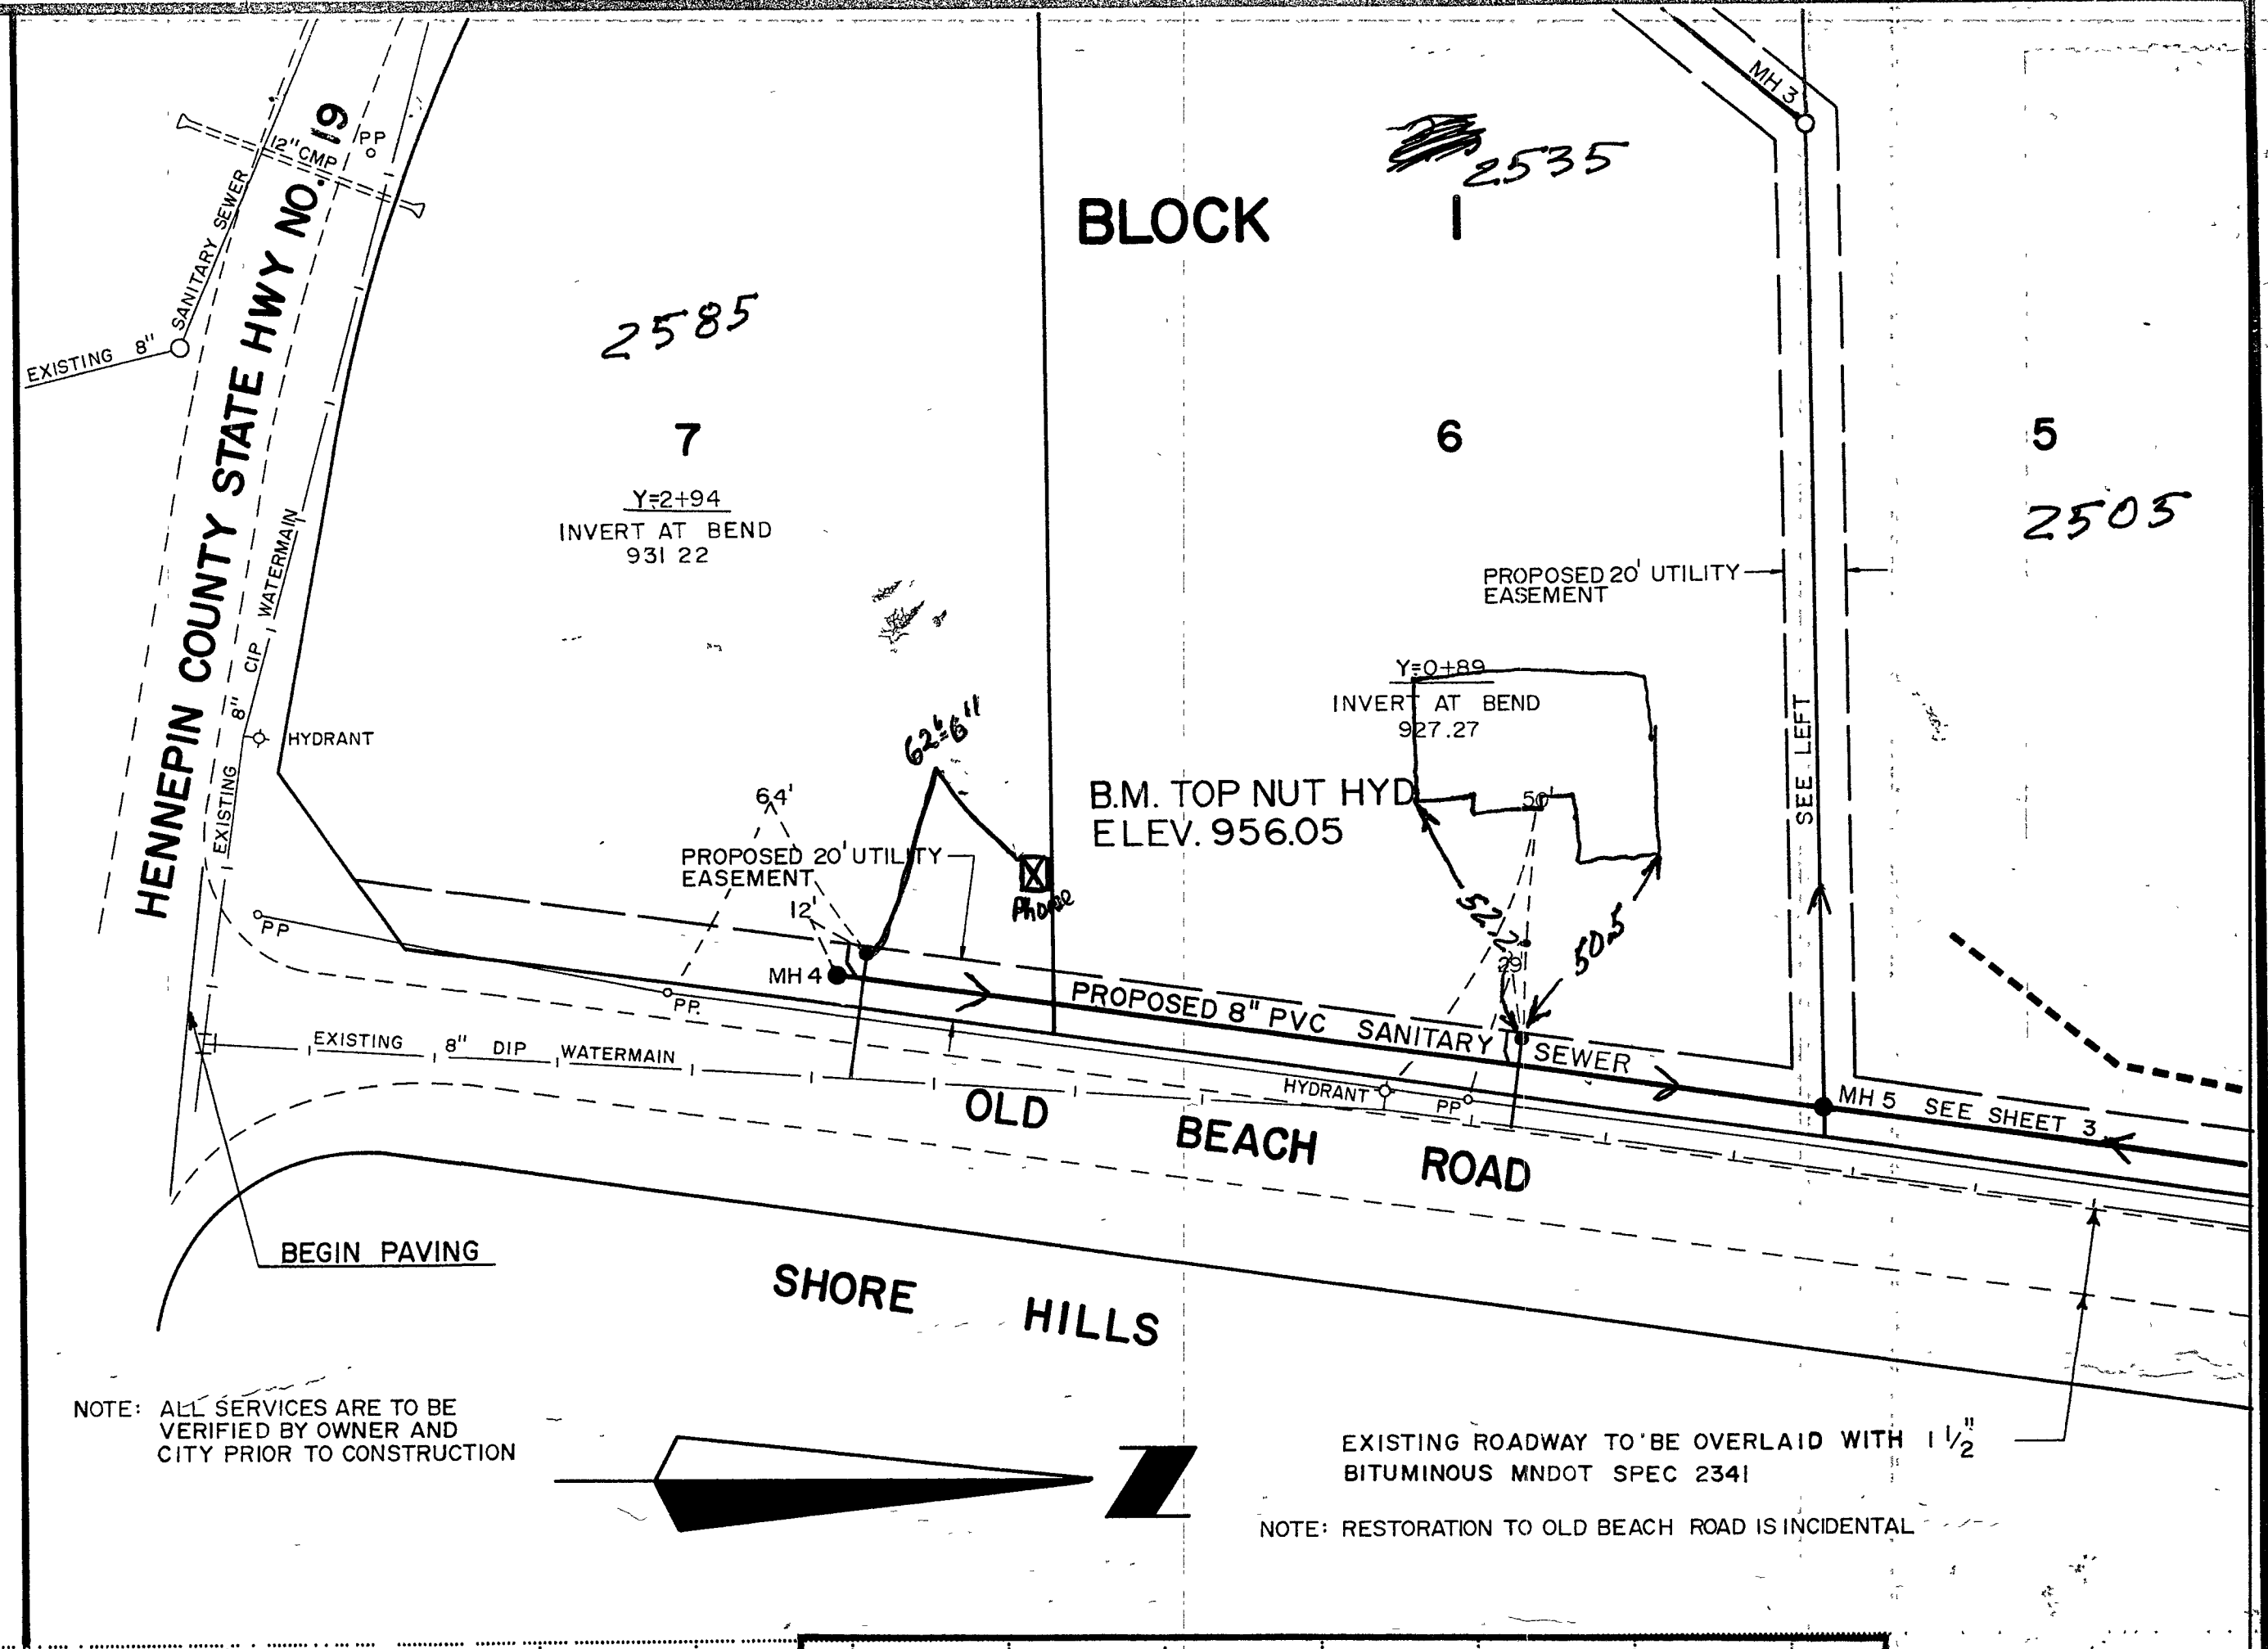


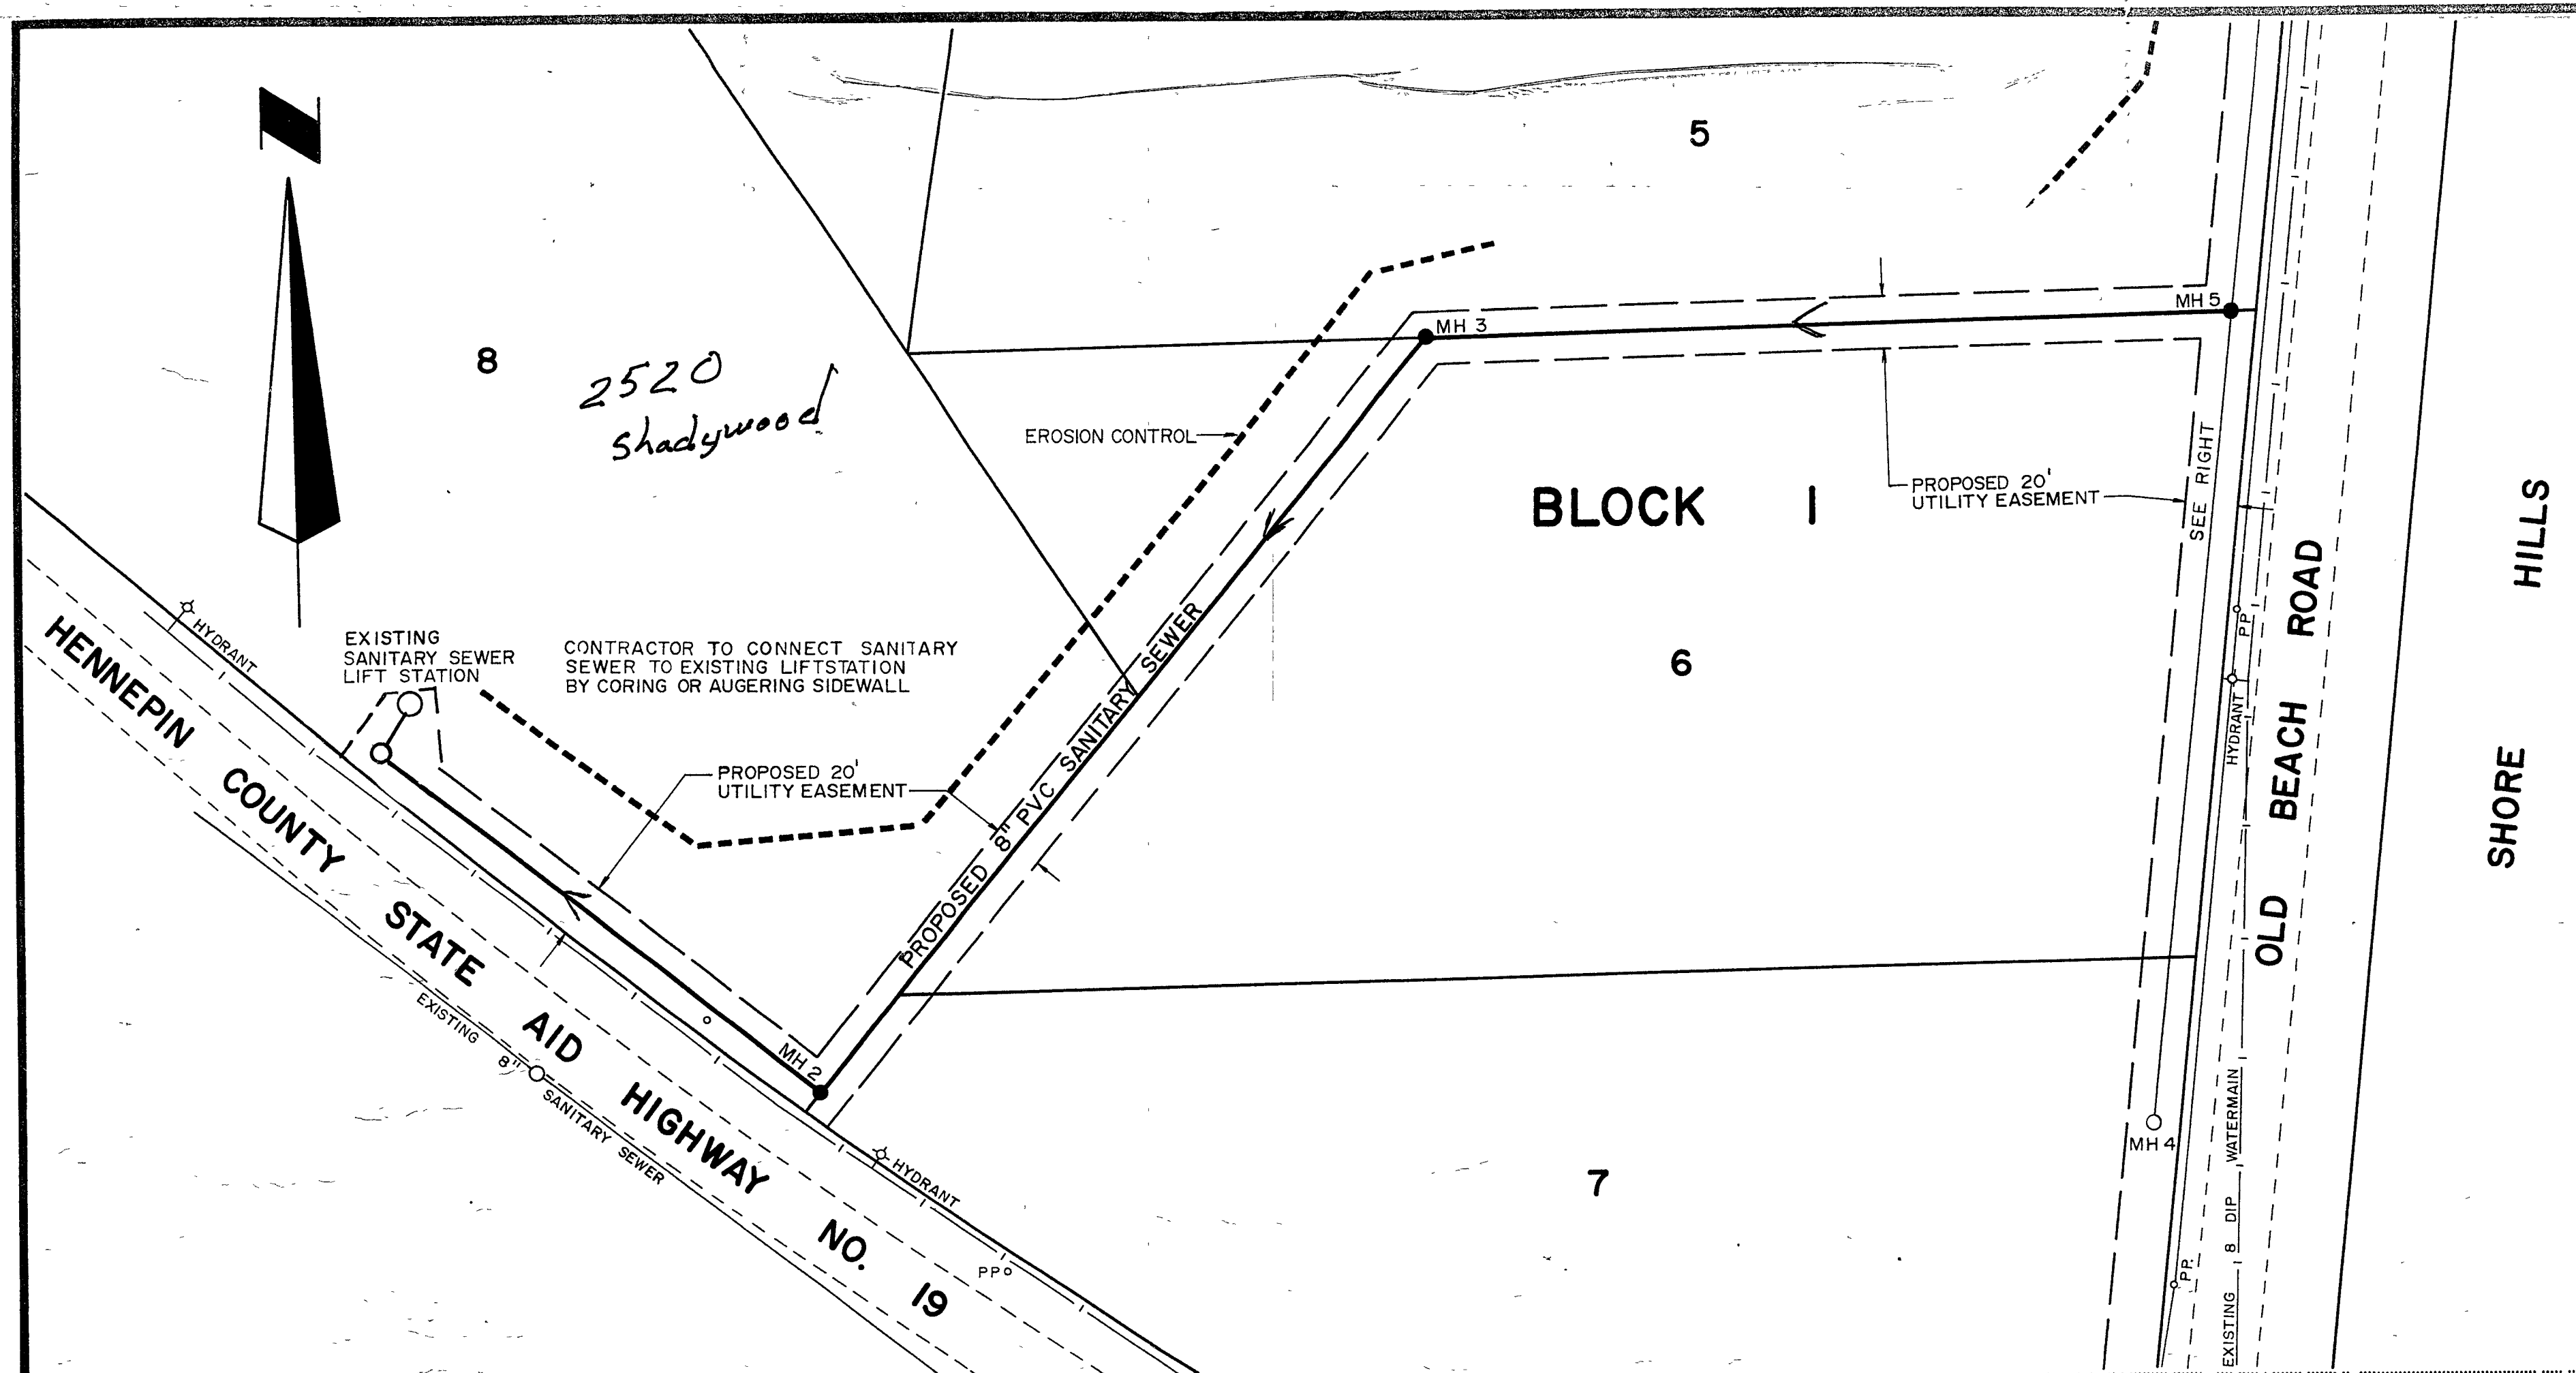

THE LOCATIONS OF EXISTING UNDERGROUND UTILITIES THAT ARE SHOWN ARE SHOWN IN AN APPROXIMATE WAY ONLY. IT IS NOT GUARANTEED THAT ANY OR ALL EXISTING UTILITIES ARE SHOWN. THE CONTRACTOR SHALL DETERMINE THE EXACT LOCATION OF ALL EXISTING UTILITIES BEFORE COMMENCING WORK. HE AGREES TO BE FULLY RESPONSIBLE FOR ANY AND ALL DAMAGES WHICH MIGHT BE OCCASIONED BY HIS FAILURE TO EXACTLY LOCATE AND PRESERVE ANY AND ALL UNDERGROUND UTILITIES.

NOTE: All hydrant bench marks are to top of nut of hydrant.
NOTE: All ties and distances are to the center of surface structure.
NOTE: All sewer services are located 3' downstream of water services if sewer and water are in the same trench (unless otherwise noted).

RECORD PLAN 2-28-92

ENGINEER	CERTIFICATION	DESIGN	REVISIONS	OWNER	PROJECT	SHEET TITLE	DATE	PROJECT NO.
WILLIAM R. ENGELHARDT ASSOCIATES, INC. CONSULTING ENGINEERS 1107 HAZELTINE BOULEVARD • SUITE 480 CHASKA, MINNESOTA 55318	I HEREBY CERTIFY THAT THIS PLAN, SPECIFICATION OR REPORT WAS PREPARED BY ME OR UNDER MY DIRECT SUPERVISION AND THAT I AM A DULY REGISTERED PROFESSIONAL ENGINEER UNDER THE LAWS OF THE STATE OF MINNESOTA DATE 2/1/91 REGISTRATION NO. 233	DESIGNED BY DRAWN BY CHECKED BY	DATE DESCRIPTION	EDGAR W. BLANCH JR.	THE MARSH AT LAFAYETTE ORONO, MINNESOTA	SANITARY SEWER CO. RD 19 AND OLD BEACH ROAD	FEBRUARY, 1991 SCALE 1"=50' PLAN 1"=50' PROFILE 1"=10' VERT. 1"=50'	90-149-09 SHEET NO. 2 OF 3