
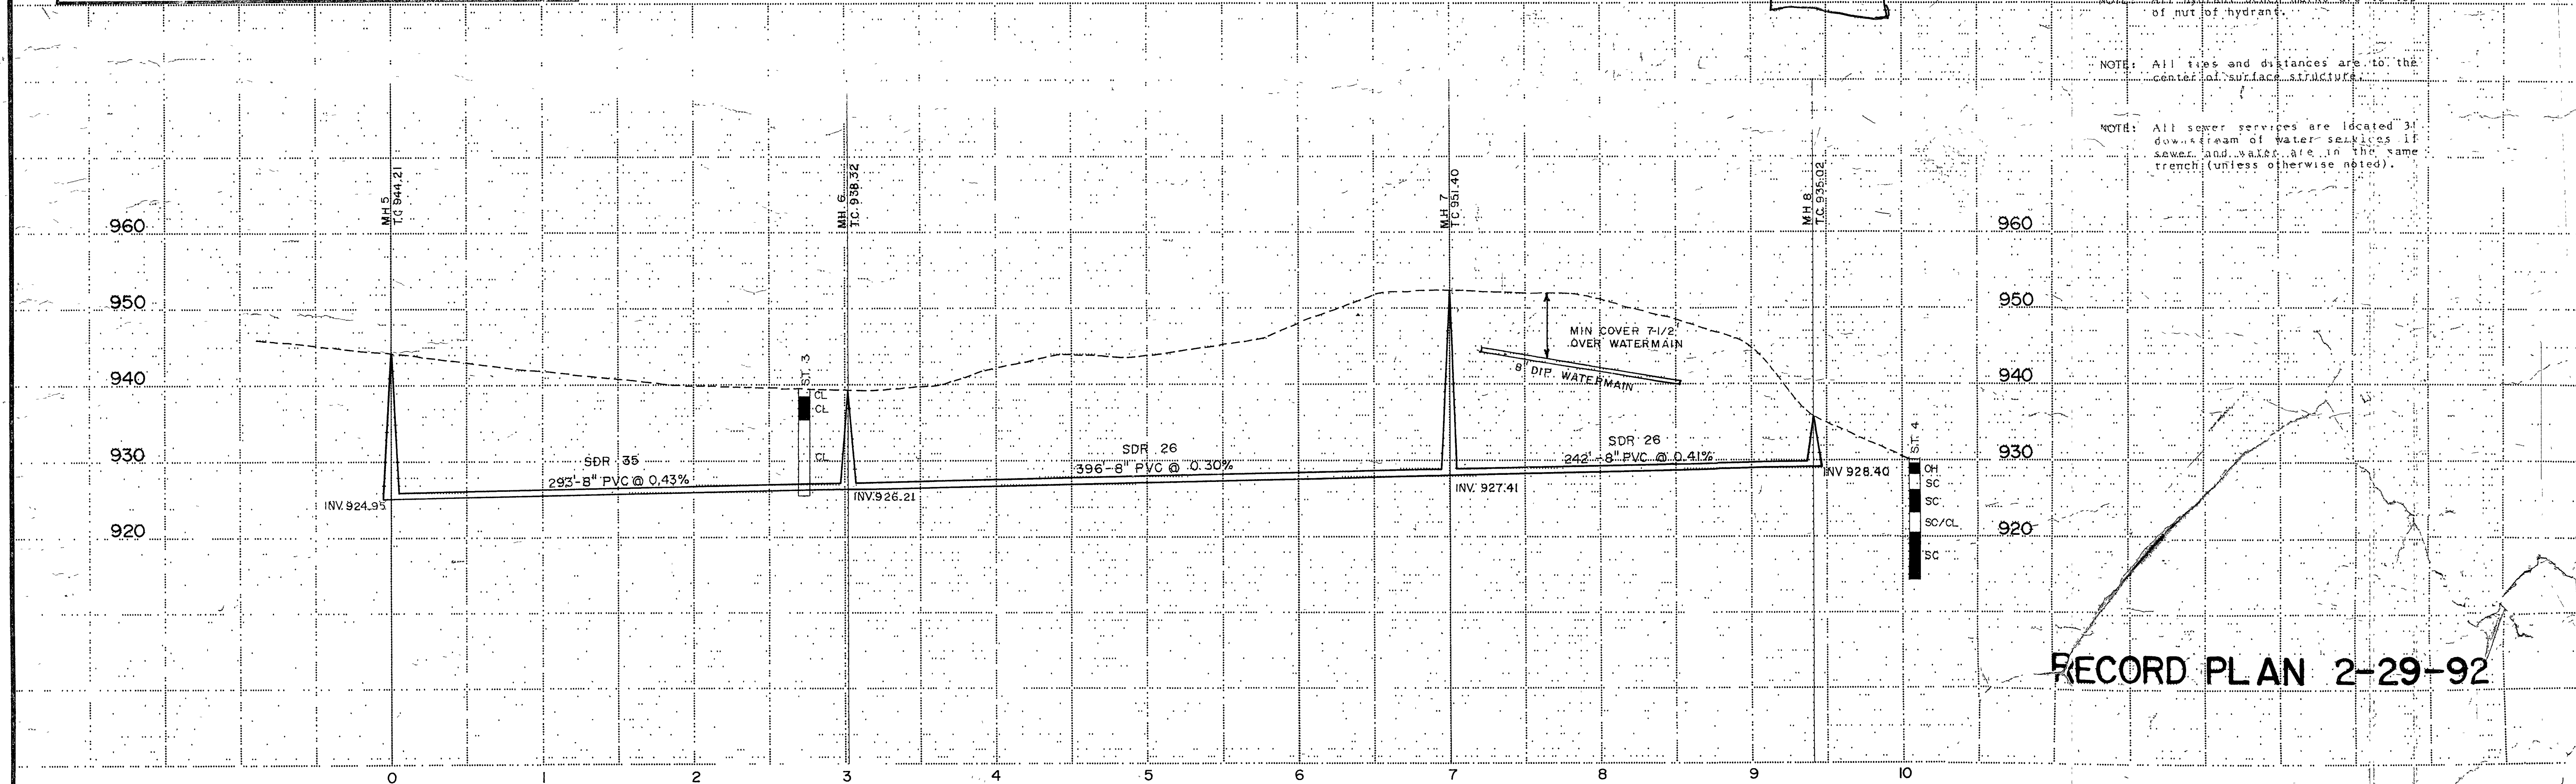


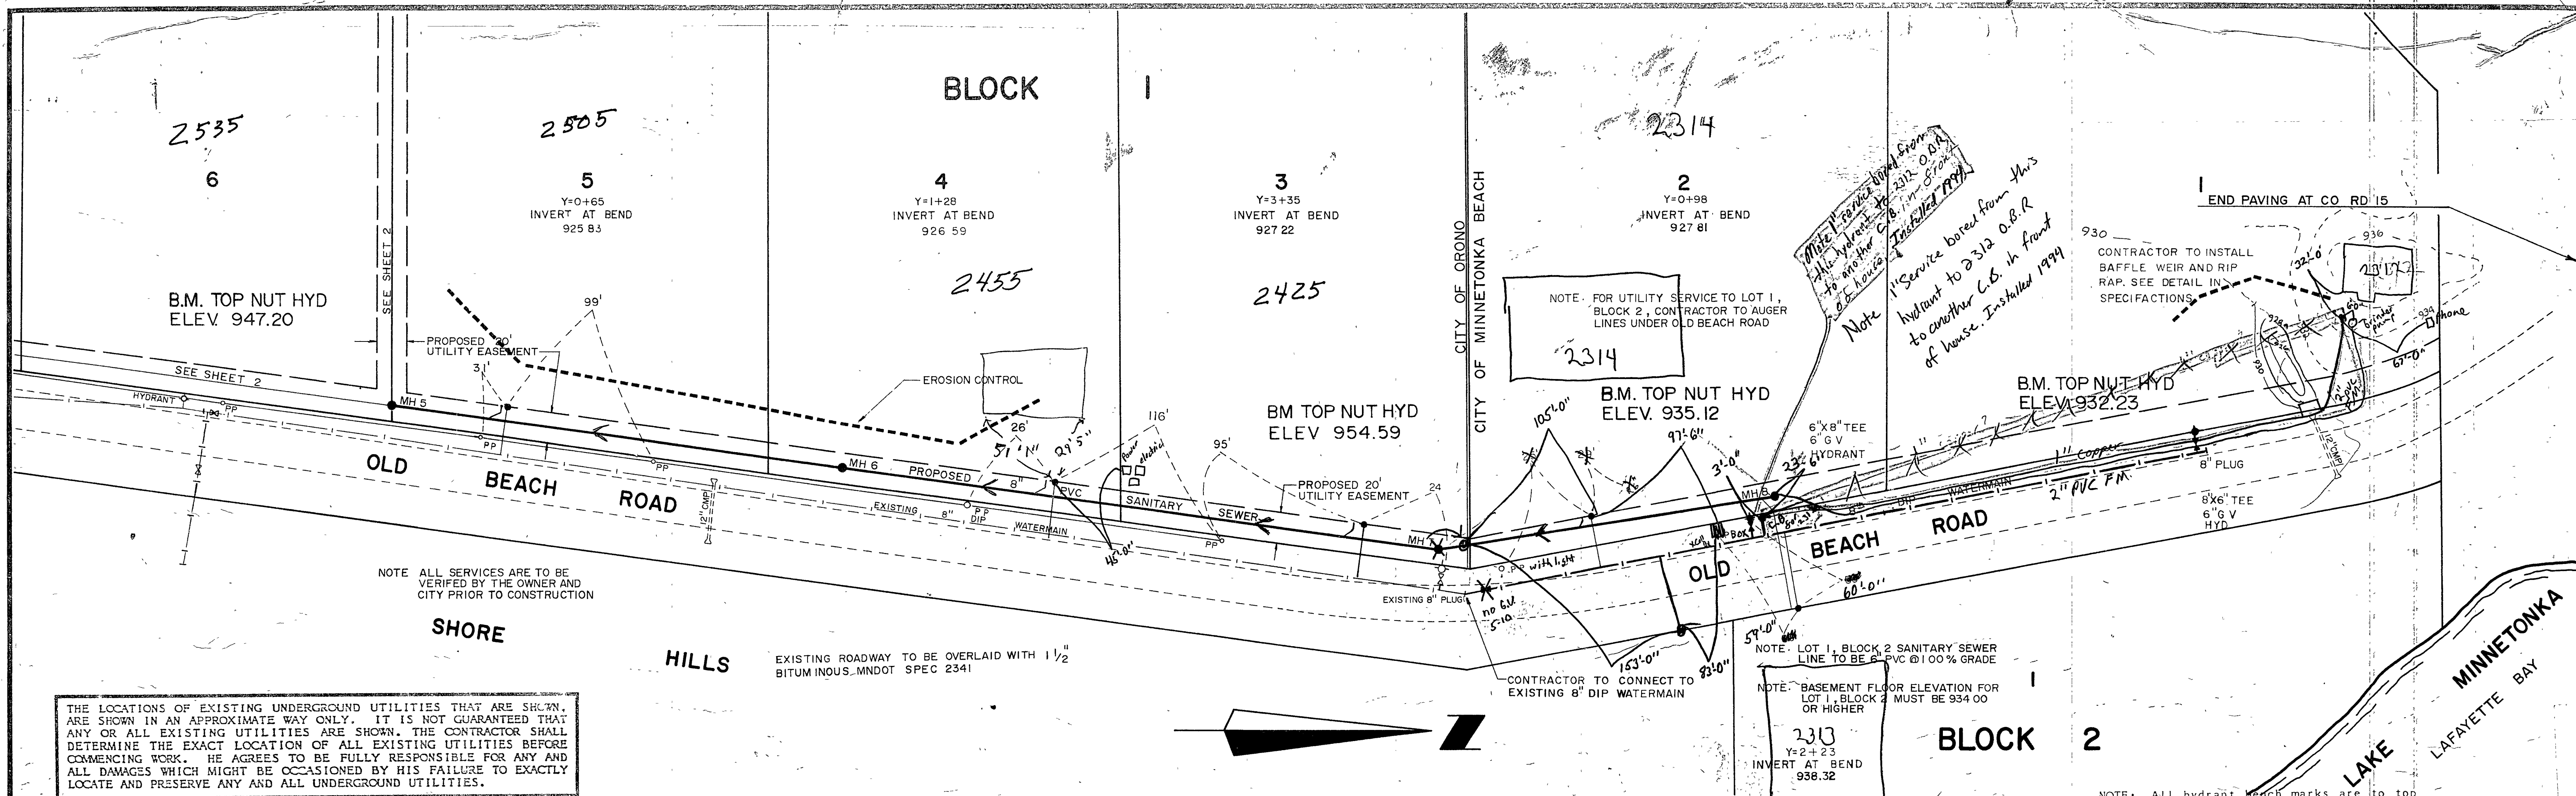

RECORD PLAN 2-29-92

ENGINEER	CERTIFICATION	DESIGN	REVISIONS	OWNER	PROJECT	SHEET TITLE	DATE	PROJECT NO.
WILLIAM R. ENGELHARDT ASSOCIATES, INC. CONSULTING ENGINEERS 1107 HAZELTINE BOULEVARD • SUITE 480 CHASKA, MINNESOTA 55318	I HEREBY CERTIFY THAT THIS PLAN, SPECIFICATION OR REPORT WAS PREPARED BY ME OR UNDER MY DIRECT SUPERVISION AND THAT I AM A DULY REGISTERED PROFESSIONAL ENGINEER UNDER THE LAWS OF THE STATE OF MINNESOTA DATE _____ REGISTRATION NO. _____	DESIGNED BY	DATE	DESCRIPTION	EDGAR W. BLANCH JR. THE MARSH AT LAFAYETTE ORONO, MINNESOTA	SANITARY SEWER AND WATERMAIN OLD BEACH ROAD	FEBRUARY 1991 SCALE PLAN: 1"=50' PROFILE: 1"=10' VERT: 1"=50' HORIZ: 1"=50'	90-149-09 SHEET NO 3 OF 3
		DRAWN BY						
		CHECKED BY						