


SUBJECT 200M GAL DE, 36"Ø, 108.62' LCL
DATE 6-1-71
CHECKED BY P.W.D.

Dwa: 1 Enni
PAGE NO. 26
DATE

BEING LOCATED WEAPNS.

MODIFICATIONS TO ANCHORS AND BASE PLATES FOR CONTRACT # 20603 DUE TO ANCHORS

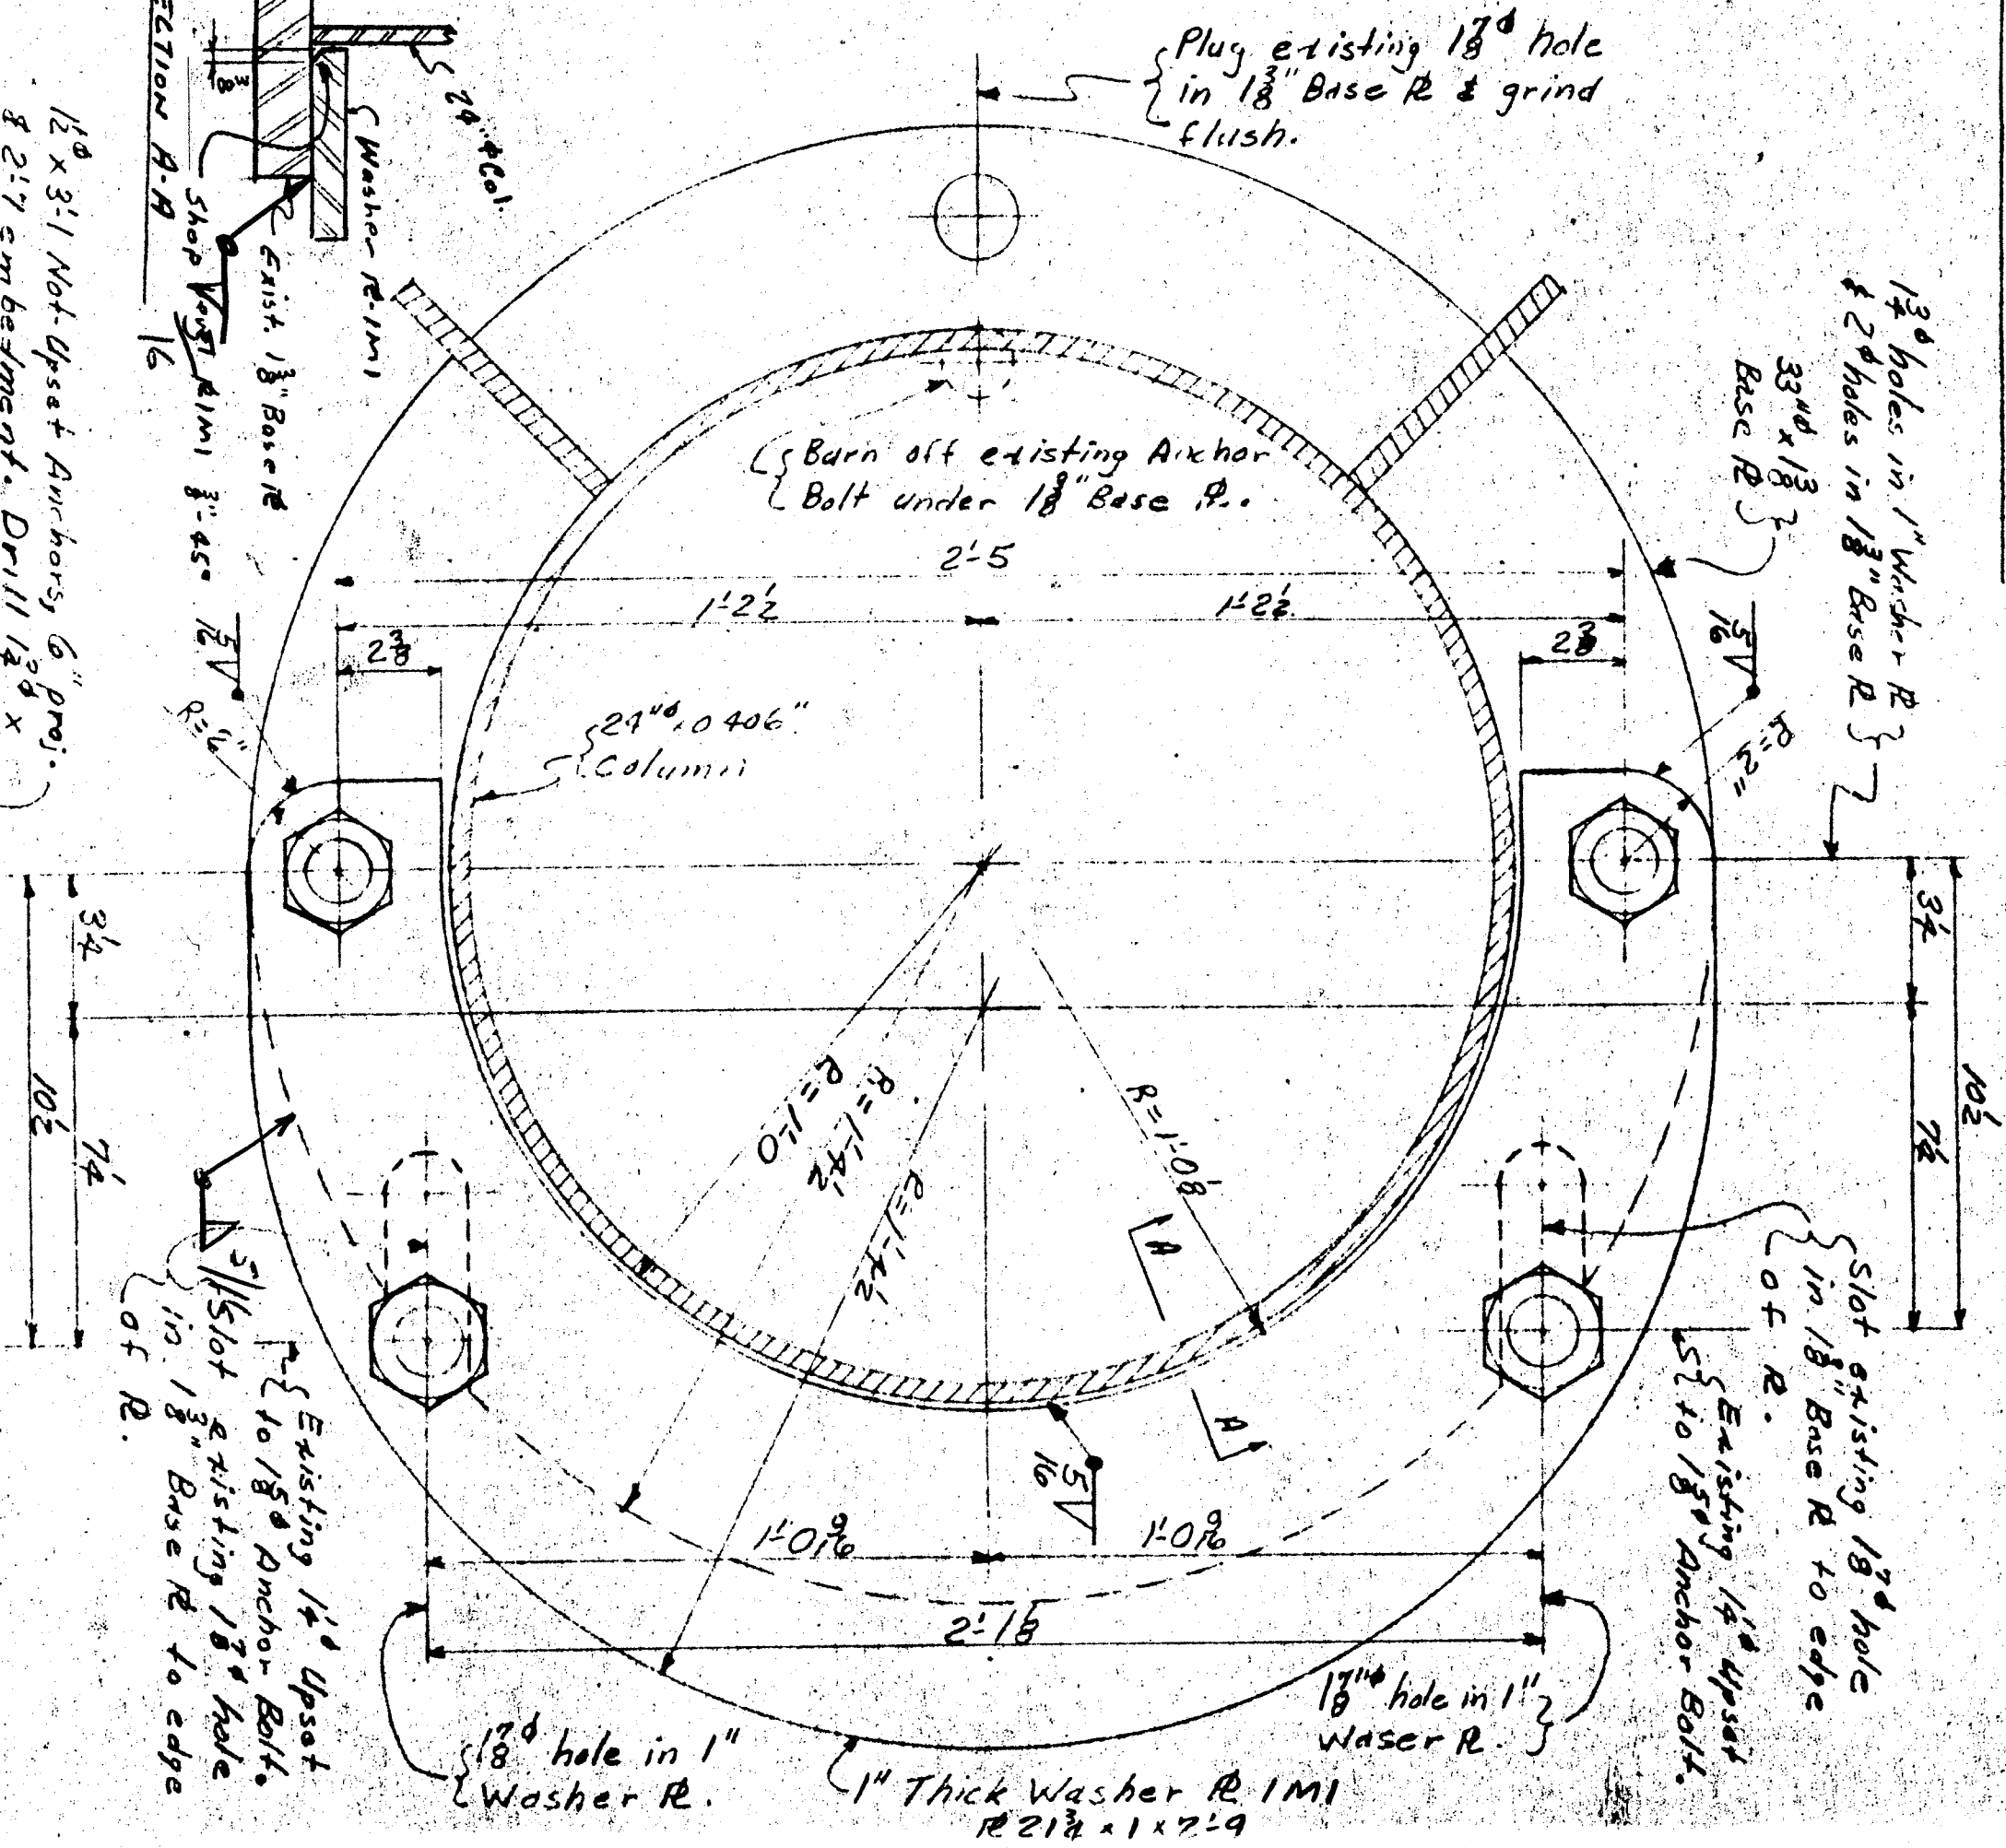

12 x 3'-1 Not-Upset Anchors, 6" proj.
@ 2'-7 embedment. Drill 12" x
2'7 holes in concrete. Holes to
be as nearly vertical as possible.
Bond Anchors in holes with
Colma-Dur LV epoxy adhesive
as made by Sika Chemical Corp.
or approved equal. (Furn. by Sear) -

$R + 0 \notin NE \text{ Column} = 27'93''$
 $R + 0 \notin SE \& SW \text{ Columns} = 27'94''$
 $R + 0 \notin NW \text{ Column} = 27'104''$

[illegible]

APPROVED AS CORRECTED
SUBJECT TO CONTRACT REQUIREMENTS

Dues #1 Fine