


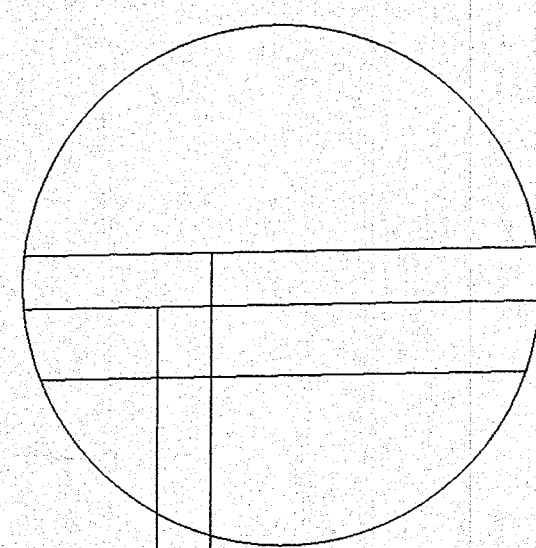


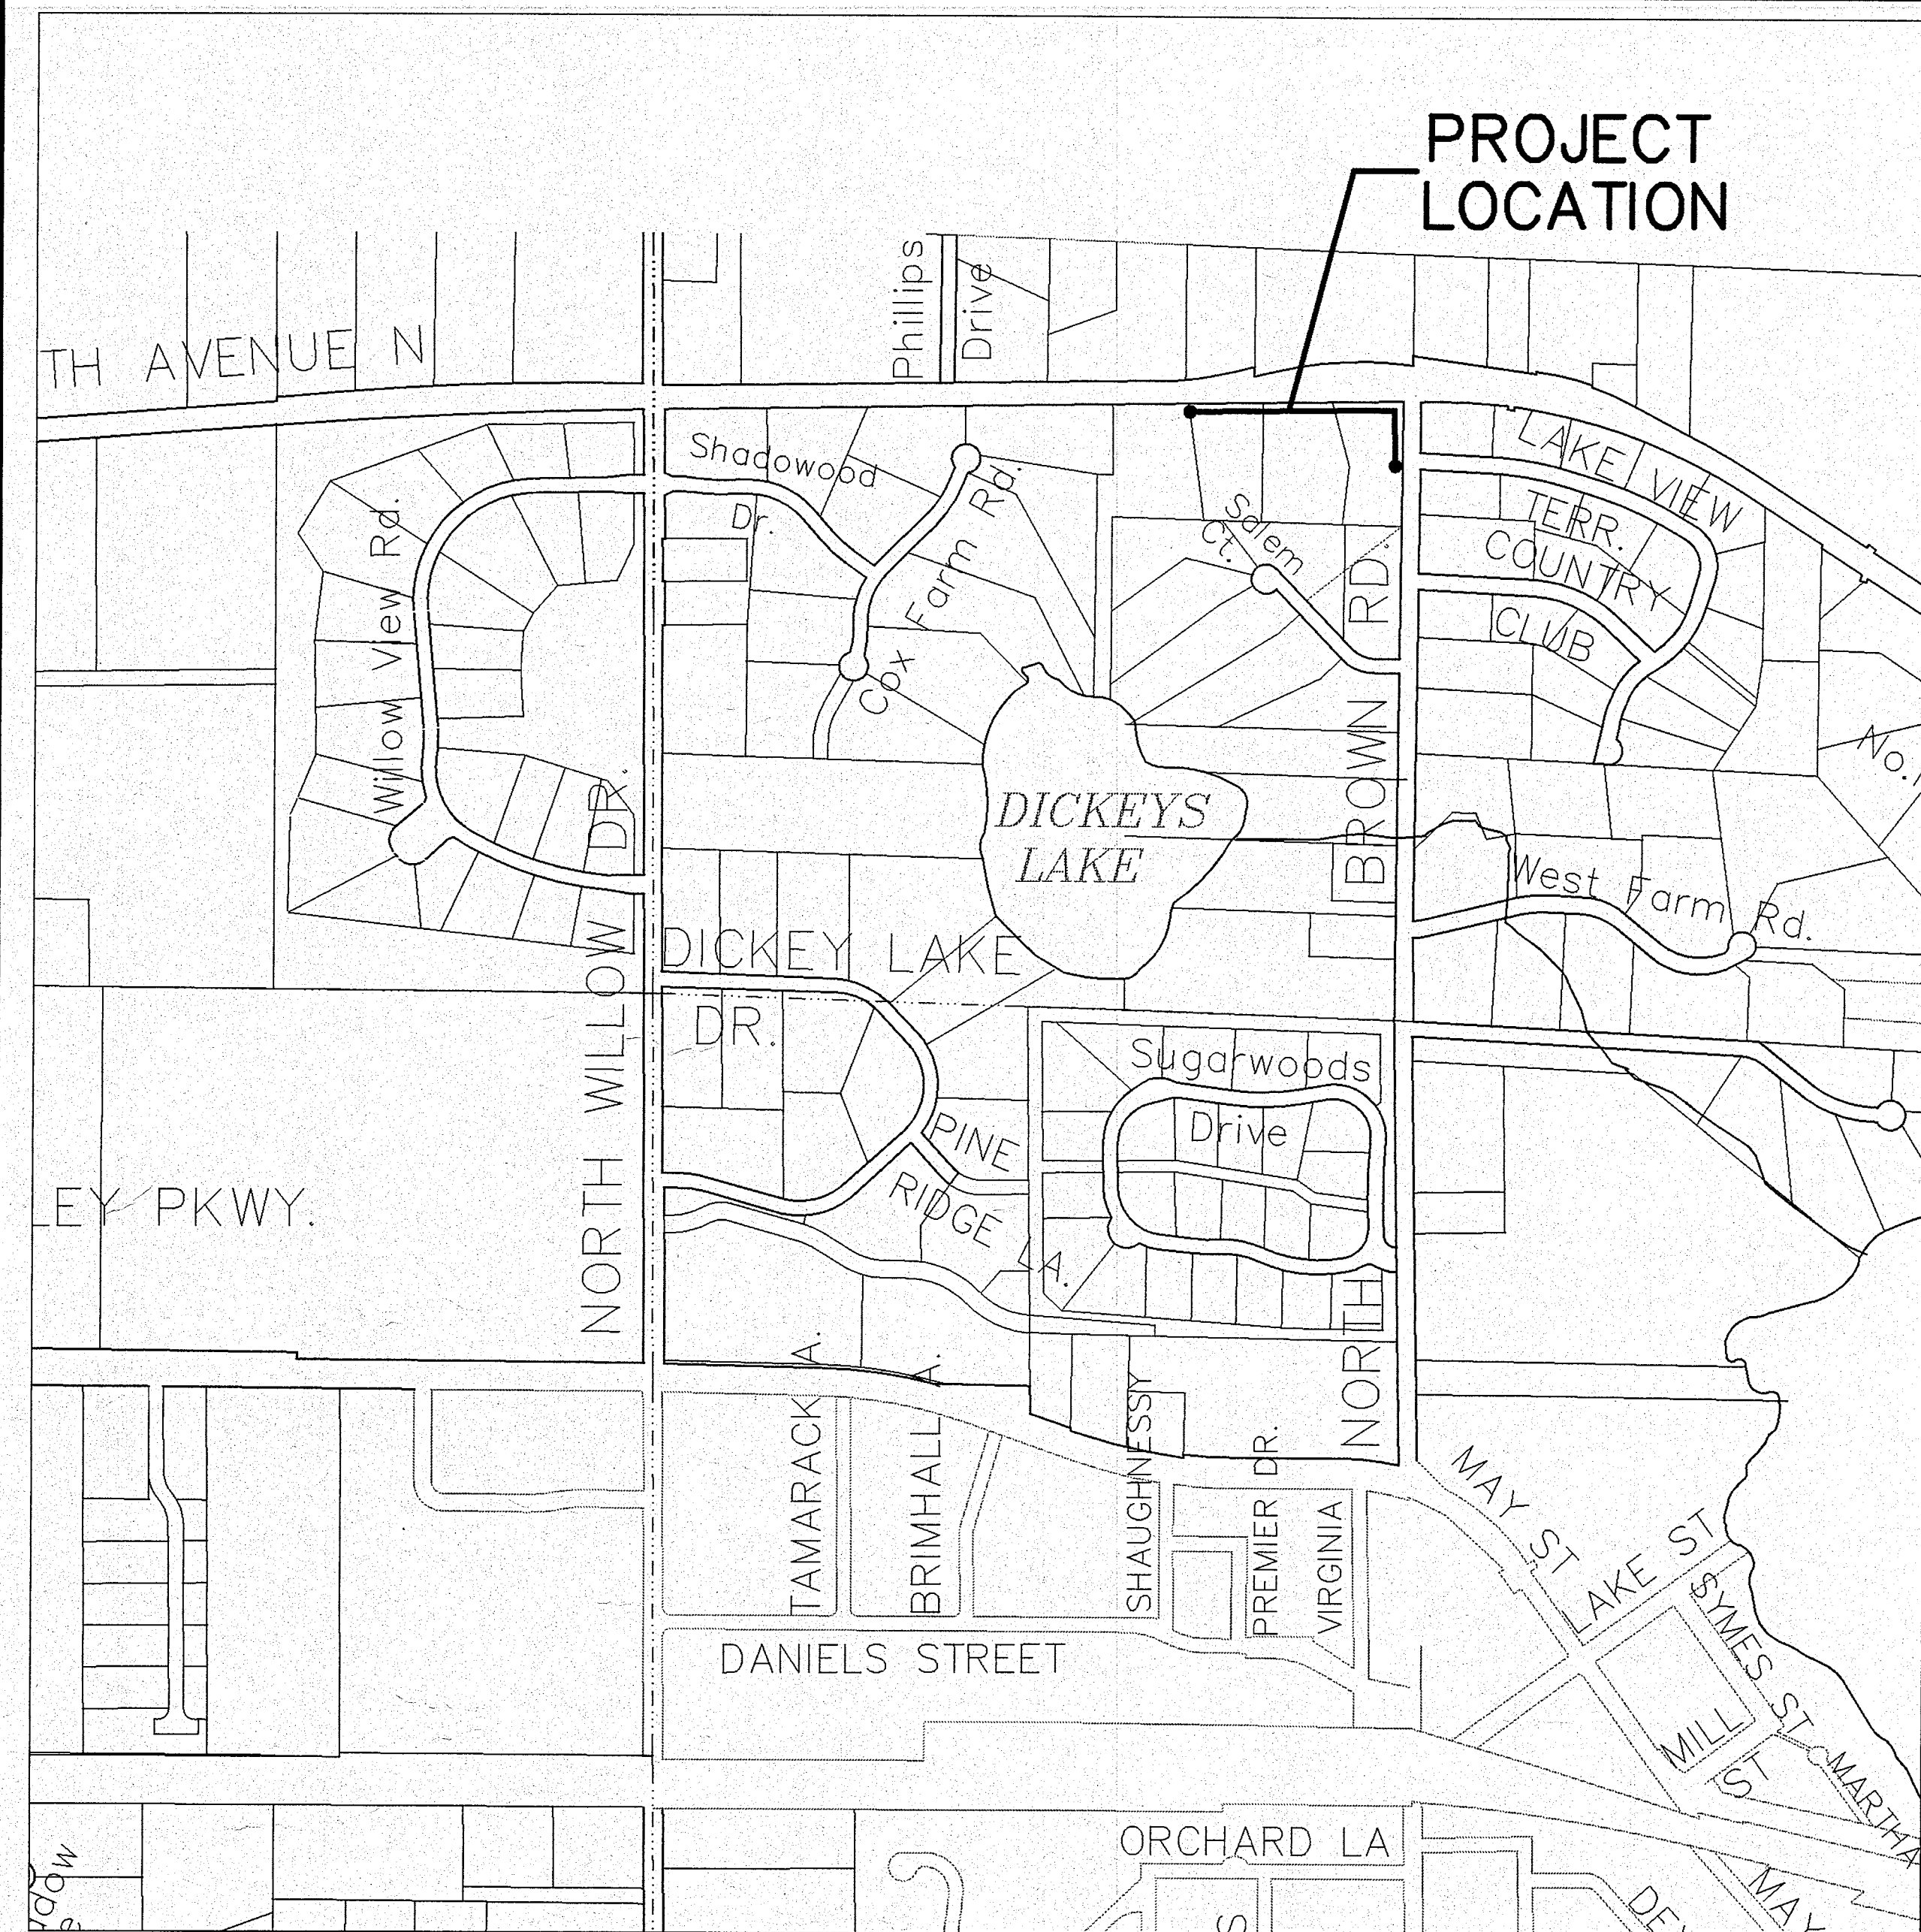


STANDARD DETAILS
BITUMINOUS TRAIL PATCH SECTION

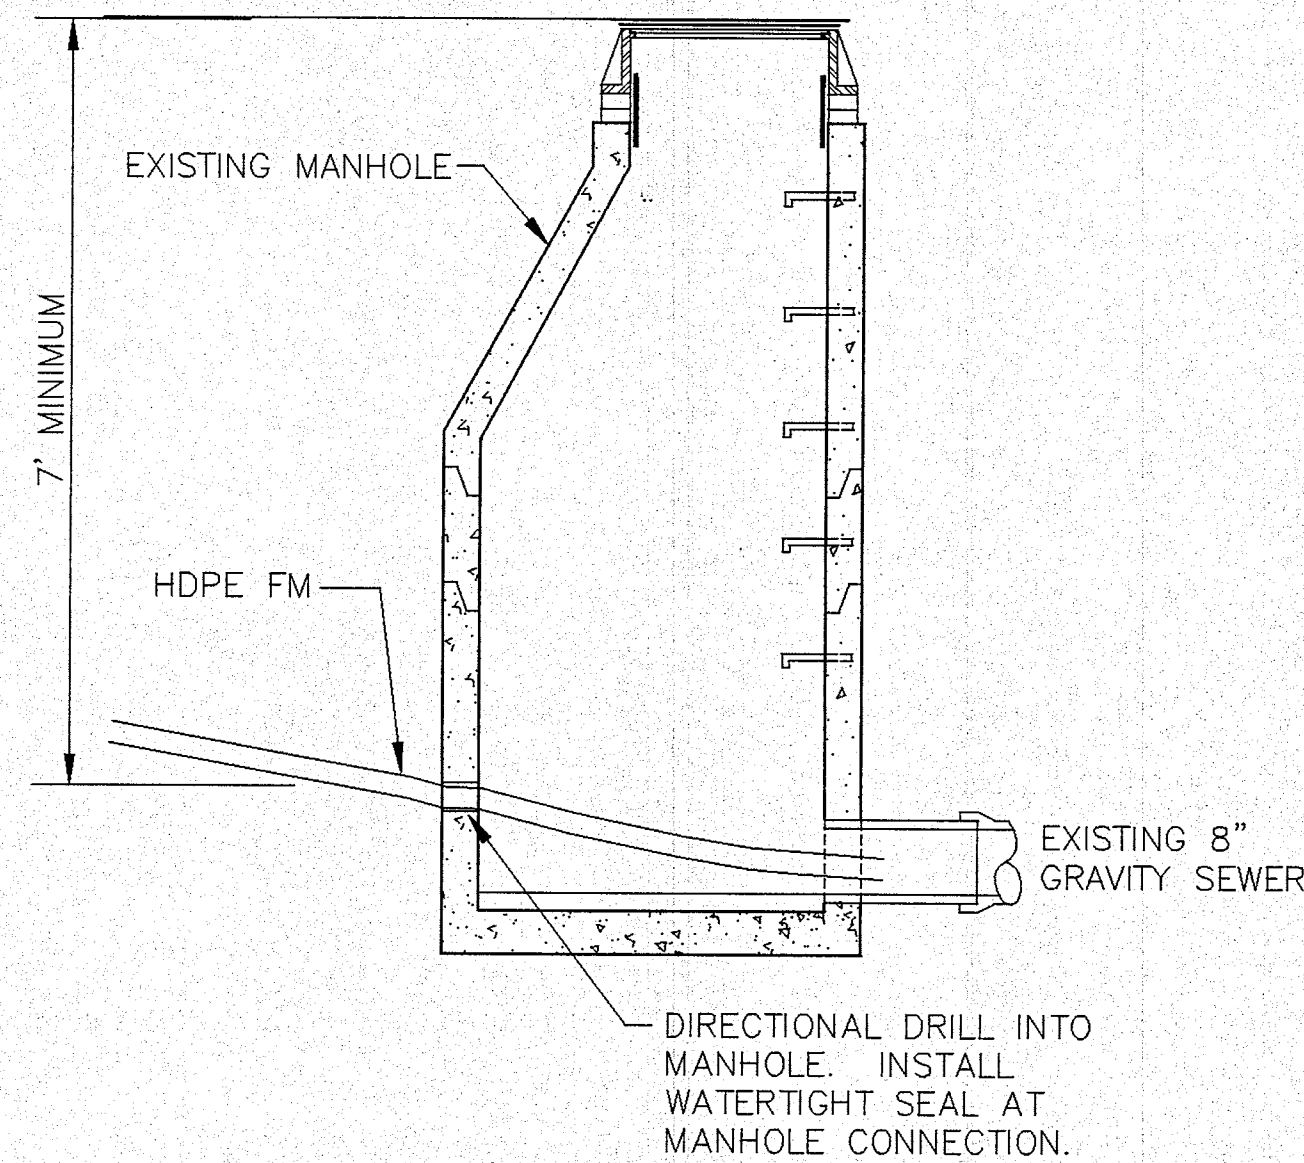

EXISTING MANHOLE CONNECTION DETAIL
NOT TO SCALE

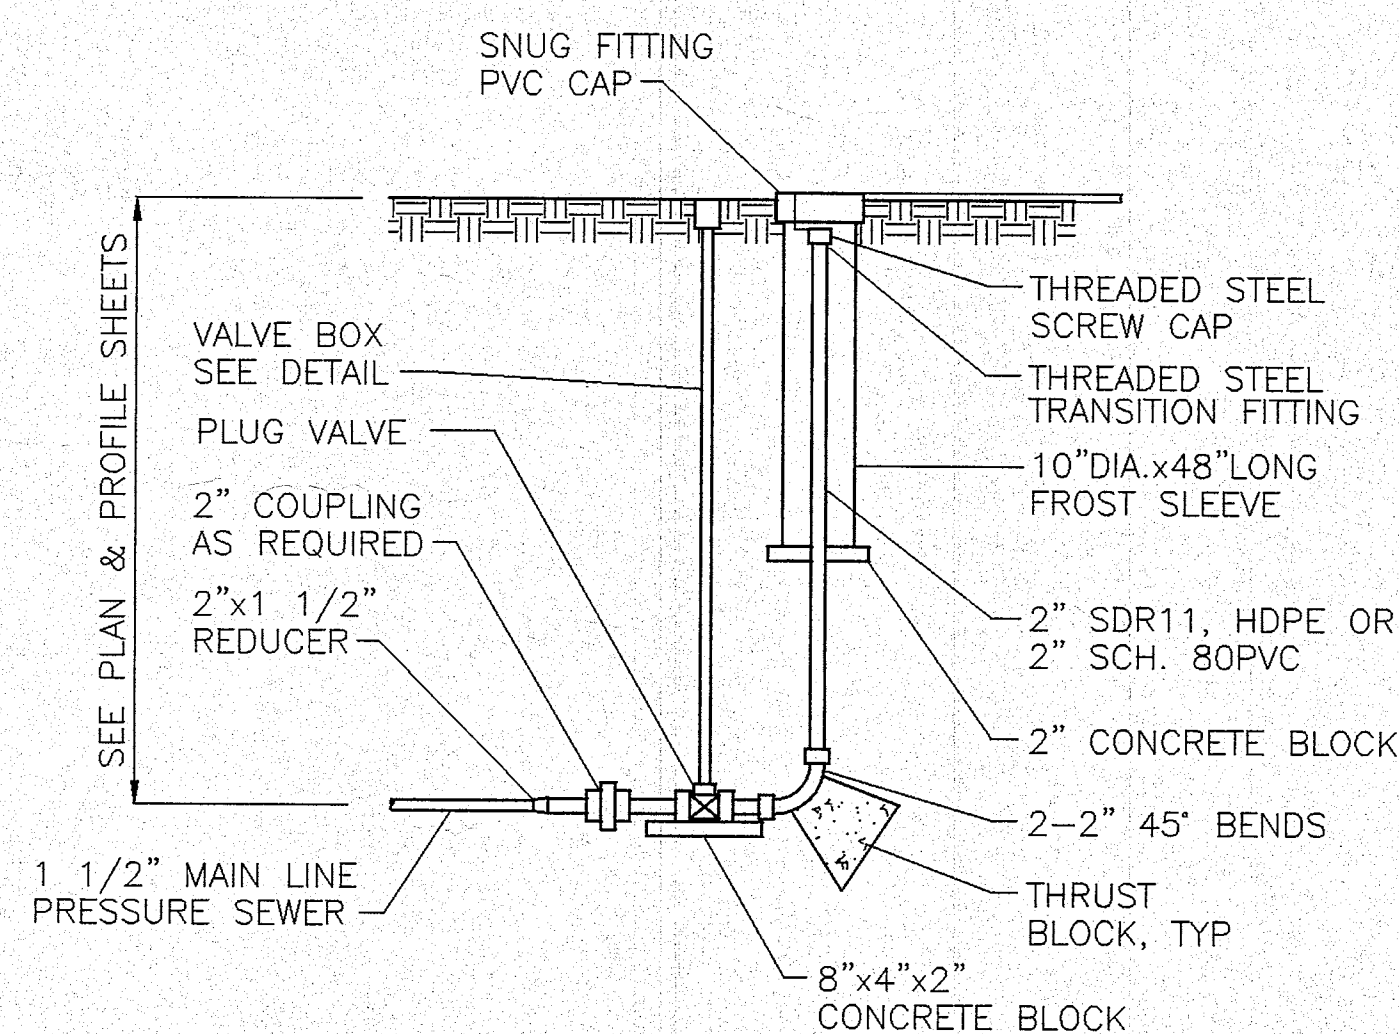


STANDARD DETAILS
TERMINATION FLUSHING CONNECTION

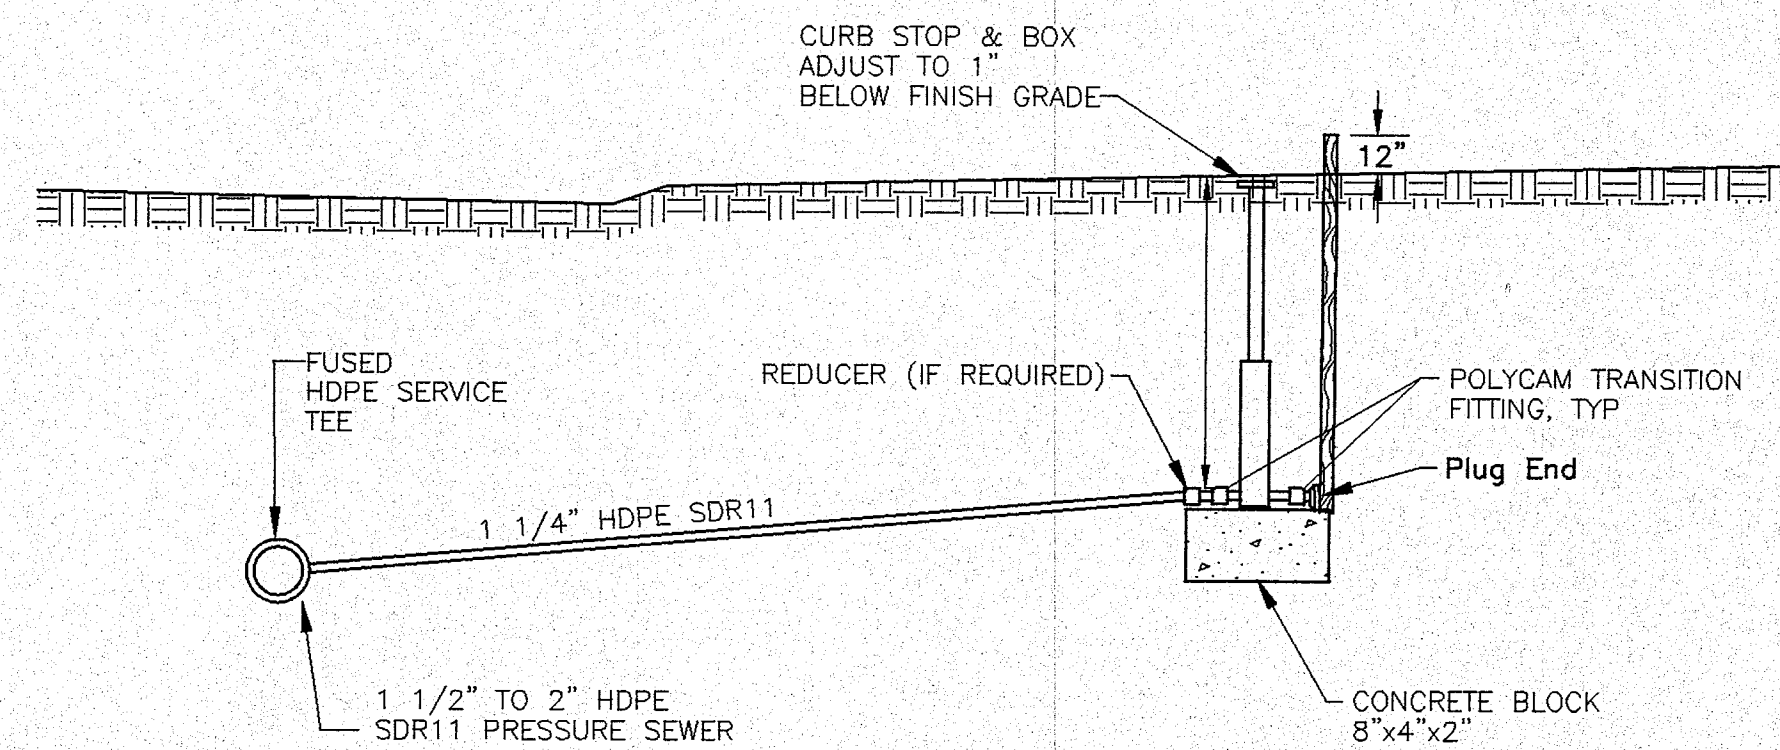

NOTE:
1. VERIFY SIZE, LOCATION OF SERVICE AND CURB BOX FOR EACH SERVICE WITH FIELD ENGINEER.
2. SERVICE SHALL BE BURIED TO A MINIMUM COVER OF 6.5'.

STANDARD DETAILS
FORCEMAIN SERVICE CONNECTION

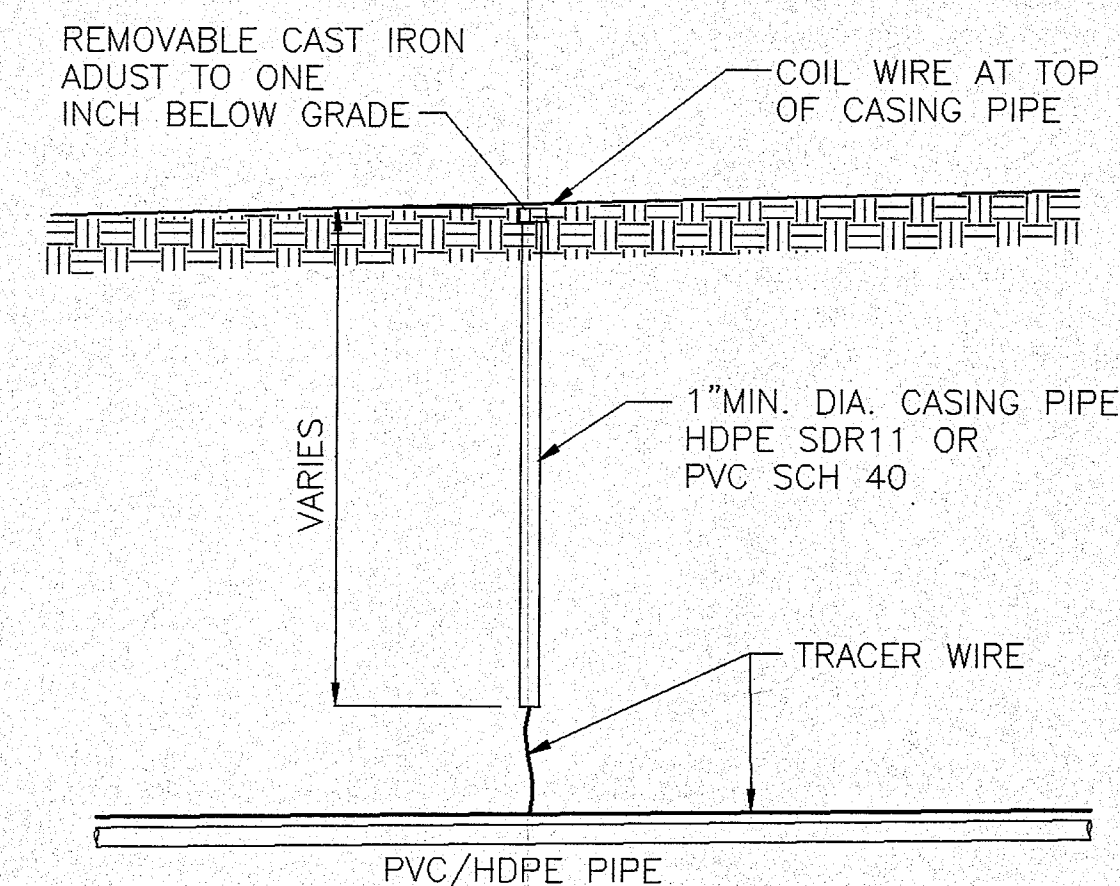

STANDARD DETAILS
TRACER WIRE DETAIL

RECORD PLAN NOV. 2003
CONTRACTOR: RED
PETERSON UTILITIES INC.