



AS-BUILT TOPOGRAPHIC DETAIL FOR MARK AND KRISTEN ANDERSON

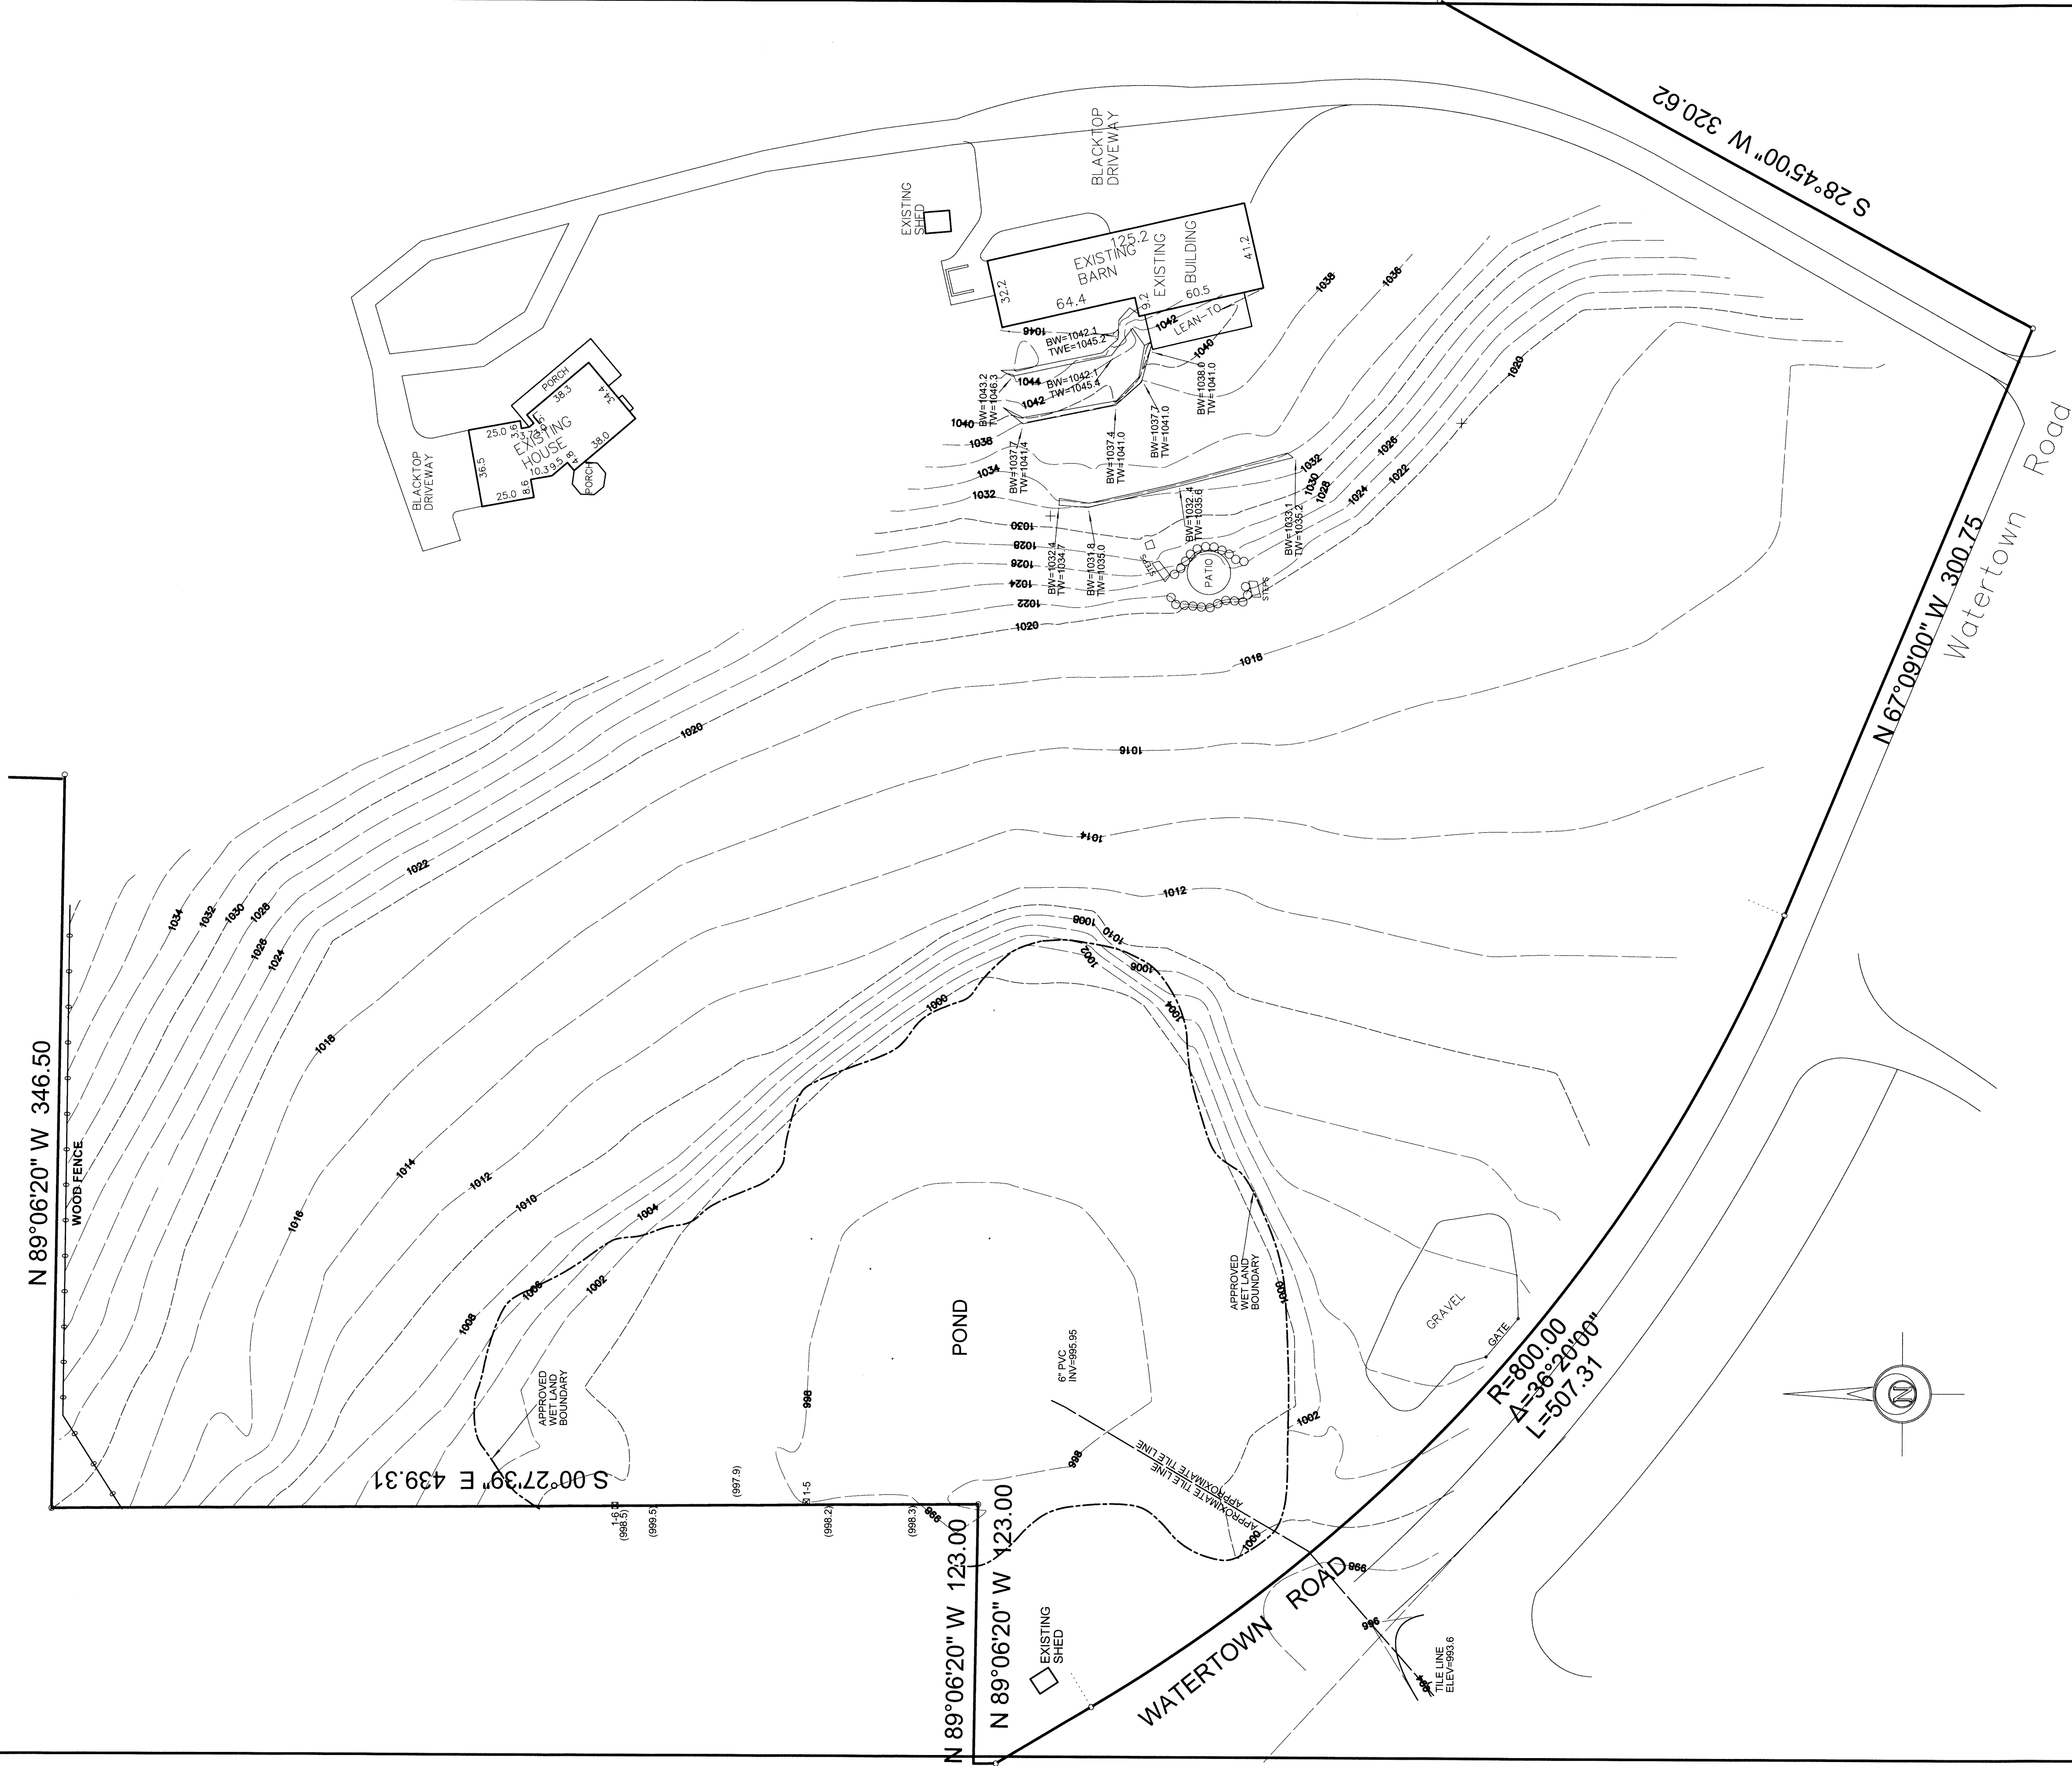

1940 ——— EXISTING CONTOUR LINE

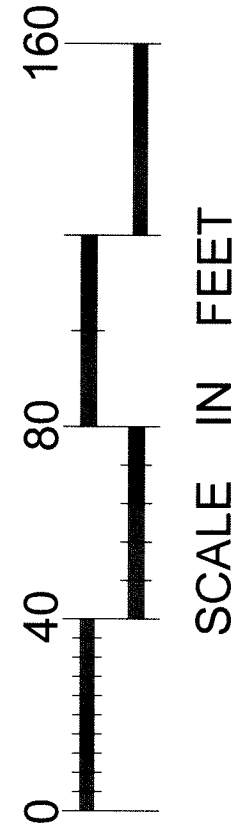


REVISIONS

DATE	BY	REMARKS

I hereby certify that this survey, plan, or report was prepared by me or under my direct supervision and that I am a duly Licensed Land Surveyor under the laws of the State of Minnesota.

Michael J. Gronberg
DATE 12-2-06 MINN. LICENSE NUMBER 22255

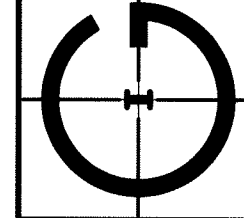

GRONBERG & ASSOCIATES, INC.
CIVIL ENGINEERS, LAND SURVEYORS, LAND PLANNERS
445 N. WILLOW DRIVE LONG LAKE, MN 55356
PHONE: 952-473-4141 FAX: 952-473-4435