


CERTIFICATE OF SURVEY FOR
JOHN C. BROOKS
IN AUD. SUB. NO. 184, & NORTH SHORE COTTAGE ACRES
CARVER COUNTY, MINNESOTA

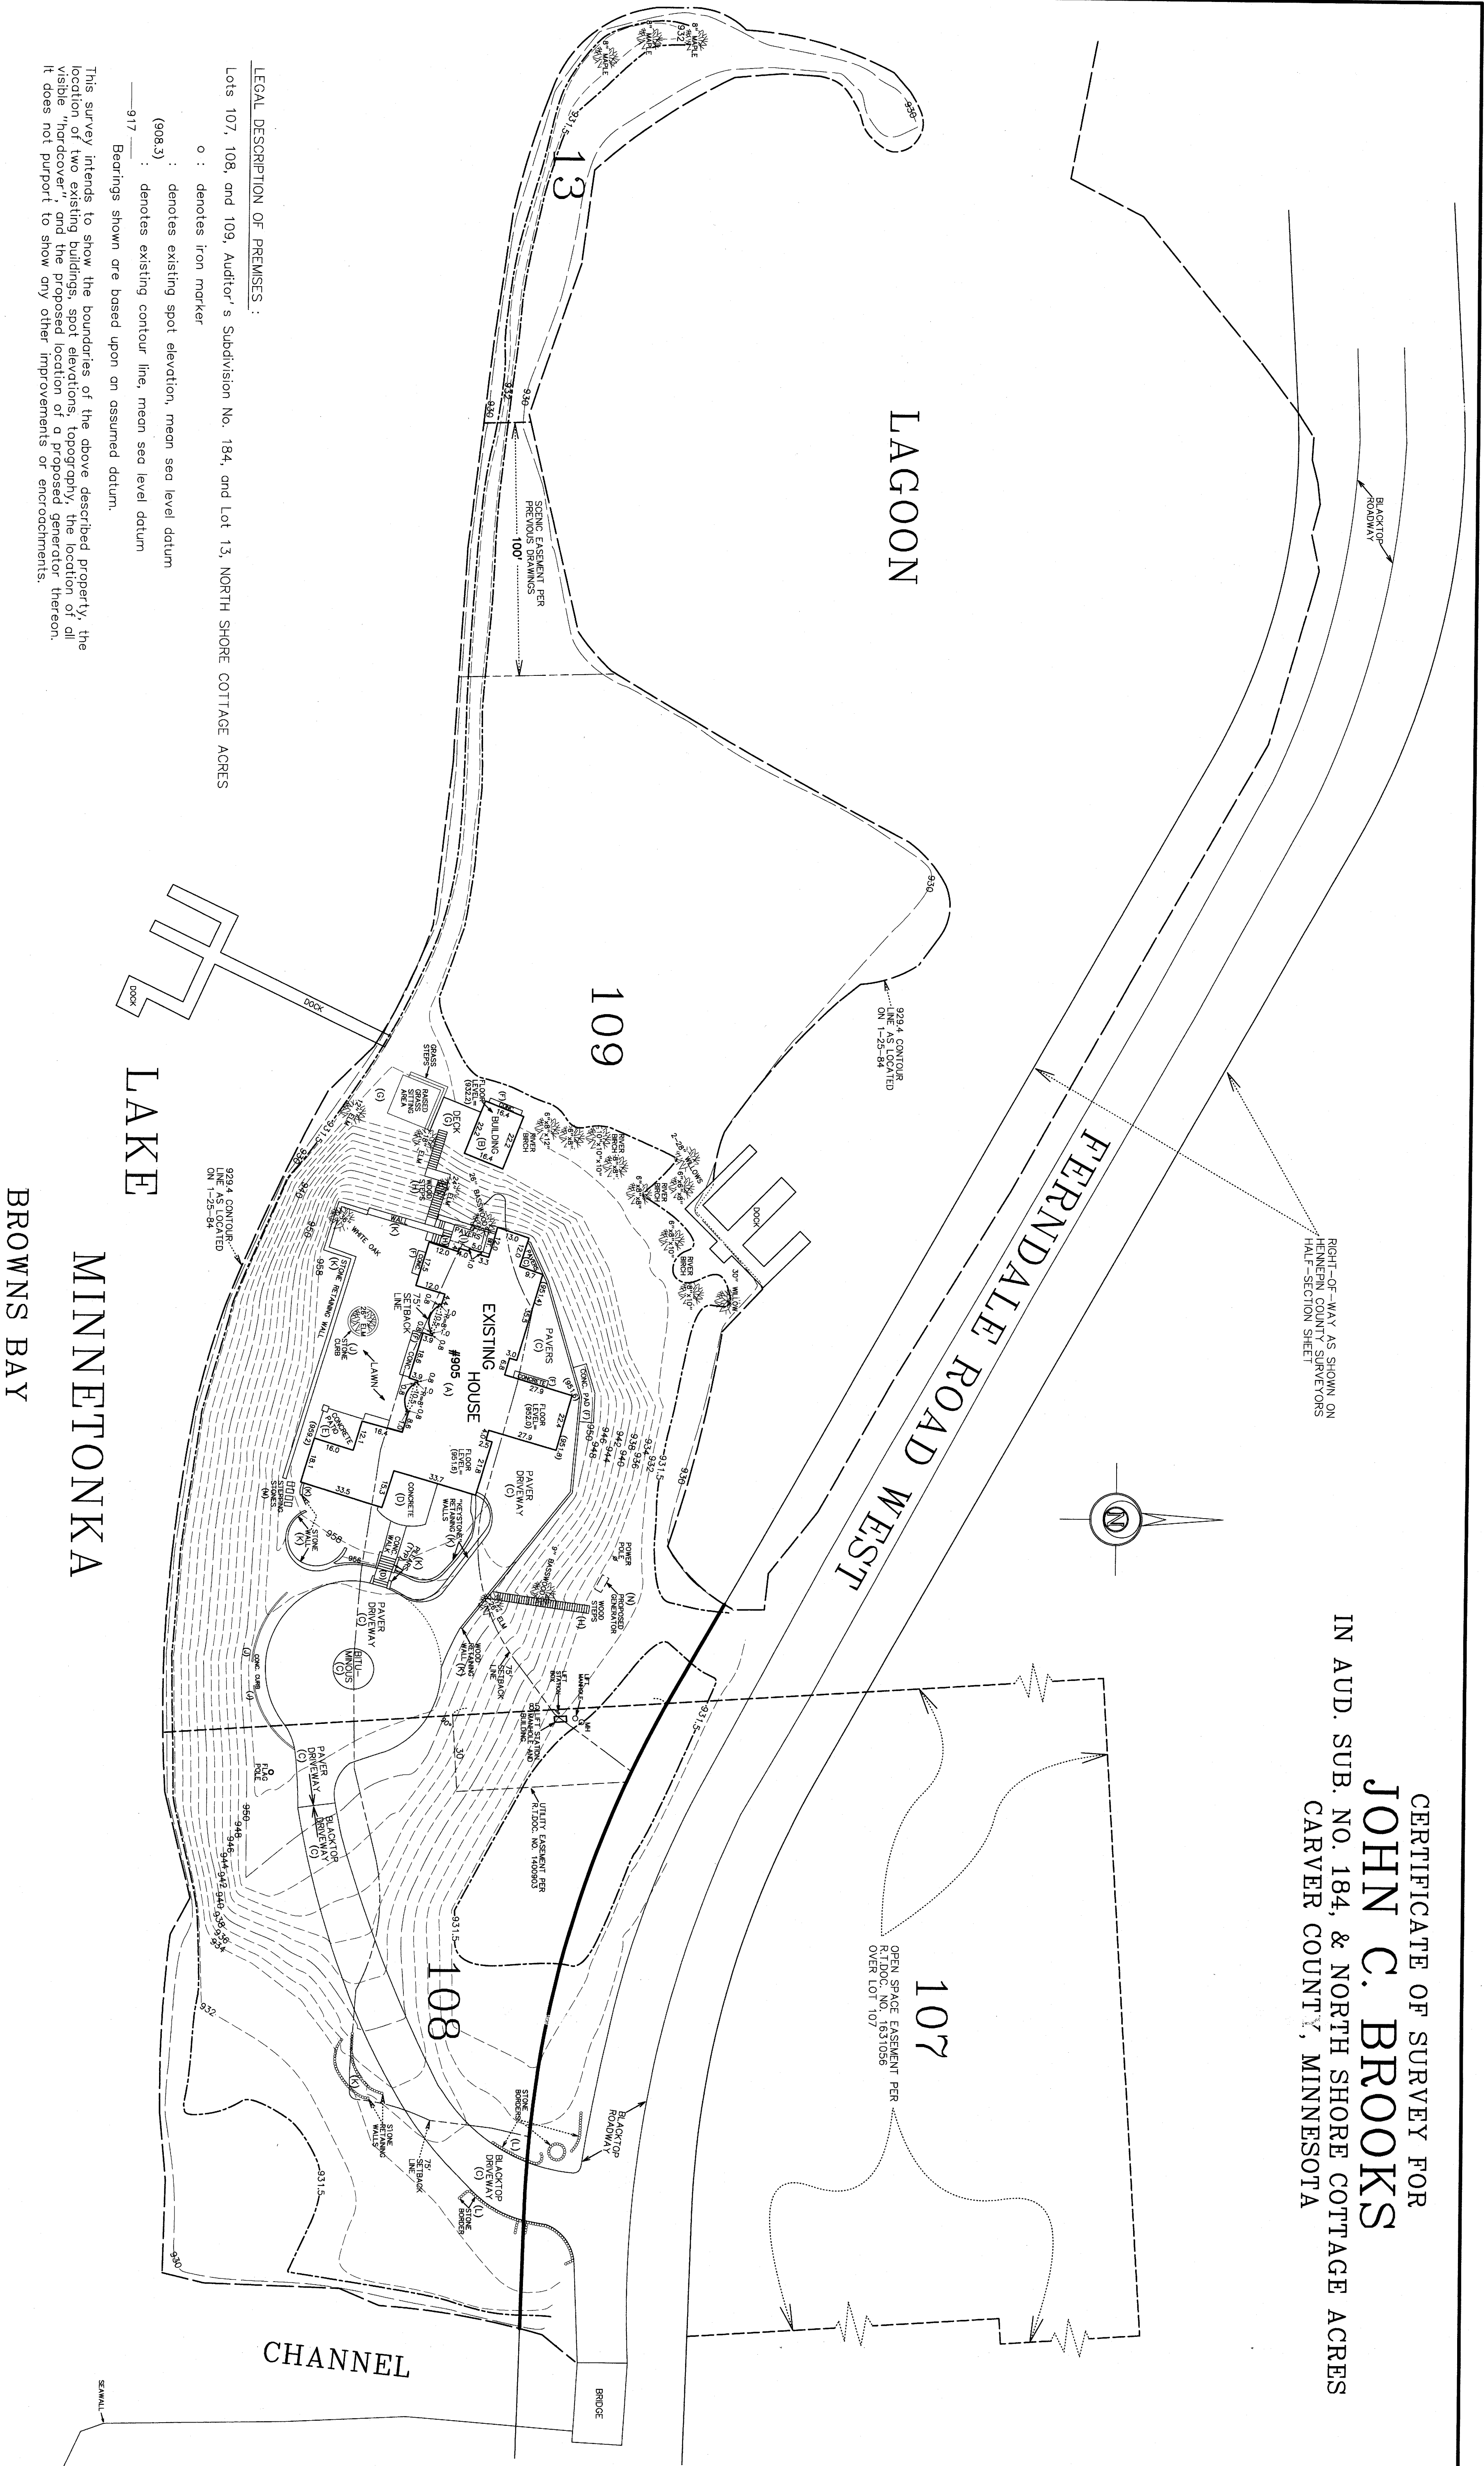

LEGAL DESCRIPTION OF PREMISES :

Lots 107, 108, and 109, Auditor's Subdivision No. 184, and Lot 13, NORTH SHORE COTTAGE ACRES

- o : denotes iron marker
- (908.3) : denotes existing spot elevation, mean sea level datum
- (908.3) : denotes existing contour line, mean sea level datum
- 917 — : Bearings shown are based upon an assumed datum.

This survey intends to show the boundaries of the above described property, the location of two existing buildings, spot elevations, topography, the location of all visible "hardcover", and the proposed location of a proposed generator, thereon. It does not purport to show any other improvements or encroachments.

DATE REMARKS

I hereby certify that this plan, specification, or report was prepared by me, or under my direct supervision, and that I am a duly Licensed Land Surveyor under the laws of the State of Minnesota.
Mark S. Gronberg
Mark S. Gronberg Minnesota License Number 12755

GRONBERG & ASSOCIATES, INC.
CIVIL ENGINEERS, LAND SURVEYORS, LAND PLANNERS
445 NORTH WILLOW DRIVE, LONG LAKE, MN 55356
952-473-4141