


CERTIFICATE OF SURVEY FOR  
**ED GARLOCK AND RICK SUNDBERG**  
OF LOTS 9 AND 18, SKARP AND LINDQUIST'S FERNHILL  
HENNEPIN COUNTY, MINNESOTA

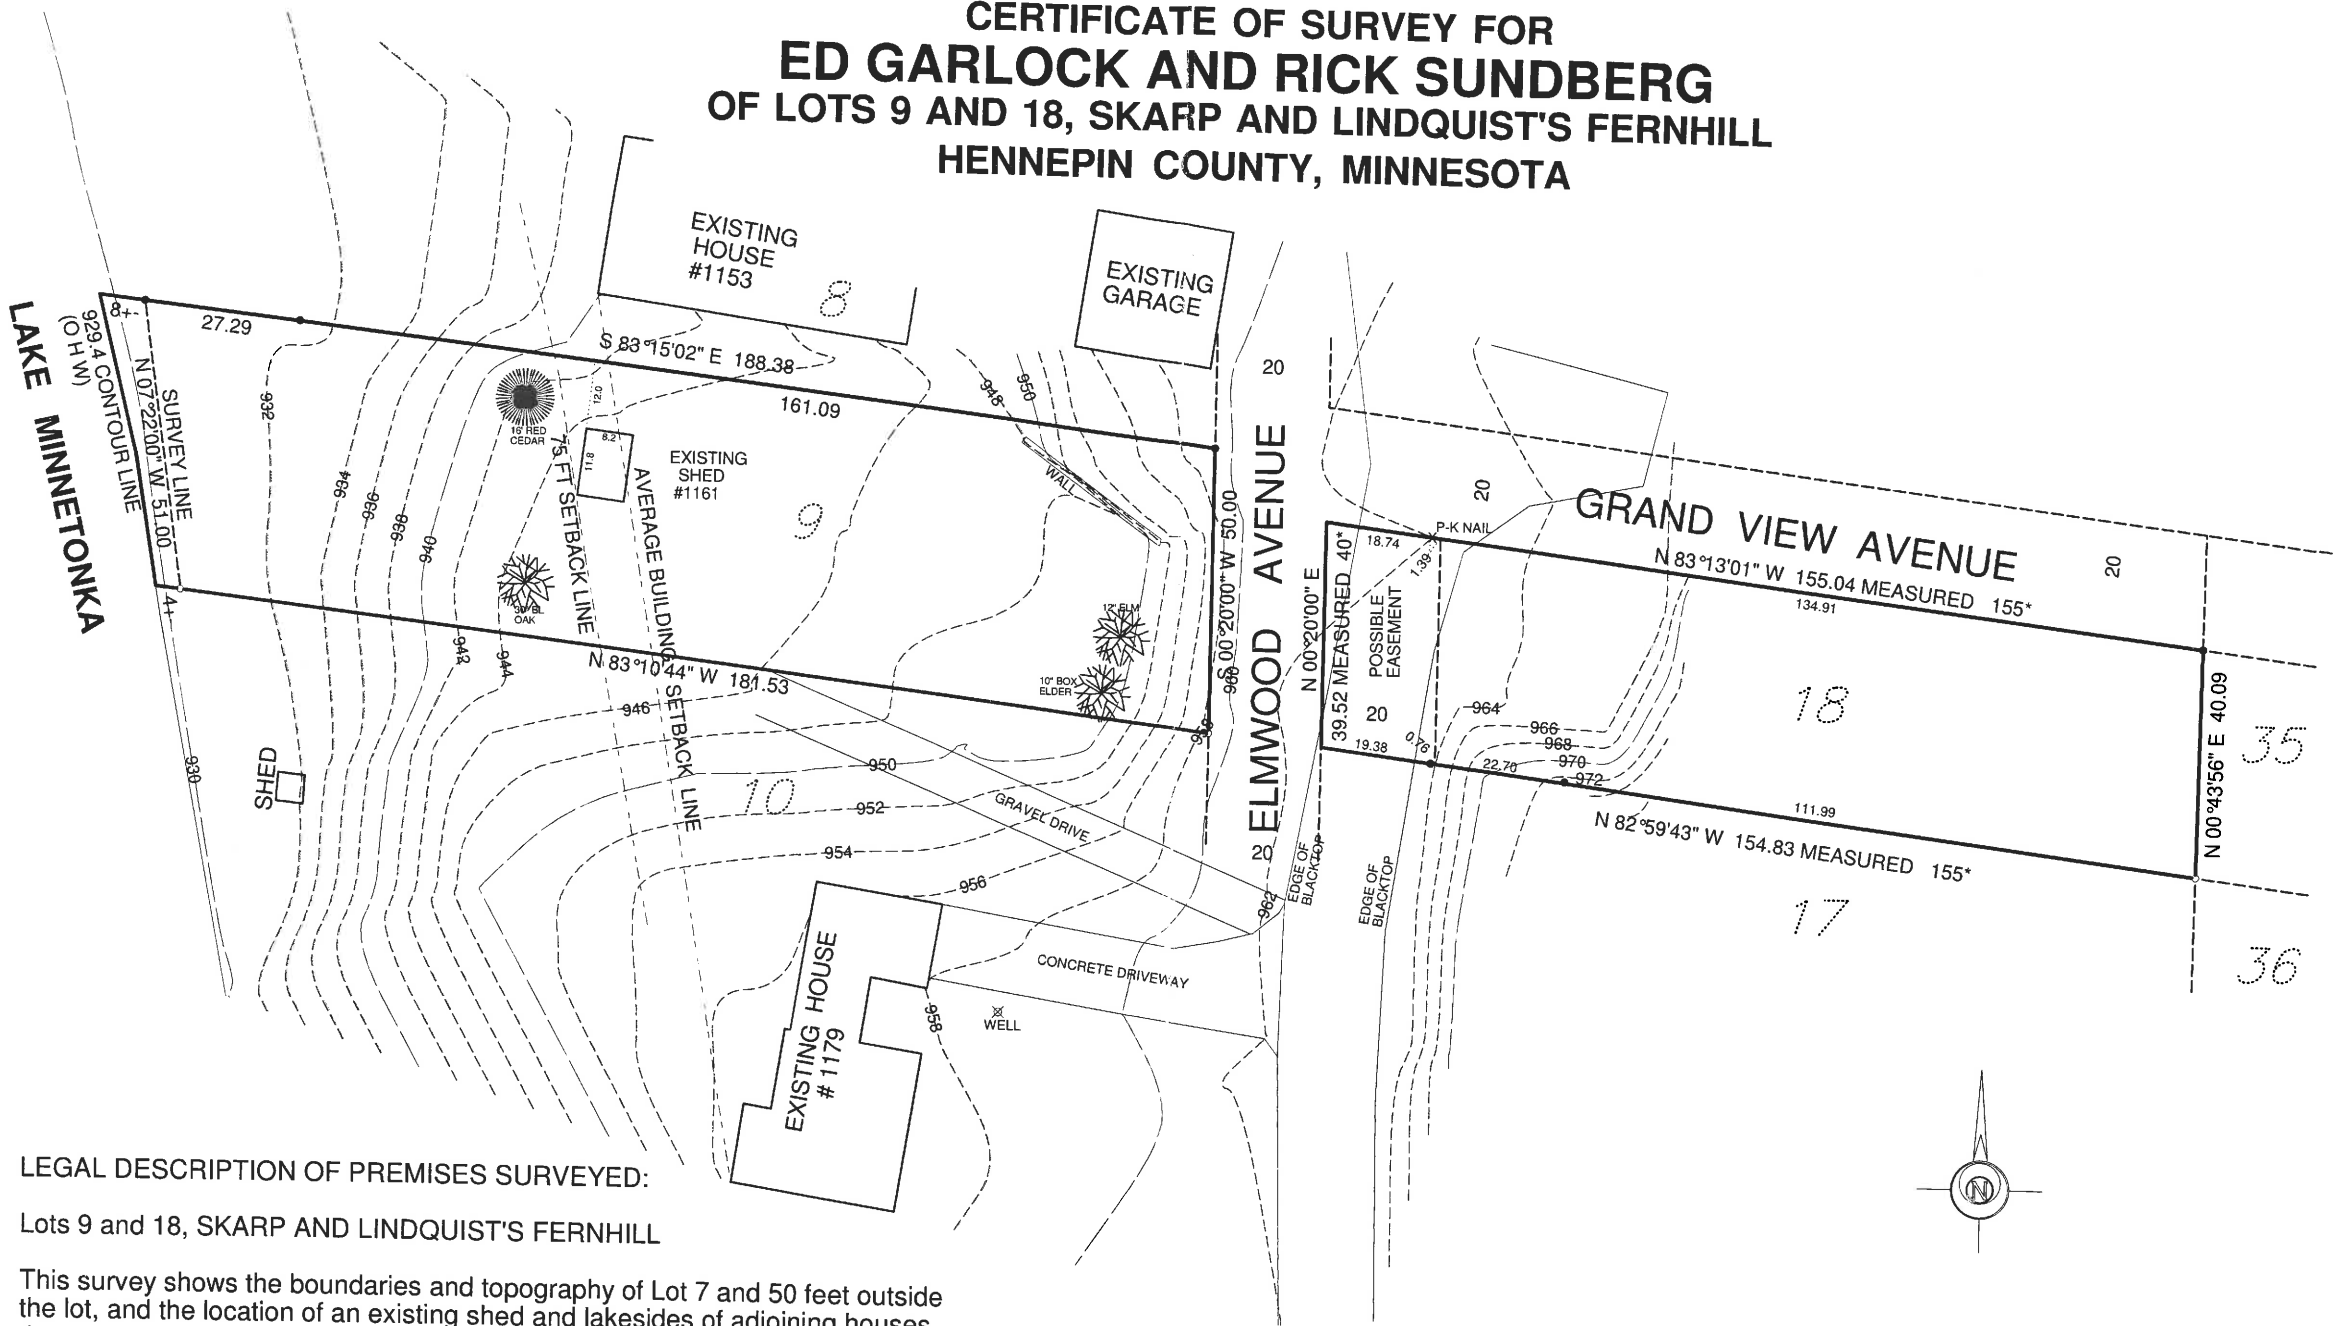

LEGAL DESCRIPTION OF PREMISES SURVEYED:

Lots 9 and 18, SKARP AND LINDQUIST'S FERNHILL

This survey shows the boundaries and topography of Lot 7 and 50 feet outside the lot, and the location of an existing shed and lakesides of adjoining houses thereon. It does not purport to show any other improvements or encroachments.

- : Iron marker found
- : Iron marker set

Bearings shown are based upon an assumed datum

\* Denotes distance shown on plat of SKARP AND LINDQUIST'S FERNHILL

DESIGNED	REVISION	DATE	DESCRIPTION
DRAWN			
CHECKED			



**GRONBERG & ASSOCIATES, INC.**

CONSULTING ENGINEERS, LAND SURVEYORS, SITE PLANNERS  
445 NORTH WILLOW DRIVE, LONG LAKE, MN. 55356  
952-473-4141

I HEREBY CERTIFY THAT THIS SURVEY, PLAN, OR REPORT WAS PREPARED BY ME OR UNDER MY DIRECT SUPERVISION AND THAT I AM A DULY LICENSED LAND SURVEYOR UNDER THE LAWS OF THE STATE OF MINNESOTA.

DATE \_\_\_\_\_ MN LICENSE NUMBER \_\_\_\_\_

SCALE  
1"=20'

DATE  
5-8-13

JOB NO.  
13-141A

RECEIVED

JUL 31 2013

CITY OF ORONO