


CERTIFICATE OF SURVEY FOR
CHRISTOPHER T. DAHL
OF LOT 7, BLOCK 2, FRENCH CREEK
HENNEPIN COUNTY, MINNESOTA

RECEIVED
JUN 10 2018
CITY OF ORONO

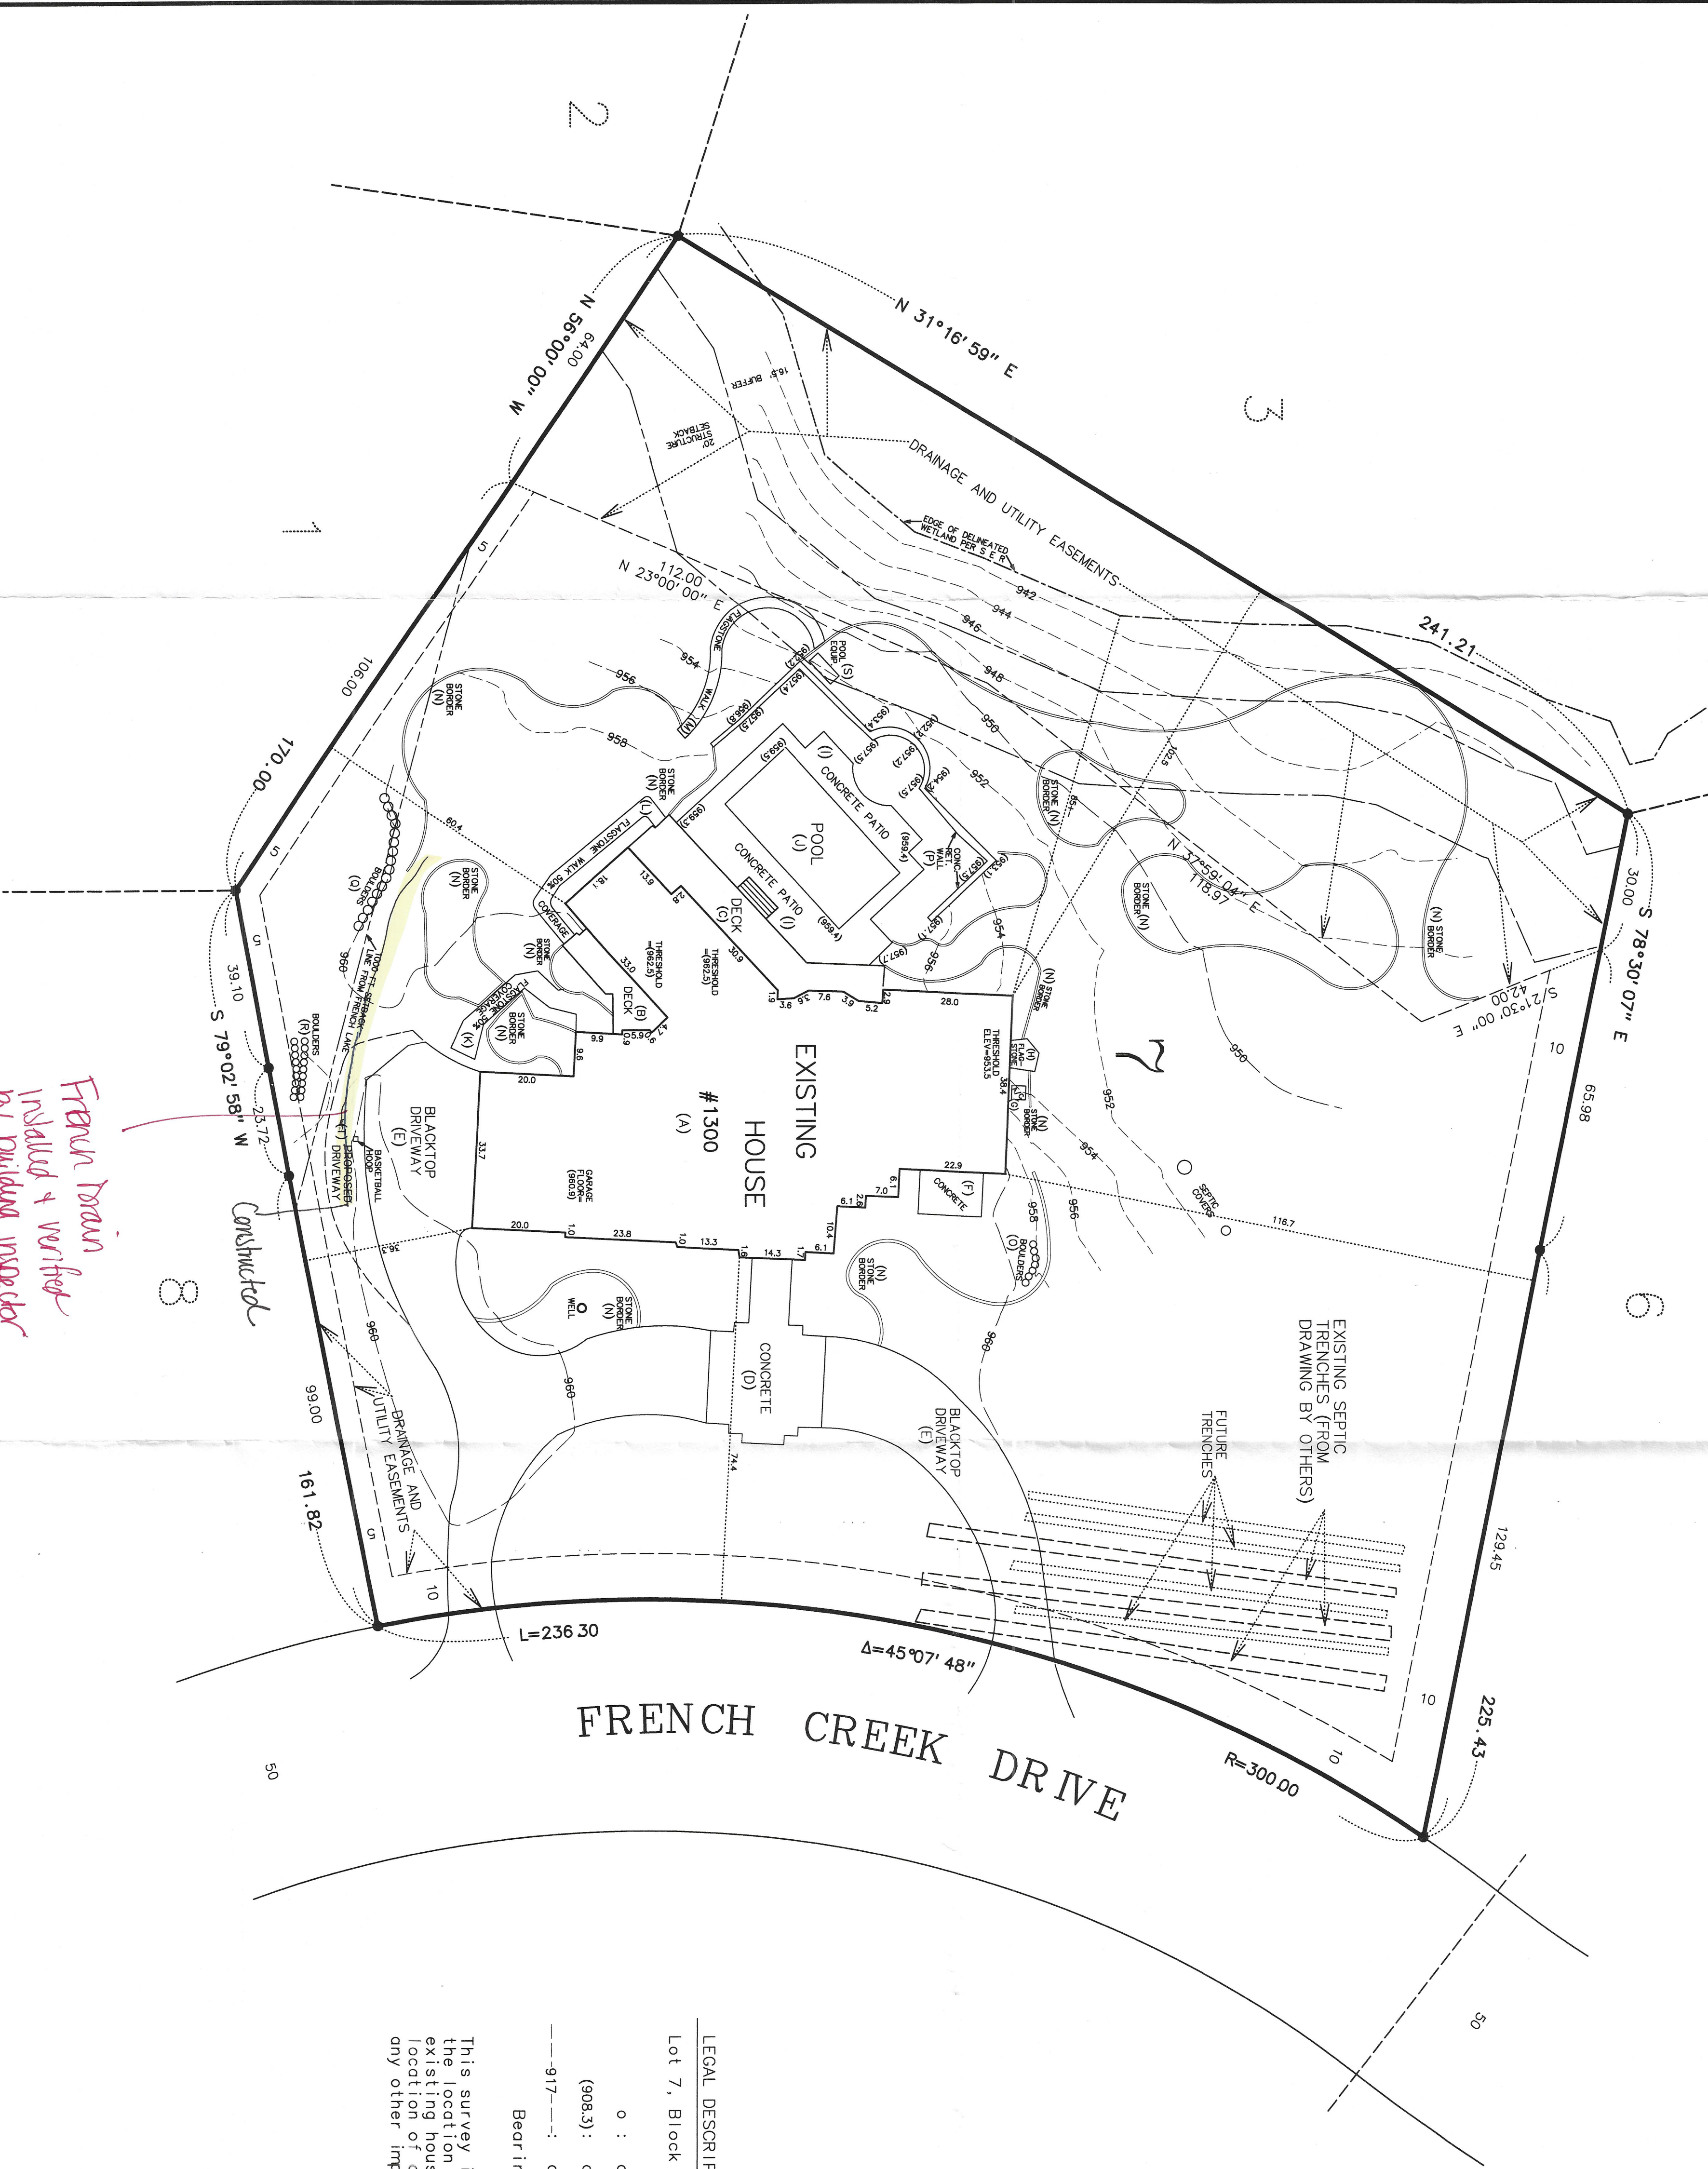

French Drain
installed & verified
by building inspector
on 8-19-18 -am

FRENCH CREEK DRIVE

LEGAL DESCRIPTION OF PREMISES :

Lot 7, Block 2, FRENCH CREEK

o : denotes iron marker

(908.3) : denotes existing spot elevation, mean sea level datum

---917--- : denotes existing contour line, mean sea level datum

Bearings shown are based upon an assumed datum.

This survey intends to show the boundaries of the above described property, the location of an existing house, spot elevations and topography around the existing house, the location of all visible "hardcover", and the proposed location of a proposed garage addition thereon. It does not purport to show any other improvements or encroachments.

DATE	REMARKS
8-7-17	PROPOSED GARAGE ADDITION SHOWN
6-6-18	EXISTING GARAGE ADDITION MEASURED, PROPOSED DRIVEWAY PORTION ADDED

I hereby certify that this plan, specification, or report was prepared by me, or under my direct supervision, and that I am a duly Licensed Land Surveyor under the laws of the State of Minnesota.
Mark S. Gronberg
Mark S. Gronberg Minnesota License Number 12755

PROJECT

DATE	6-6-12
SCALE	1"=20'
JOB NO	18-192



GRONBERG & ASSOCIATES, INC.
CIVIL ENGINEERS, LAND SURVEYORS, LAND PLANNERS
445 NORTH WILLOW DRIVE LONG LAKE, MN 55356
952-473-4141

1300 French Creek Dr.
2018-00204
AS-BUILT Survey