


CERTIFICATE OF SURVEY FOR
SCOTT MILLER
OF LOT 9, AUDITORS SUB. NO. 230
HENNEPIN COUNTY, MINNESOTA

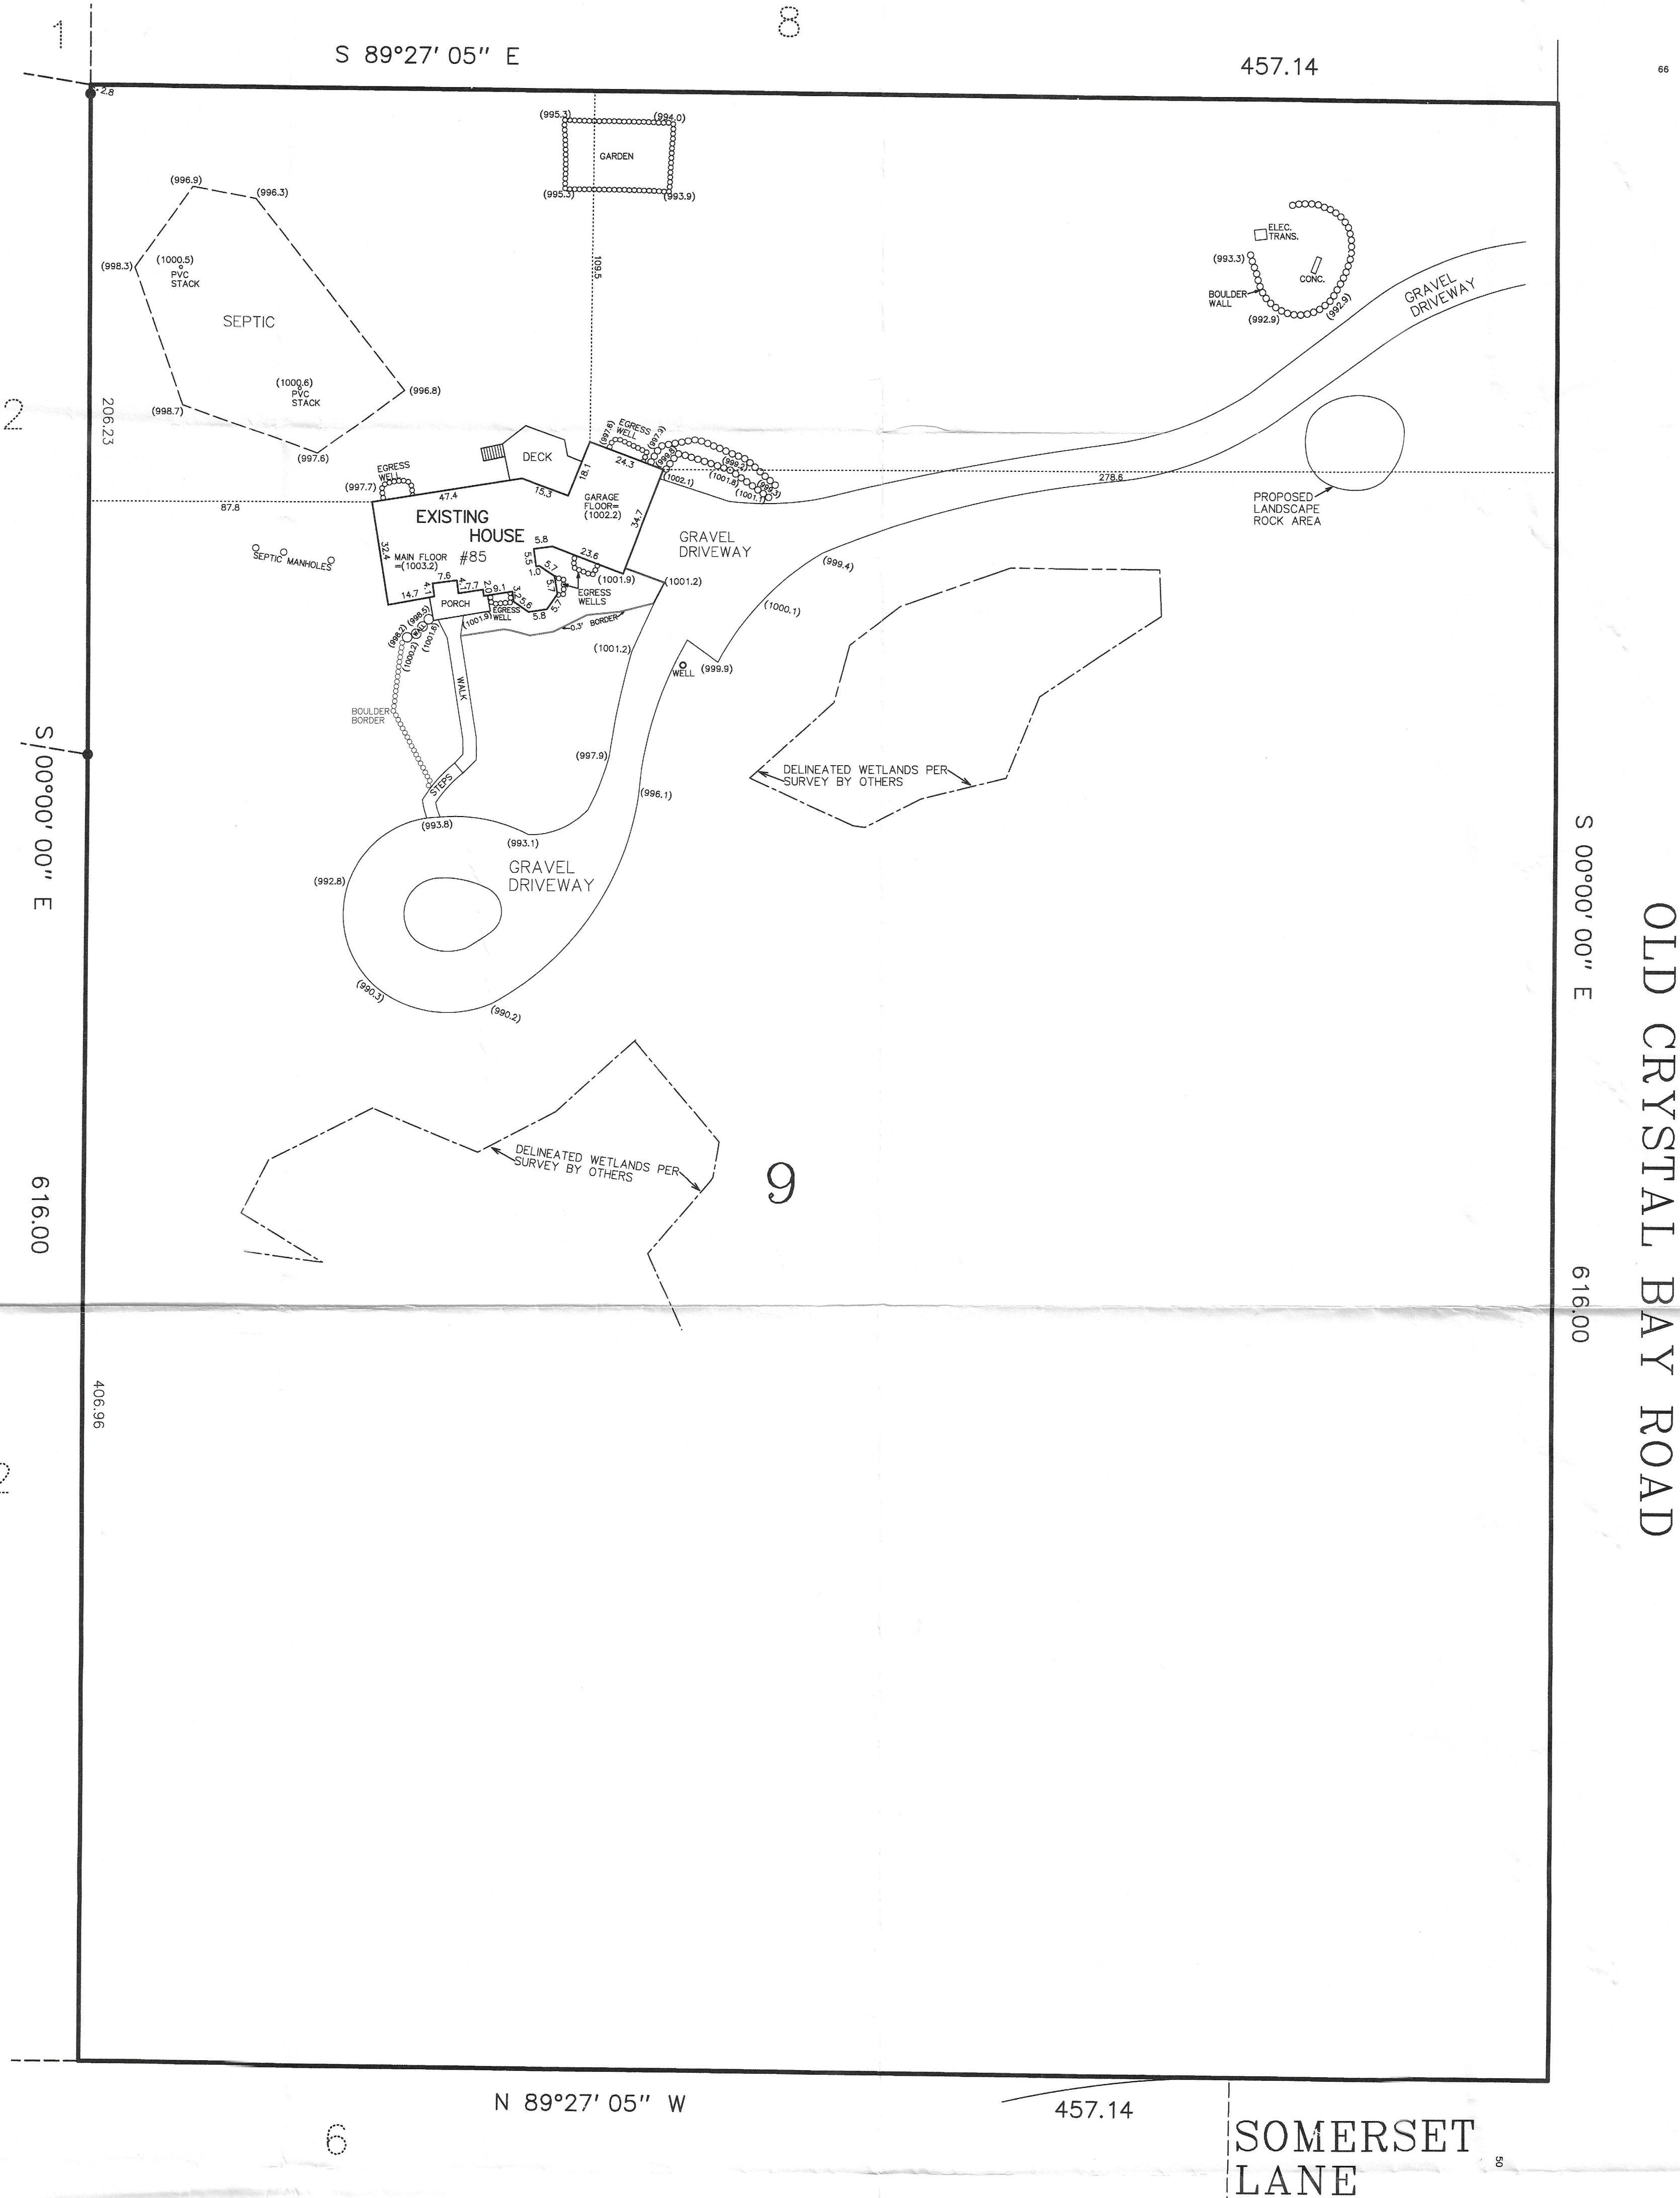

LEGAL DESCRIPTION OF PREMISES :

Lot 9, AUDITORS SUBDIVISION No. 230

● : denotes iron marker found

(908.3) : denotes exiting spot elevation, mean sea level datum

Bearings shown are based upon an assumed datum.

This survey intends to show the boundaries of the above described property and the location of an existing house, spot elevations, and all visible "hardcover" thereon. It does not purport to show any other improvements or encroachments.

RECEIVED
AUG 3 1 2020
CITY OF ORONO

DATE	REMARKS	I hereby certify that this plan, specification, or report was prepared by me, or under my direct supervision and that I am a duly Licensed Land Surveyor under the laws of the State of Minnesota.  Mark S. Gronberg Minnesota License Number 12755	PROJECT		 GRONBERG & ASSOCIATES, INC. CIVIL ENGINEERS, LAND SURVEYORS, LAND PLANNERS 445 NORTH WILLOW DRIVE LONG LAKE, MN 55356 952-473-4141
10-12-17				DATE 12-17-15	
				SCALE 1"=30'	
				JOB NO 17-375	