




City of Orono Septic Asbuilt Form

Address: 1130 Hunter Drive Building Use: Residence
Installer: Kothrade Sewer and Excavating License # L0192 Date: 1/28/2019
Septic Tanks: 2250 Pump Tank: 1500 Date Finaled: _____ Bedrooms # 5
System Type: ☒ I ☐ II ☐ III ☒ Mound ☐ Trenches ☐ Pressure Bed ☐ Other _____

Draw detailed diagram with measurements indicating distances to tank Risers. Use two(2) points from a permanent structure. Show locations of drop Boxes and length of trenches

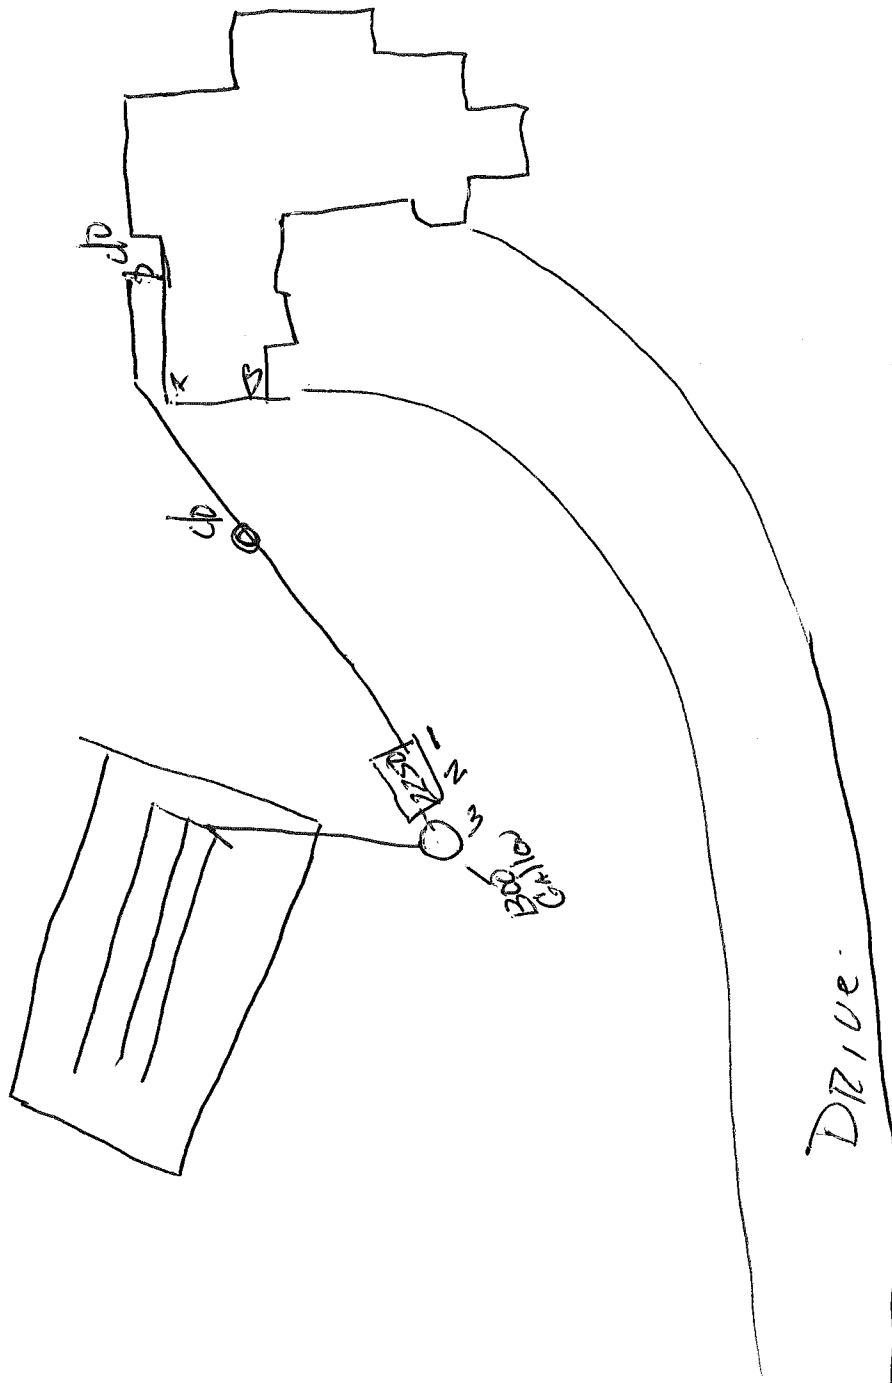

	A	B
1	92	83
2	97	89
3	106	102
4		
5		
6		
7		
8		
9		
10		
11		
12		