

Village Permit No. 4444

Contractor _____ Address _____
Owner Temple Israel Address 645 Tonkawa
State License No. _____ Village License No. _____

GENERAL PERMIT
VILLAGE OF ORONO
Crystal Bay, Minnesota

Date 6-3-76

Section No. _____ Parcel No. _____
Lot _____ Block _____ Subdivision _____
Plat No. _____
Other Description: _____

I hereby agree that, in case a permit is granted, all work which shall be done and all materials which shall be used, shall comply with the Village Code of Orono applicable thereto, and shall include all additional specifications as listed below.

SAC only
one bldg only

Water Meter: Fee \$ _____
Sewer Hookup: Fee \$ _____
Install Plumbing Systems: Fee \$ _____
Install Sewage Disposal Systems: Fee \$ _____
Install Water Hookup: Fee \$ _____
Install Water Supply Systems: Fee \$ _____
Install Sewer Hookup: Fee \$ _____
State Surtax: Fee \$ _____
Total Amount Paid to Village: Fee \$ 350.00

Signature of applicant

mail-in

Signature of Village Official

[Signature]

CITY OF ORONO
P. O. BOX 66
CRYSTAL BAY, MINNESOTA 55323

BUILDING JOB REPORT

ADDRESS 645 Touleau Rd

OWNER _____


CONTRACTOR _____

DATE _____ PERMIT NO. _____

DESCRIPTION _____

Sewer 1-2 pm?

INSPECTION RECORD

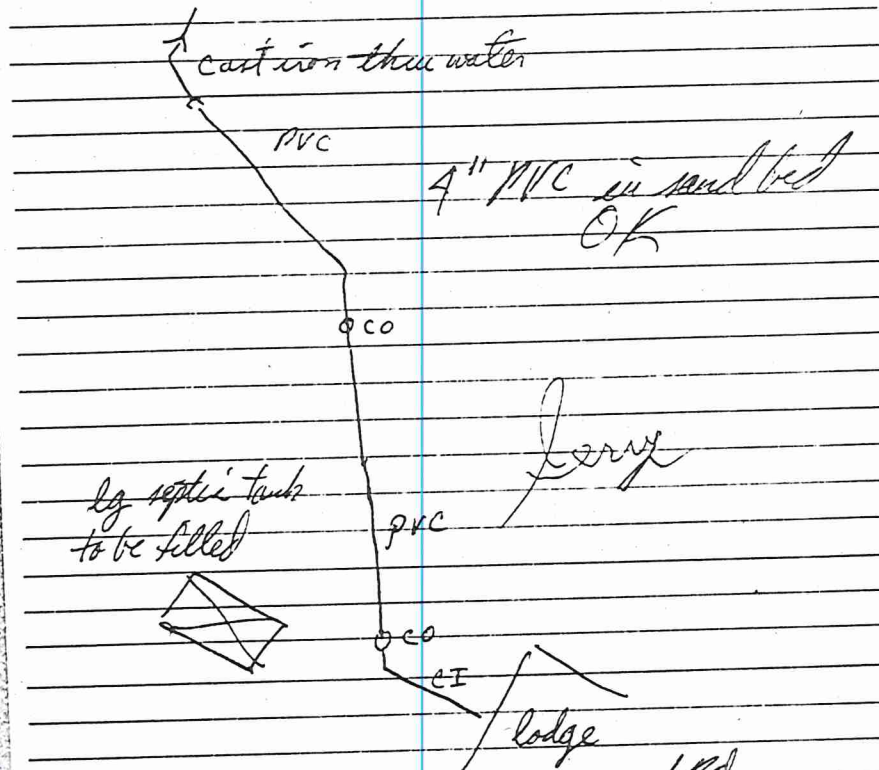

REP. _____
DATE 6-7-76 INSPECTION [Signature]

CITY OF ORONO
P. O. BOX 66
CRYSTAL BAY, MINNESOTA 55323

BUILDING JOB REPORT

ADDRESS 645 Tonkawa
OWNER Temple Israel
CONTRACTOR _____
DATE 6-1 9:30 AM PERMIT NO. _____
DESCRIPTION verify services for sewer connection

INSPECTION RECORD

Mrs Kalman 938-1552 mornings
377-9157 afternoons
says
Stones Lodge has no facilities now
5+5
Existy Bldg has kitchen, 4 WC / 2 lavs
satellites used for supplement
day camp usually - some weekends
David Schuman, caretaker

REP. _____
DATE 6-2-76 INSPECTION AJO