



TASK 65776

Date Called in	6/24/2022
Date Scheduled	6/30/2022 9:00 AM

City Of Orono

Point of Sale Sanitary Sewer Service I&I Compliance Inspection Form

Reschedule 7/13/22 1:00 PM
7/18/22 11:00 AM

Property Address:	2160 Prospect Ave
PID:	1011723310017

Owner Information	
Name:	Michael Maddie
Mailing Address: (if different from Property)	9811 NE Radio School Rd Bainbridge Island, WA 98110 Janet Boschwitz 612-804-8720
Phone:	612-554-8431
Email:	janetboschwitz@edinarealty.com

Inspector Information	
Name:	Brian & Scott
Company/ Organization	License number:
Phone:	Email:

Inspection			
System	Standard	Pass	Fail
Roof Drains	Roof drains and leaders Roof drains should not be connected to the sanitary sewer but should discharge to the ground outside of a building. If the roof drains are connected to the sanitary sewer, disconnect them, plug any open connections to the sanitary sewer using a non-shrink permanent material, and redirect the roof drains onto the ground outside the building.	✓	
Foundation Drains	Foundation drains are underground pipes that collect storm water from around the base of a building and into a sump basket, where it is then pumped outside of the building. Foundation drains should not be connected to the sanitary sewer.	✓	
Sump Pumps	Sump pumps are designed to capture surface or ground water that enters basements or crawl spaces and pump it away from the house. The basic sump system includes drain tile, a sump pit, a sump pump, a float or switch, and a drain line. Sump pumps should not be connected to the sanitary sewer.	✓	
Sewer Service Line	Sanitary Sewer Inflow & Infiltration (I/I) Compliance Inspection Sanitary Sewer Lines. All sanitary sewer lines serving Property, from the house to the main line, shall be in a safe and functional condition and shall be free from all leaks, failures including but not limited to partially collapsed sections or tree root intrusion. The sanitary sewer lines shall meet the City Code standards and specifications. (Details on back of this sheet)	✓	
Notes:			
Toilet Removed For Inspection:	X Yes ○ No		

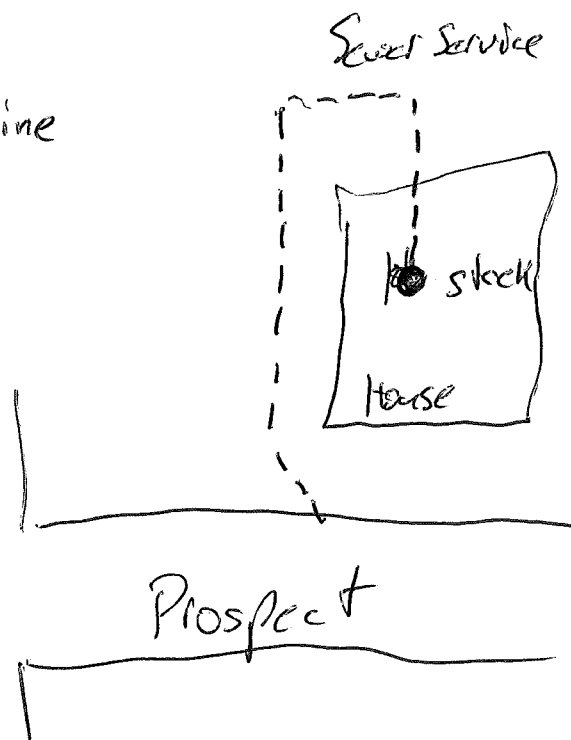
Inspectors Signature:	<i>[Signature]</i>	Date:	7-18-22
Owners Signature:		Date:	

City Review	
<input checked="" type="checkbox"/> Compliant	<input type="checkbox"/> Corrective Action Required
Certificate of Compliance Expires: 7/18/2032	Corrective Action Due by:
Date: 7/18/22	Signature: <i>[Signature]</i>
	Name: Kellie Hoern

Service Line Inspection Details

Weather Conditions:	
Approximate Depth of Service	
Type and Size of Service	
Overall Condition of Service Pipe	

Please note all connections, fittings, points of concern on service line including infiltration, tree root, cracks, misaligned joints, etc.
This report must include a digital copy of the televising.

Feet	Comment
Example: 0 1-10	Start for 4" cleanout in NE corner of Basement Misaligned joint - Infiltration
0 120.5h	<p>stock crawl space house</p> <p>main</p> <p>4" Lined Service Line</p> <p>Sewer Service</p>  <p>Prospect</p>
Notes:	<p>NO video, Plumber camera no video capability. Scott and Brian visually approve. Service line has new liner installed whole length of pipe to main.</p>