


PLAT OF SURVEY

FOR: **BLAKE BICHANICH**


PROPOSED HOUSE ON EXISTING SURVEY

SEE SITEPLAN FOR DRIVEWAY & WALK

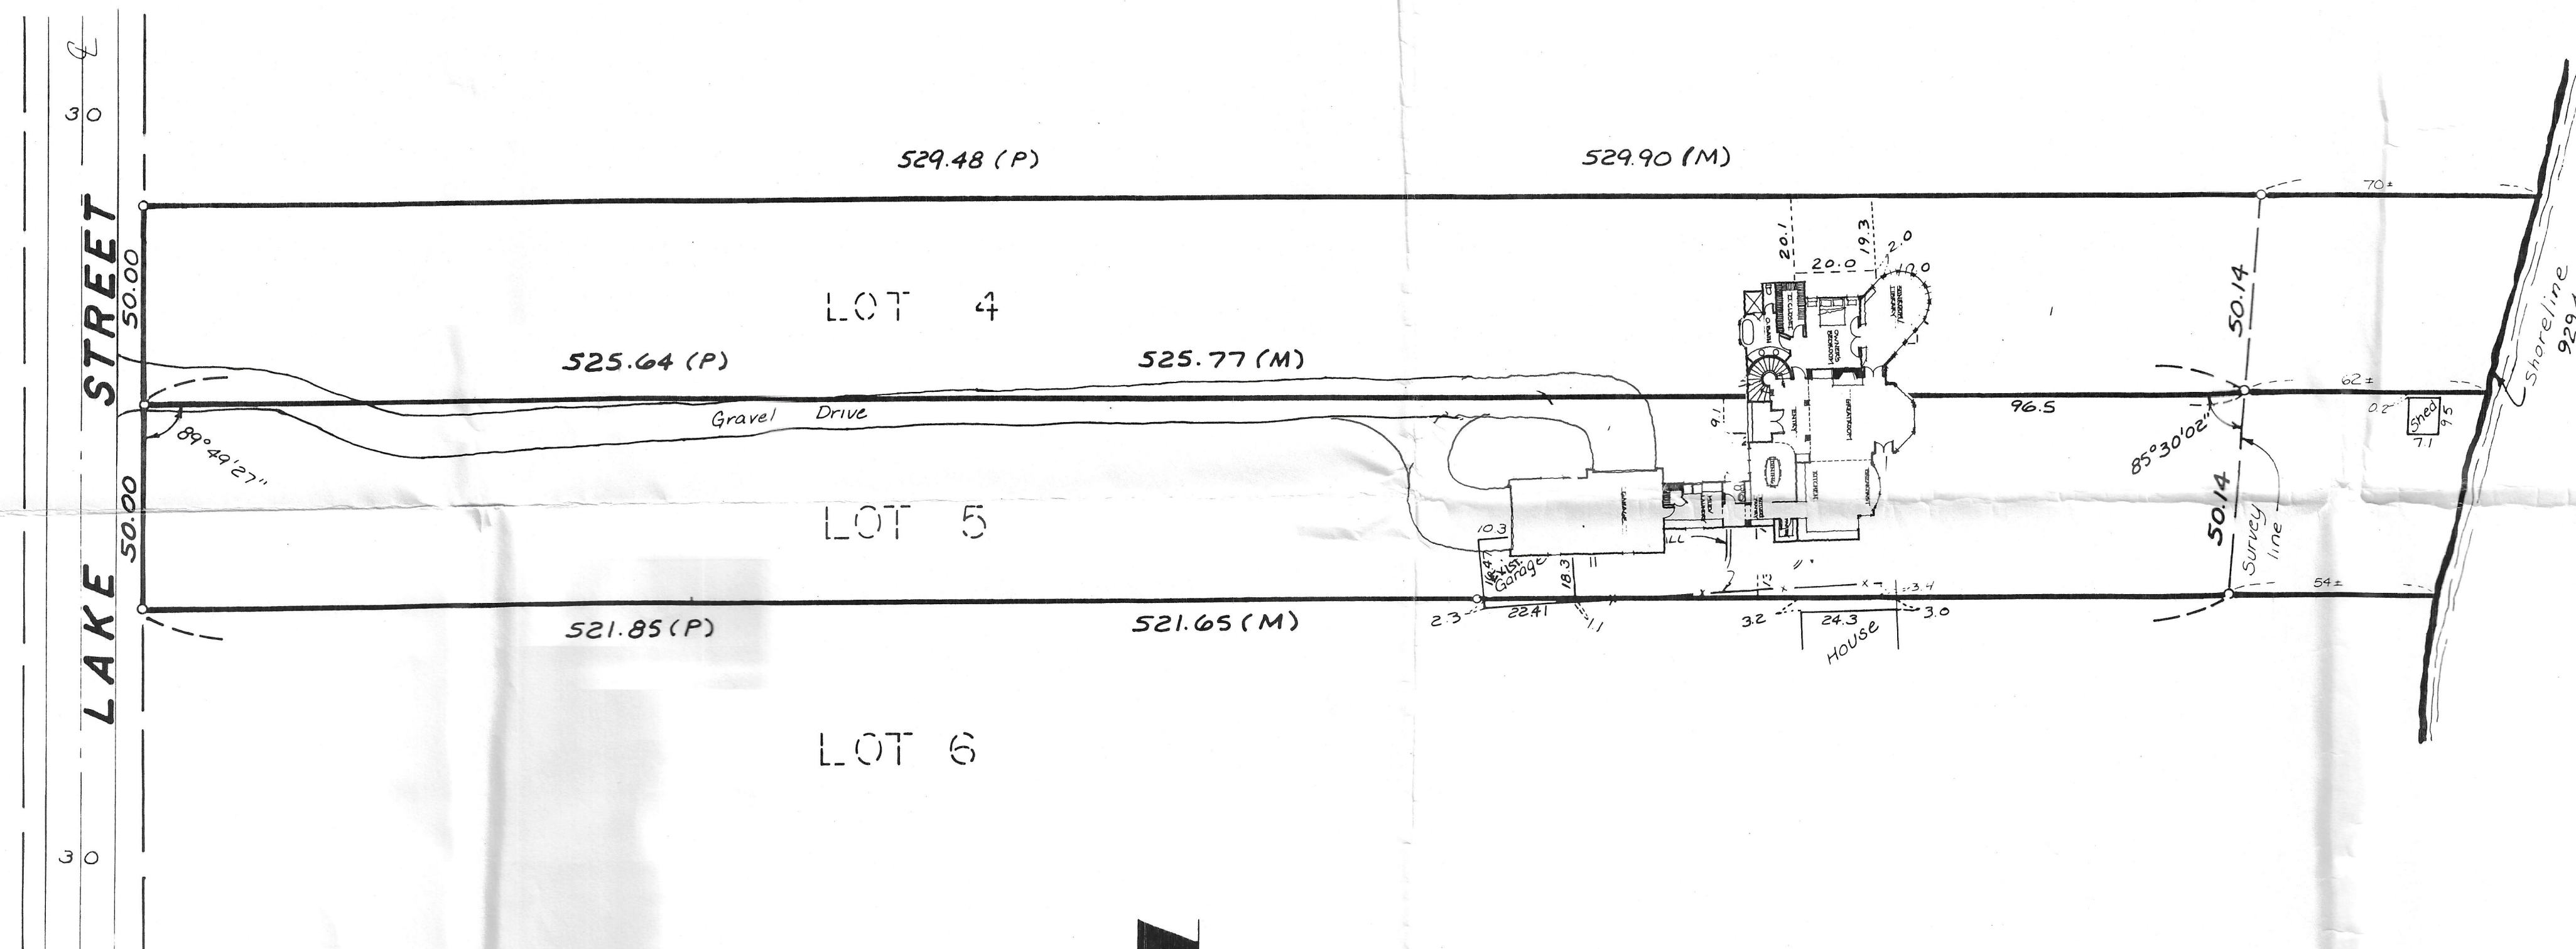

LAKE
MINNETONKA
(STUBBS BAY)

- LEGEND
- O IRON MONUMENT
 - (M) MEASURED DISTANCE
 - (P) DISTANCE PER PLAT

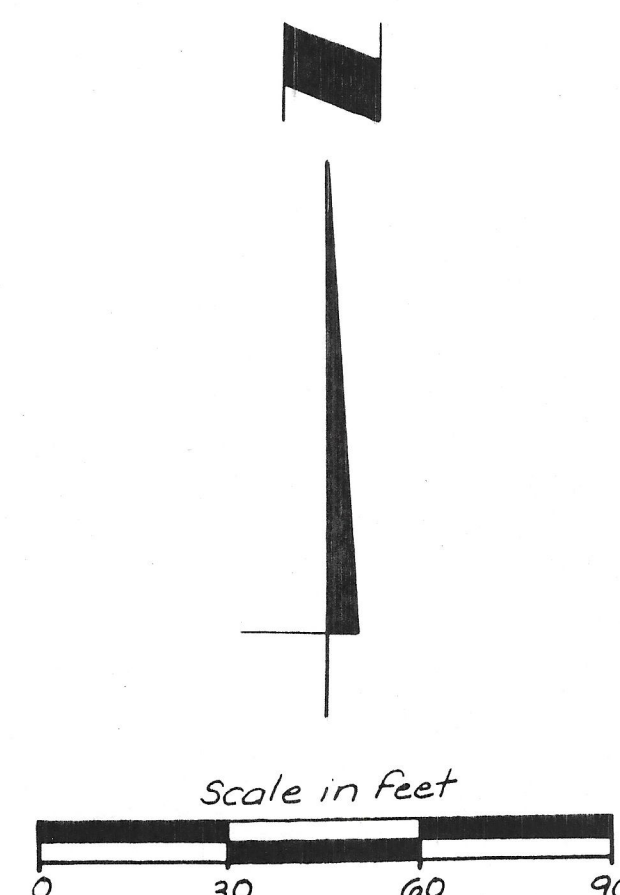

I hereby certify that this survey was prepared by me or under my supervision and that I am a duly registered land surveyor under Minnesota Statutes Section 326.02 to 326.16.

Lloyd E. Pew Registration No. 18721

Date: 3-24-89

LEGAL DESCRIPTION:
LOTS 4 & 5, BLOCK 1, HILLSIDE PARK
HENNEPIN COUNTY, MINNESOTA

Revised 5-4-93 Proposed Addition
Revised 12-11-92 TO SHOW NEW SHORELINE
Revised 8-30-89 To show Lot 4


#2859

**Hansen Thorp
Pellinen Olson Inc.**
Consulting Engineers & Land Surveyors
7585 Office Ridge Circle
Eden Prairie, MN 55344-3844
(612) 828-0700

DRAWN	CHECKED
BH	LEP
DATE	8-24-89
JOB NO.	89-157
BK-PC	49-58
DRAWING NO.	C-674

PLAT OF SURVEY

FOR: BLAKE BICHANICH

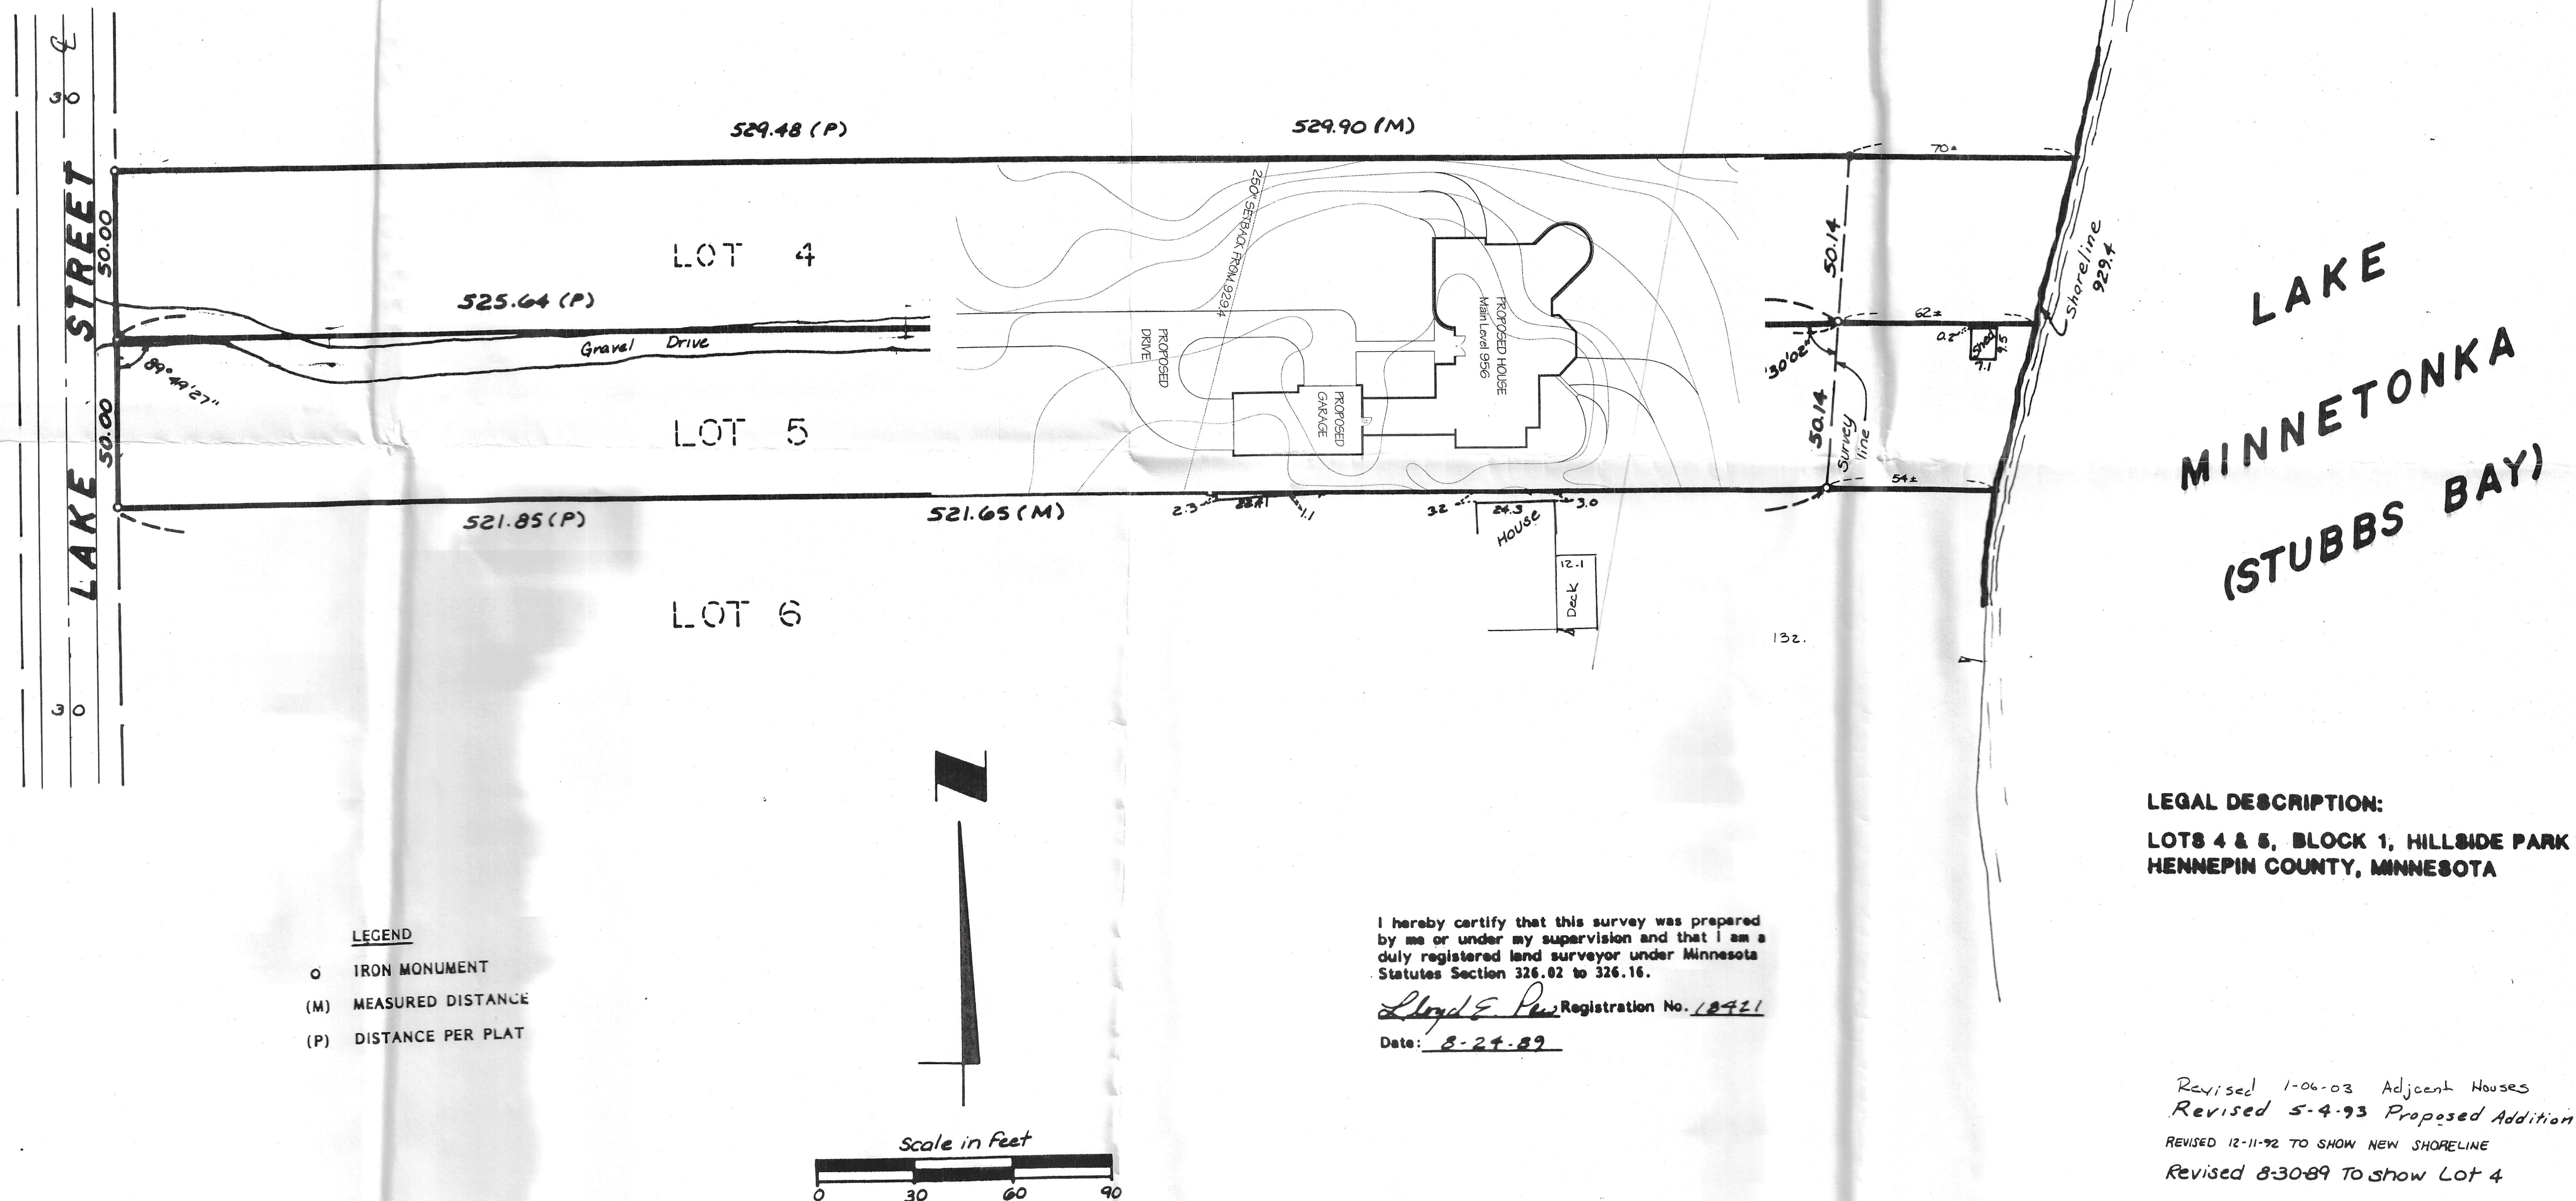

HT 30	Hansen Thorp Pettinen Olson Inc.	
	Consulting Engineers & Land Surveyors	
	7000 Office Ridge Circle	
	Eden Prairie, MN 55344-2044	
	(612) 938-0700	
DRAWN DATE	CHECKED DATE	
BH	WEP	
8-24-89		
JOB NO.		
89-157		
SK-PC		
49-58		
DRAWING NO.		
C-674		