
	CITY OF ORONO INSPECTION NOTICE PERMIT NO. SYVP22.000	046 WOOD	CALLED IN SCHEDULED COMPLETED ROAD	6/2	8 122 30/22	10:30 AM
	7.55.1200	VVVV			1012 1	144 2152
	OWNERTELEPHONE NO. 412 444 3153					
	CONTRACTOR TUTTES LUMB COPP					
CODE REQUIREMENTS ARE FOR YOUR PERSONAL HEALTH AND SAFETY!	DESCRIPTION DISCONNECT (SEWER & MUSTER) INSPECTION					
	FOOTING POURED WALL FOUNDATION DRAIN TILE LATHE FRAMING INSULATION FINAL AS BUILT - SURVEY DEMO - SITE OWNER/CONTRACTOR TO MEET YOU WAS ALL WA	PLUM PLUM MECH MECH WOOI WATE	to puc disconnected			
	(Sarahan) (S		- Hum	- OF		
CODE REQUI	WORK SATISFACTORY: PROCEE □ CORRECT WORK & PROCEED □ CORRECT WORK, CALL FOR RE BEFORE COVERING □ CORRECT UNSAFE CONDITION INSPECTOR WILL RETURN □ STOP ORDER POSTED. CALL IN: □ INSPECTION REQUIRED. CALL I	INSPECTION WITHIN SPECTOR TO ARRANG	HOURS.	□ ISSUE	TEMPOR PERMAN O TAKEN ON ISSUED	E OF OCCUPANCY RARY NENT
	Call for the next inspection 24 hours in advance. (952) 249-4600 Owner/Contractor on site:					
	Inspector:	Kaje				

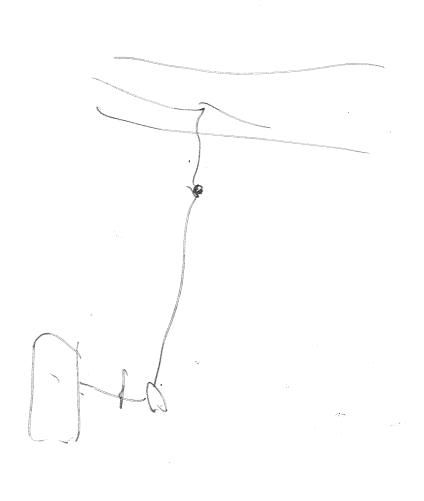

4.