

CITY OF ORONO  
INSPECTION NOTICEPERMIT NO. SWP22-000096CALLED IN  
SCHEDULED  
COMPLETED

DATE

TIME

ADDRESS 1395 Orono Lane

OWNER

TELEPHONE NO.

CONTRACTOR


JS Stewart

## DESCRIPTION

- |  |  |  |
|--|--|--|
| <input type="checkbox"/> FOOTING               | <input type="checkbox"/> DEMO - FINAL          | <input type="checkbox"/> SEPTIC FINAL          |
| <input type="checkbox"/> POURED WALL           | <input type="checkbox"/> PLUMBING RI           | <input type="checkbox"/> EXCAV/GRADING/FILLING |
| <input type="checkbox"/> FOUNDATION DRAIN TILE | <input type="checkbox"/> PLUMBING FINAL        | <input type="checkbox"/> TREE REMOVAL          |
| <input type="checkbox"/> LATHE                 | <input type="checkbox"/> MECHANICAL RI         | <input type="checkbox"/> SITE INSPECTION       |
| <input type="checkbox"/> FRAMING               | <input type="checkbox"/> MECHANICAL FINAL      | <input type="checkbox"/> RATED WALLS           |
| <input type="checkbox"/> INSULATION            | <input type="checkbox"/> WOOD BURNER/FIREPLACE | <input type="checkbox"/> COMPLAINT             |
| <input type="checkbox"/> FINAL                 | <input type="checkbox"/> WATER HOOK-UP         | <input type="checkbox"/> FOLLOW-UP             |
| <input type="checkbox"/> AS BUILT - SURVEY     | <input type="checkbox"/> SEWER HOOK-UP         | <input type="checkbox"/> FOUNDATION/REMOVAL    |
| <input type="checkbox"/> DEMO - SITE           | <input type="checkbox"/> SEPTIC INSTALL        |  |

OWNER/CONTRACTOR TO MEET YOU: YES NO

COMMENTS: Boat house 2" line hooked into house  
service at NE corner + bored 100' + hooked up  
2 Cleanouts - 1 to home + 1 to street.  
Sch 40 from Cleanout to stub. Stub  
is 3' deep + covered with insulation to  
Cleanouts.

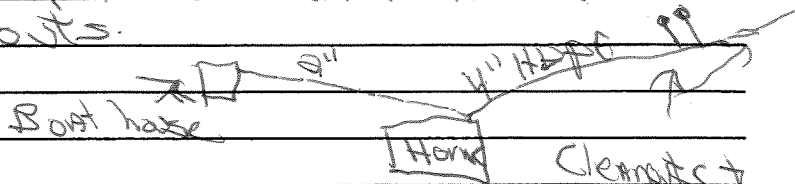

- |   |   |
|---|---|
| <input checked="" type="checkbox"/> WORK SATISFACTORY: PROCEED                              | <input checked="" type="checkbox"/> PROJECT COMPLETE <u>Sch 40-4"</u> |
| <input type="checkbox"/> CORRECT WORK & PROCEED   | <input type="checkbox"/> ISSUE CERTIFICATE OF OCCUPANCY               |
| <input type="checkbox"/> CORRECT WORK, CALL FOR REINSPECTION BEFORE COVERING                | <u>TEMPORARY</u>  |
| <input type="checkbox"/> CORRECT UNSAFE CONDITION WITHIN _____ HOURS. INSPECTOR WILL RETURN | <u>PERMANENT</u>  |
| <input type="checkbox"/> STOP ORDER POSTED. CALL INSPECTOR                                  | <input checked="" type="checkbox"/> PHOTO TAKEN                       |
| <input type="checkbox"/> INSPECTION REQUIRED. CALL TO ARRANGE ACCESS.                       | <input type="checkbox"/> CITATION ISSUED                              |

Call for the next inspection 24 hours in advance. (952) 249-4600

Owner/Contractor on site: JS StewartInspector: JGH