

CITY OF ORONO  
INSPECTION NOTICE

PERMIT NO. SNP24-000040

DATE 6/18 TIME 2:00 PM  
CALLED IN 6/20/24  
SCHEDULED 6/20/24  
COMPLETED

ADDRESS 126 Cherry Chase Drive

OWNER \_\_\_\_\_ TELEPHONE NO. \_\_\_\_\_


CONTRACTOR Roto Rooter

DESCRIPTION Sewer Repair

- FOOTING
- POURED WALL
- FOUNDATION DRAIN TILE
- LATHE
- FRAMING
- INSULATION
- FINAL
- AS BUILT - SURVEY
- DEMO - SITE
- DEMO - FINAL
- PLUMBING RI
- PLUMBING FINAL
- MECHANICAL RI
- MECHANICAL FINAL
- WOOD BURNER/FIREPLACE
- WATER HOOK-UP
- SEWER HOOK-UP
- SEPTIC INSTALL
- SEPTIC FINAL
- EXCAV/GRADING/FILLING
- TREE REMOVAL
- SITE INSPECTION
- RATED WALLS
- COMPLAINT
- FOLLOW-UP
- FOUNDATION/REMOVAL

OWNER/CONTRACTOR TO MEET YOU: \_\_\_ YES \_\_\_ NO

COMMENTS: Roto Rooter did a 6' repair out from  
walkout ~~door~~ doors Added 3 cleanouts

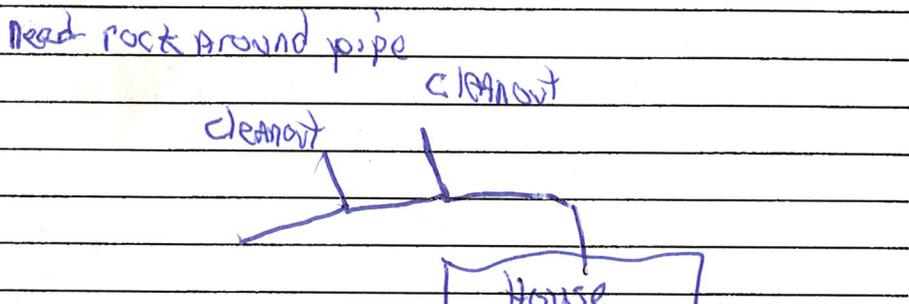

CODE REQUIREMENTS ARE FOR YOUR PERSONAL HEALTH AND SAFETY!

- WORK SATISFACTORY: PROCEED
- CORRECT WORK & PROCEED
- CORRECT WORK, CALL FOR REINSPECTION BEFORE COVERING
- CORRECT UNSAFE CONDITION WITHIN \_\_\_\_\_ HOURS. INSPECTOR WILL RETURN
- STOP ORDER POSTED. CALL INSPECTOR
- INSPECTION REQUIRED. CALL TO ARRANGE ACCESS.
- PROJECT COMPLETE
- ISSUE CERTIFICATE OF OCCUPANCY \_\_\_\_\_ TEMPORARY \_\_\_\_\_ PERMANENT
- PHOTO TAKEN
- CITATION ISSUED

Call for the next inspection 24 hours in advance. (952) 249-4600

Owner/Contractor on site: \_\_\_\_\_

Inspector: Scott