


Encroachment Exhibit

PREPARED FOR: Mr. Peter Lanpher

Rest Point Road

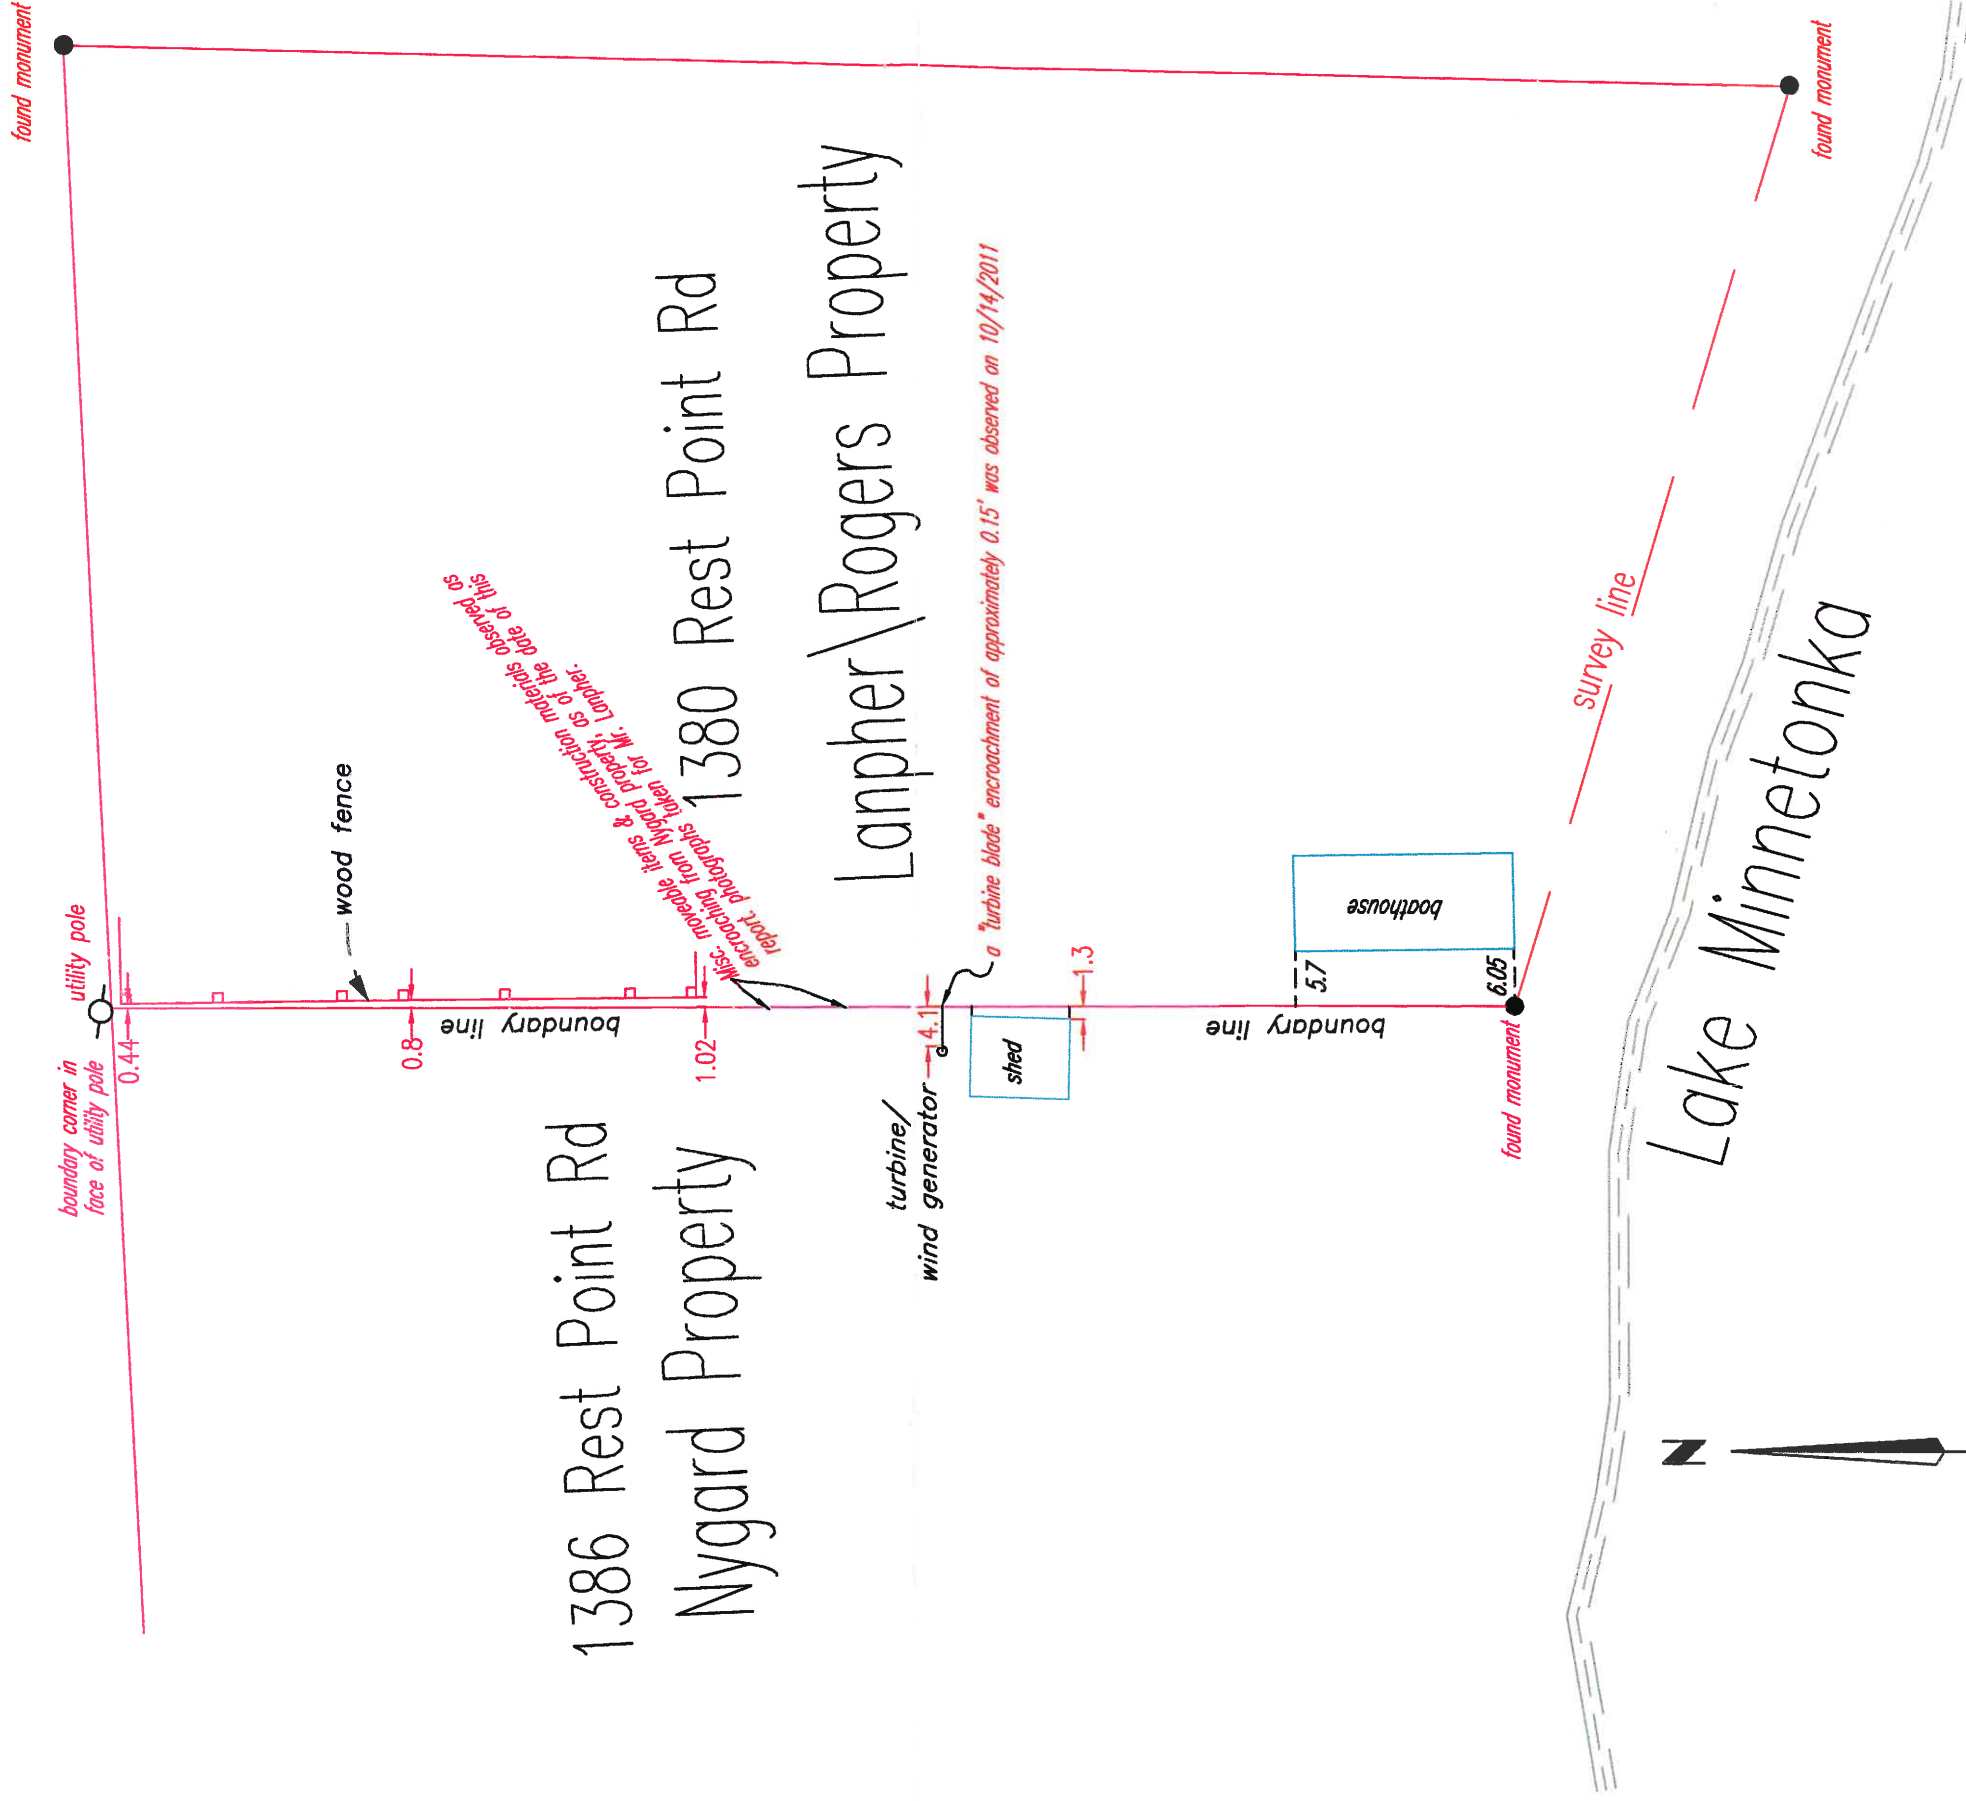

PROPERTY DESCRIPTION:

Lot 6 and the westerly 40.00 feet of Lot 7, Subdivision of Lot 14, REST POINT PARK, Hennepin County, Minnesota

DEMARS-GABRIEL
LAND SURVEYORS, INC.
6875 Washington Ave, So.
Suite 209
Edina, MN 55439
Phone: (952) 767-0487
Fax: (952) 767-0490

I hereby certify that this survey, plan or report was prepared by me or under my direct supervision and that I am a duly Registered Land Surveyor under the Laws of the State of Minnesota.

David E. Crook

David E. Crook
Date: 10/14/11

Minn. Reg. No. 22414

13949

Book-Page

Scale
1"=20'