


CERTIFICATE OF SURVEY FOR
STEVE ERICKSON
OF LOT 104, AUD. SUB. NO. 184
HENNEPIN COUNTY, MINNESOTA

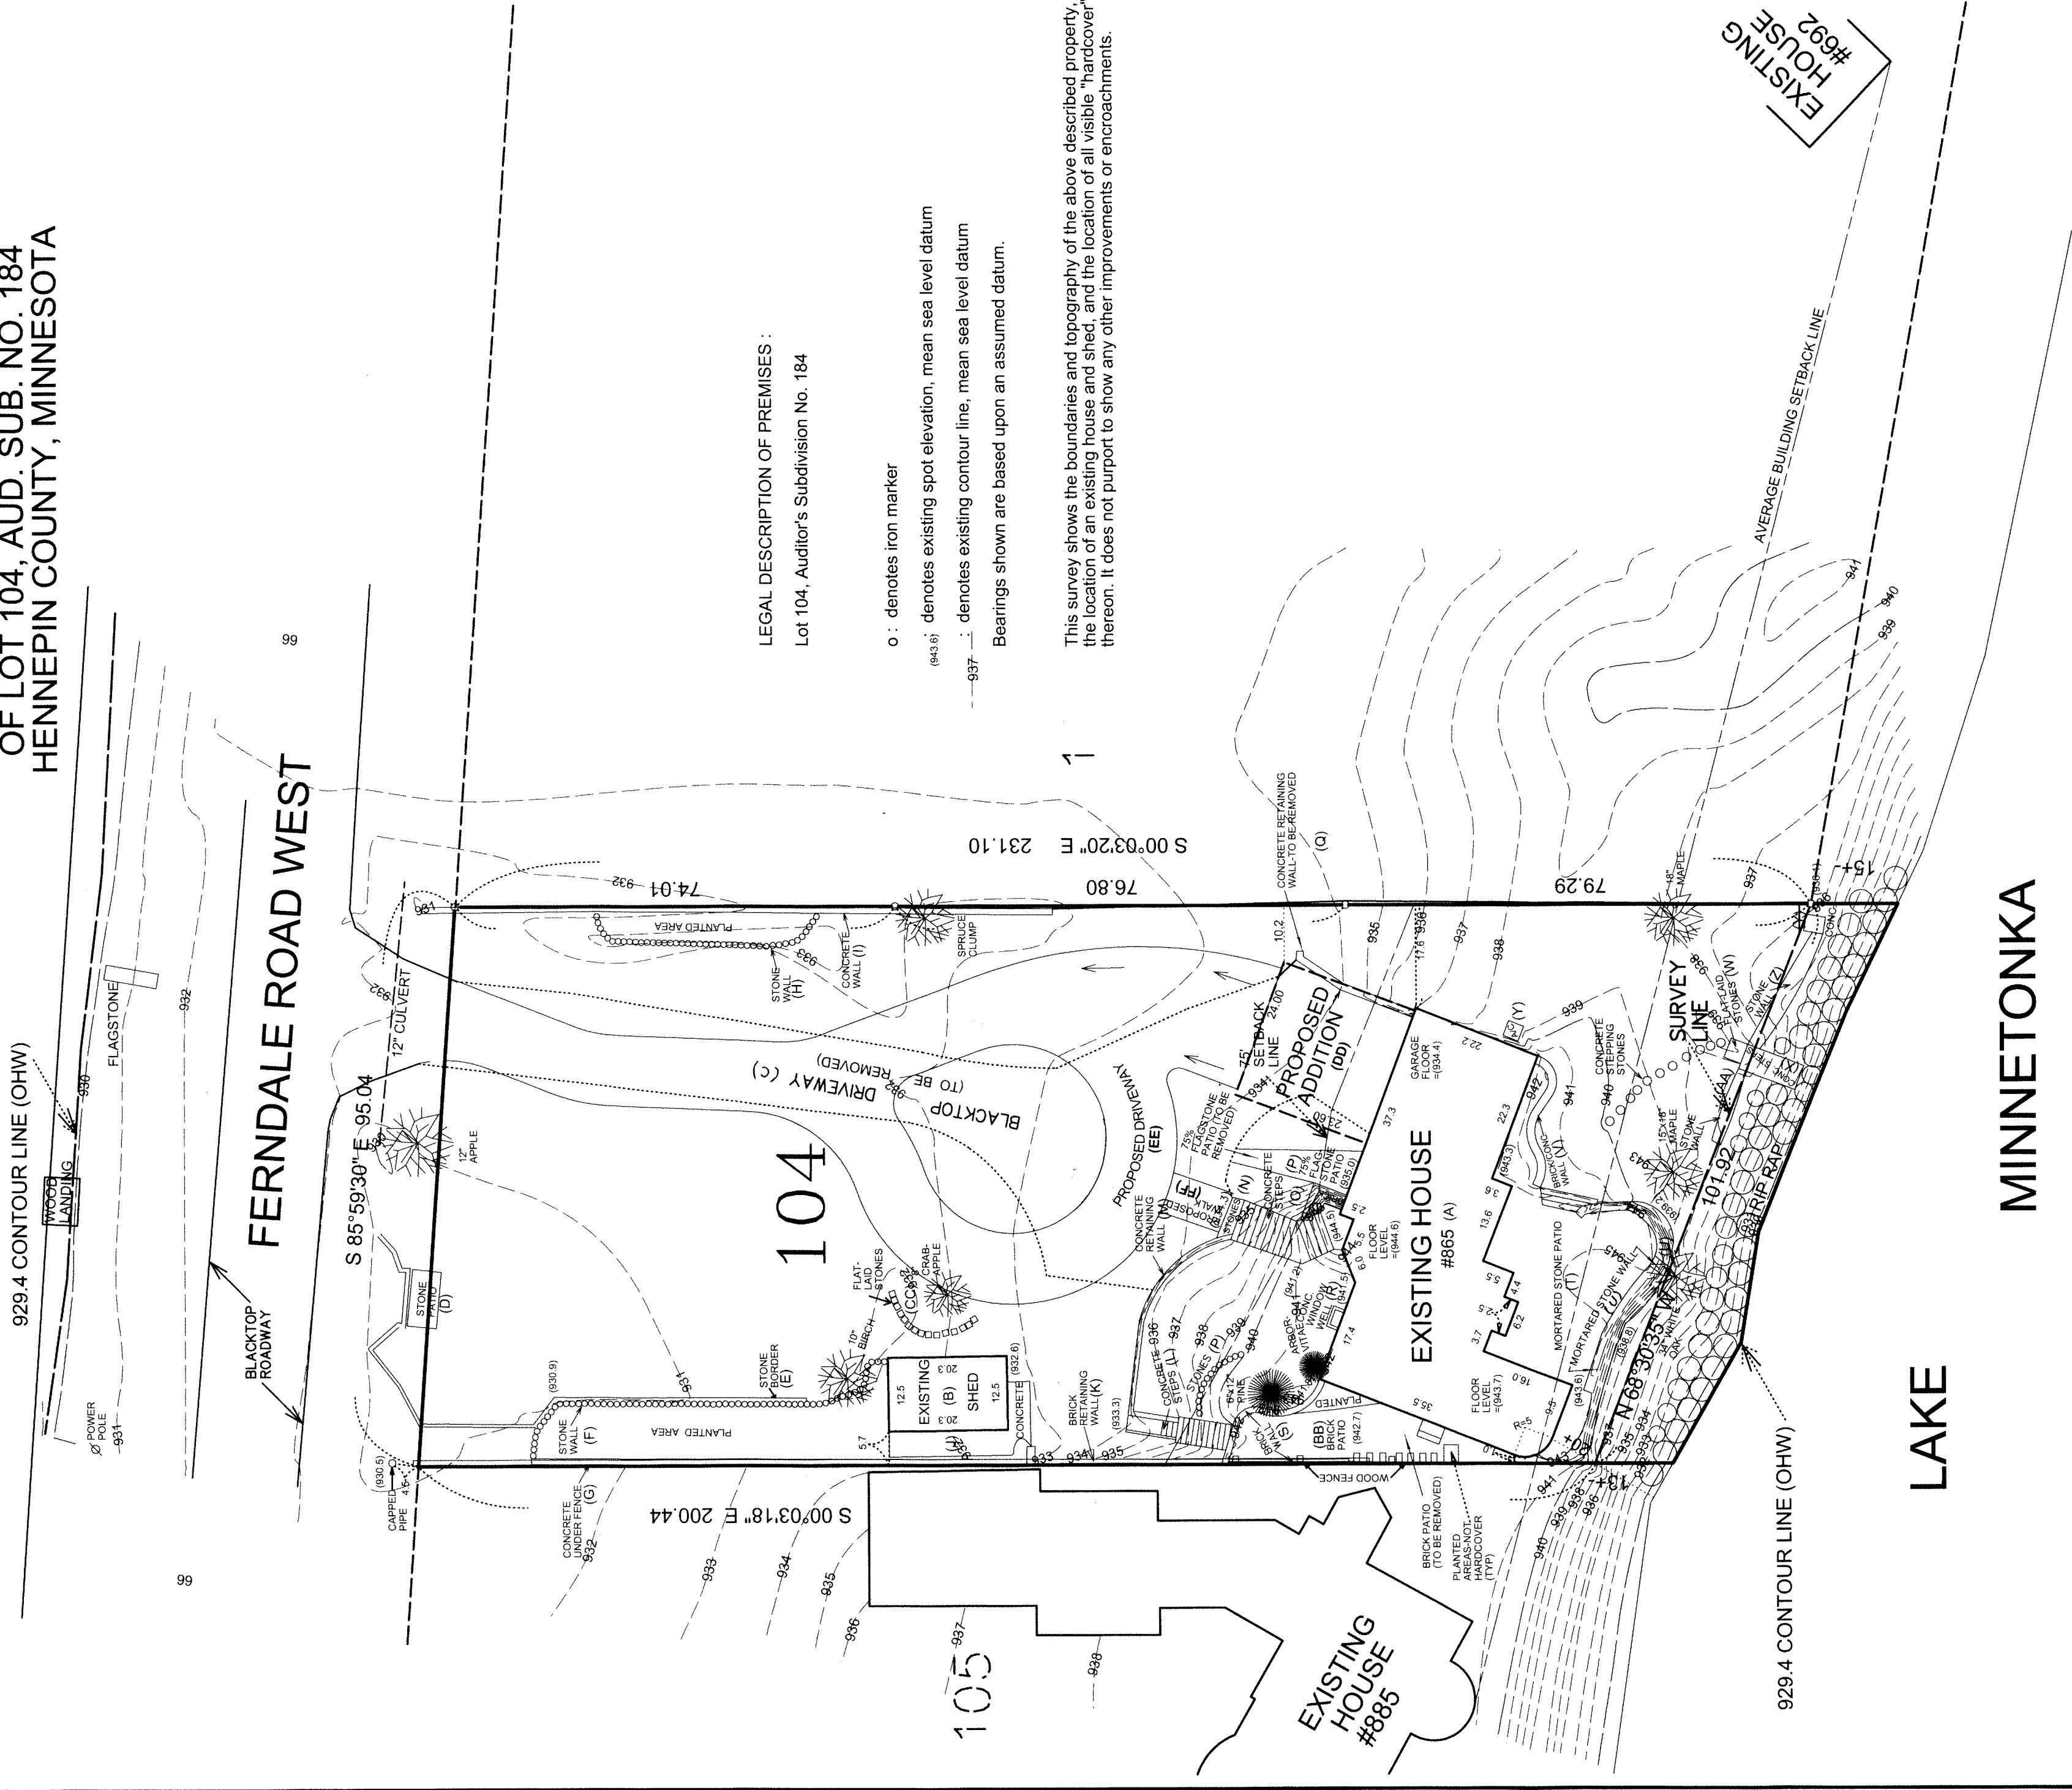

LEGAL DESCRIPTION OF PREMISES :
Lot 104, Auditor's Subdivision No. 184

- o : denotes iron marker
(943.6) : denotes existing spot elevation, mean sea level datum
-937 : denotes existing contour line, mean sea level datum
Bearings shown are based upon an assumed datum.

This survey shows the boundaries and topography of the above described property, the location of an existing house and shed, and the location of all visible "hardcover" thereon. It does not purport to show any other improvements or encroachments.

DESIGNED	REVISION	DATE	DESCRIPTION
	1	6-20-16	
DRAWN			
CHECKED			

GRONBERG & ASSOCIATES, INC.
CONSULTING ENGINEERS, LAND SURVEYORS
SITE PLANNERS
445 N. WILLOW DR. LONG LAKE, MN. 55356
952-473-4141

I hereby certify that this plan, specification, or report was prepared by me or under my direct supervision and that I am a duly Licensed Land Surveyor under the laws of the State of Minnesota.

Mark A. Gronberg
DATE 6-20-16 MN LICENSE NUMBER 12755

SCALE
1"=20'
DATE
4-14-14
JOB NO.
16-206a