

SEPTIC SYSTEM INVENTORY

Site Address: 145 Brown Rd S

PID 03-117-23-21-0007

Owner Name: John M. Winton

Owner Address: 145 Brown Rd S Long Lake MN 55356-

BuildingType: residence

Installer: Ingleside Engr.

Date of Permit: 12/1 /99

System Type: trench

BR's Designed for 5

In Musa?: No

Shoreland?:

SEPTIC TANKS:

Material: precast concrete

Capacity: 1250, 1000, 1250

Tank Filter:

DRAINFIELD:

Treatment Area: 762

Soil Boring: yes

DF Ht above Wt: 3

WELL DATA

Setbacks - Well Tanks:

Well DF:

Report In File:


Depth:

INSPECTION RECORDS

Date	Notes
8/1/2006 OK	
6/16/2004 OK	
6/20/2002 no surfacing,need risers	
9/18/2000 no surfacing	
5/3/2000 final ok	
12/3/1999 installation	

PUMPOUT RECORDS

Date	GallonsOfLiquid
12/10/2015	3000
7/28/2014	3000
1/20/2012	4000
2/17/2009	4000
11/28/2008	4000
6/13/2006	2500

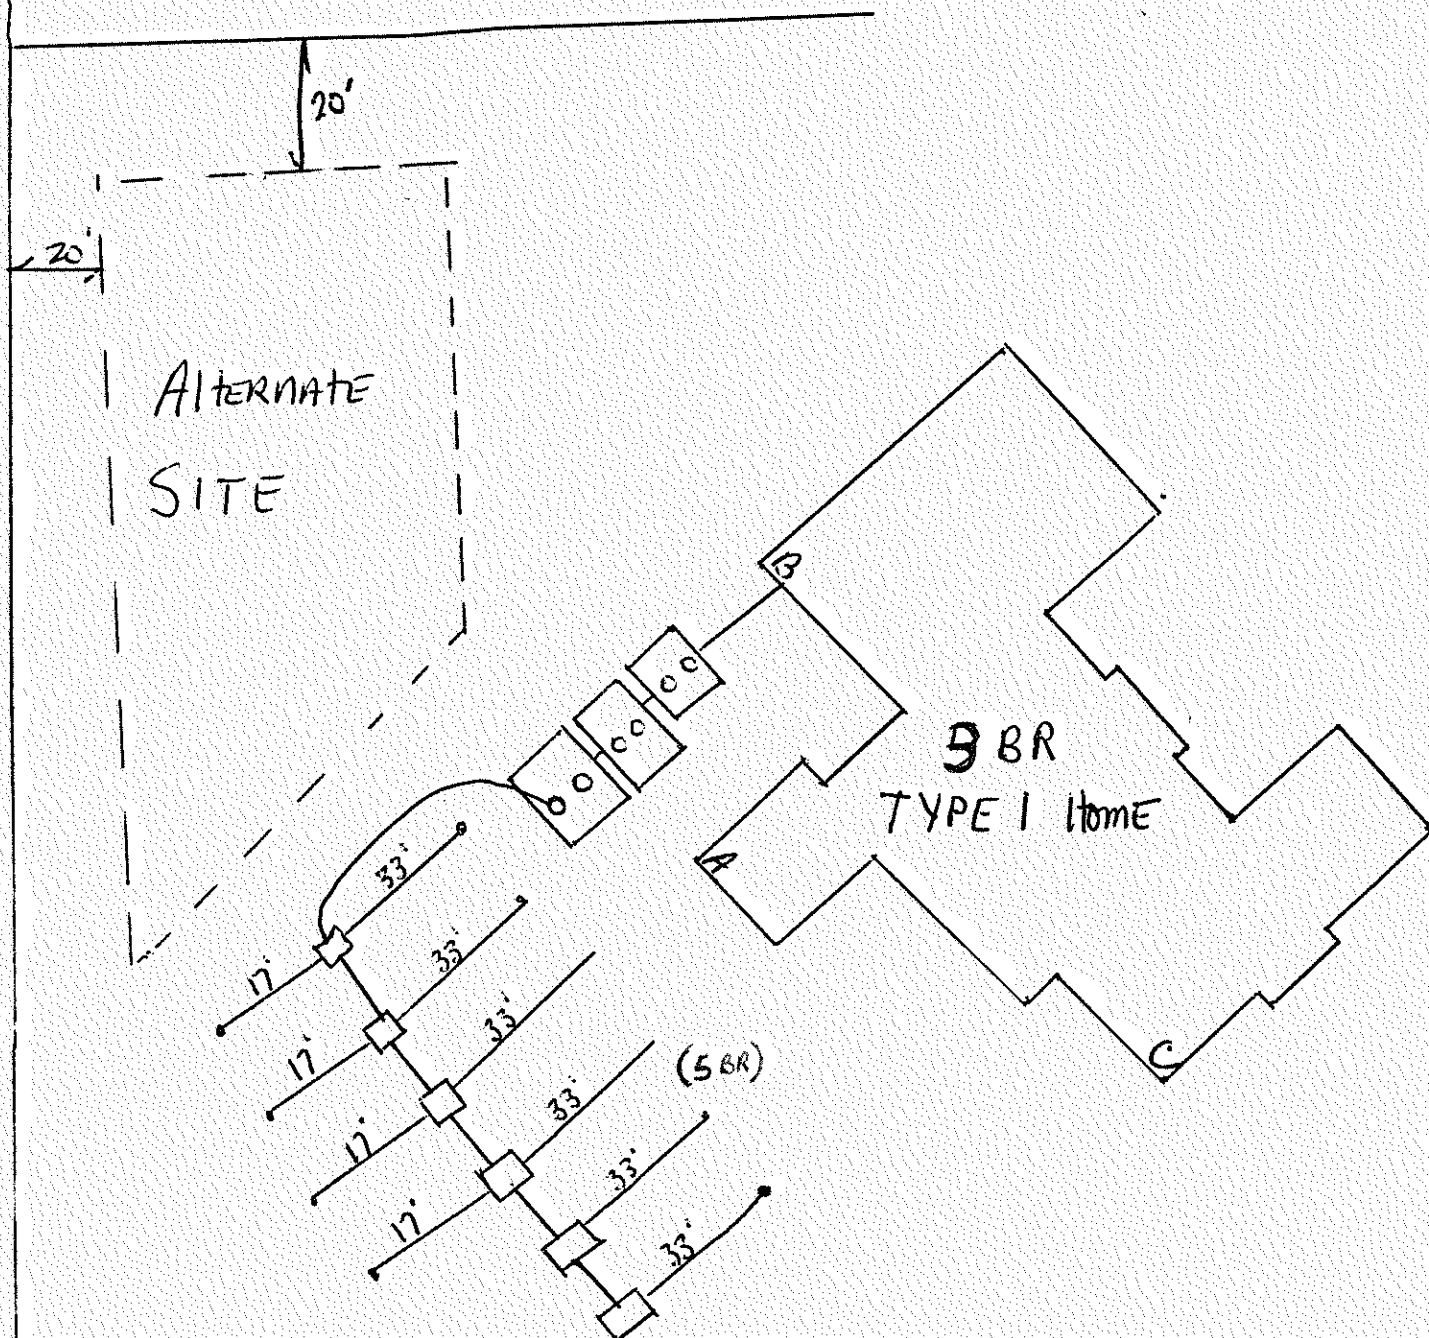

	A	B	C
T ₁	17'8"	23'7"	
T ₂	22'11"	30'10"	
T ₃	33'7"	45'0"	
DB ₁	56'1"		100'1"
DB ₂	55'0"		95'10"
DB ₃	54'10"		92'6"
DB ₄	55'9"		89'9"

	A	C
DB ₅	58'4"	86'1"
DB ₆	60'4"	83'0"