


Pool only others
Approved by others

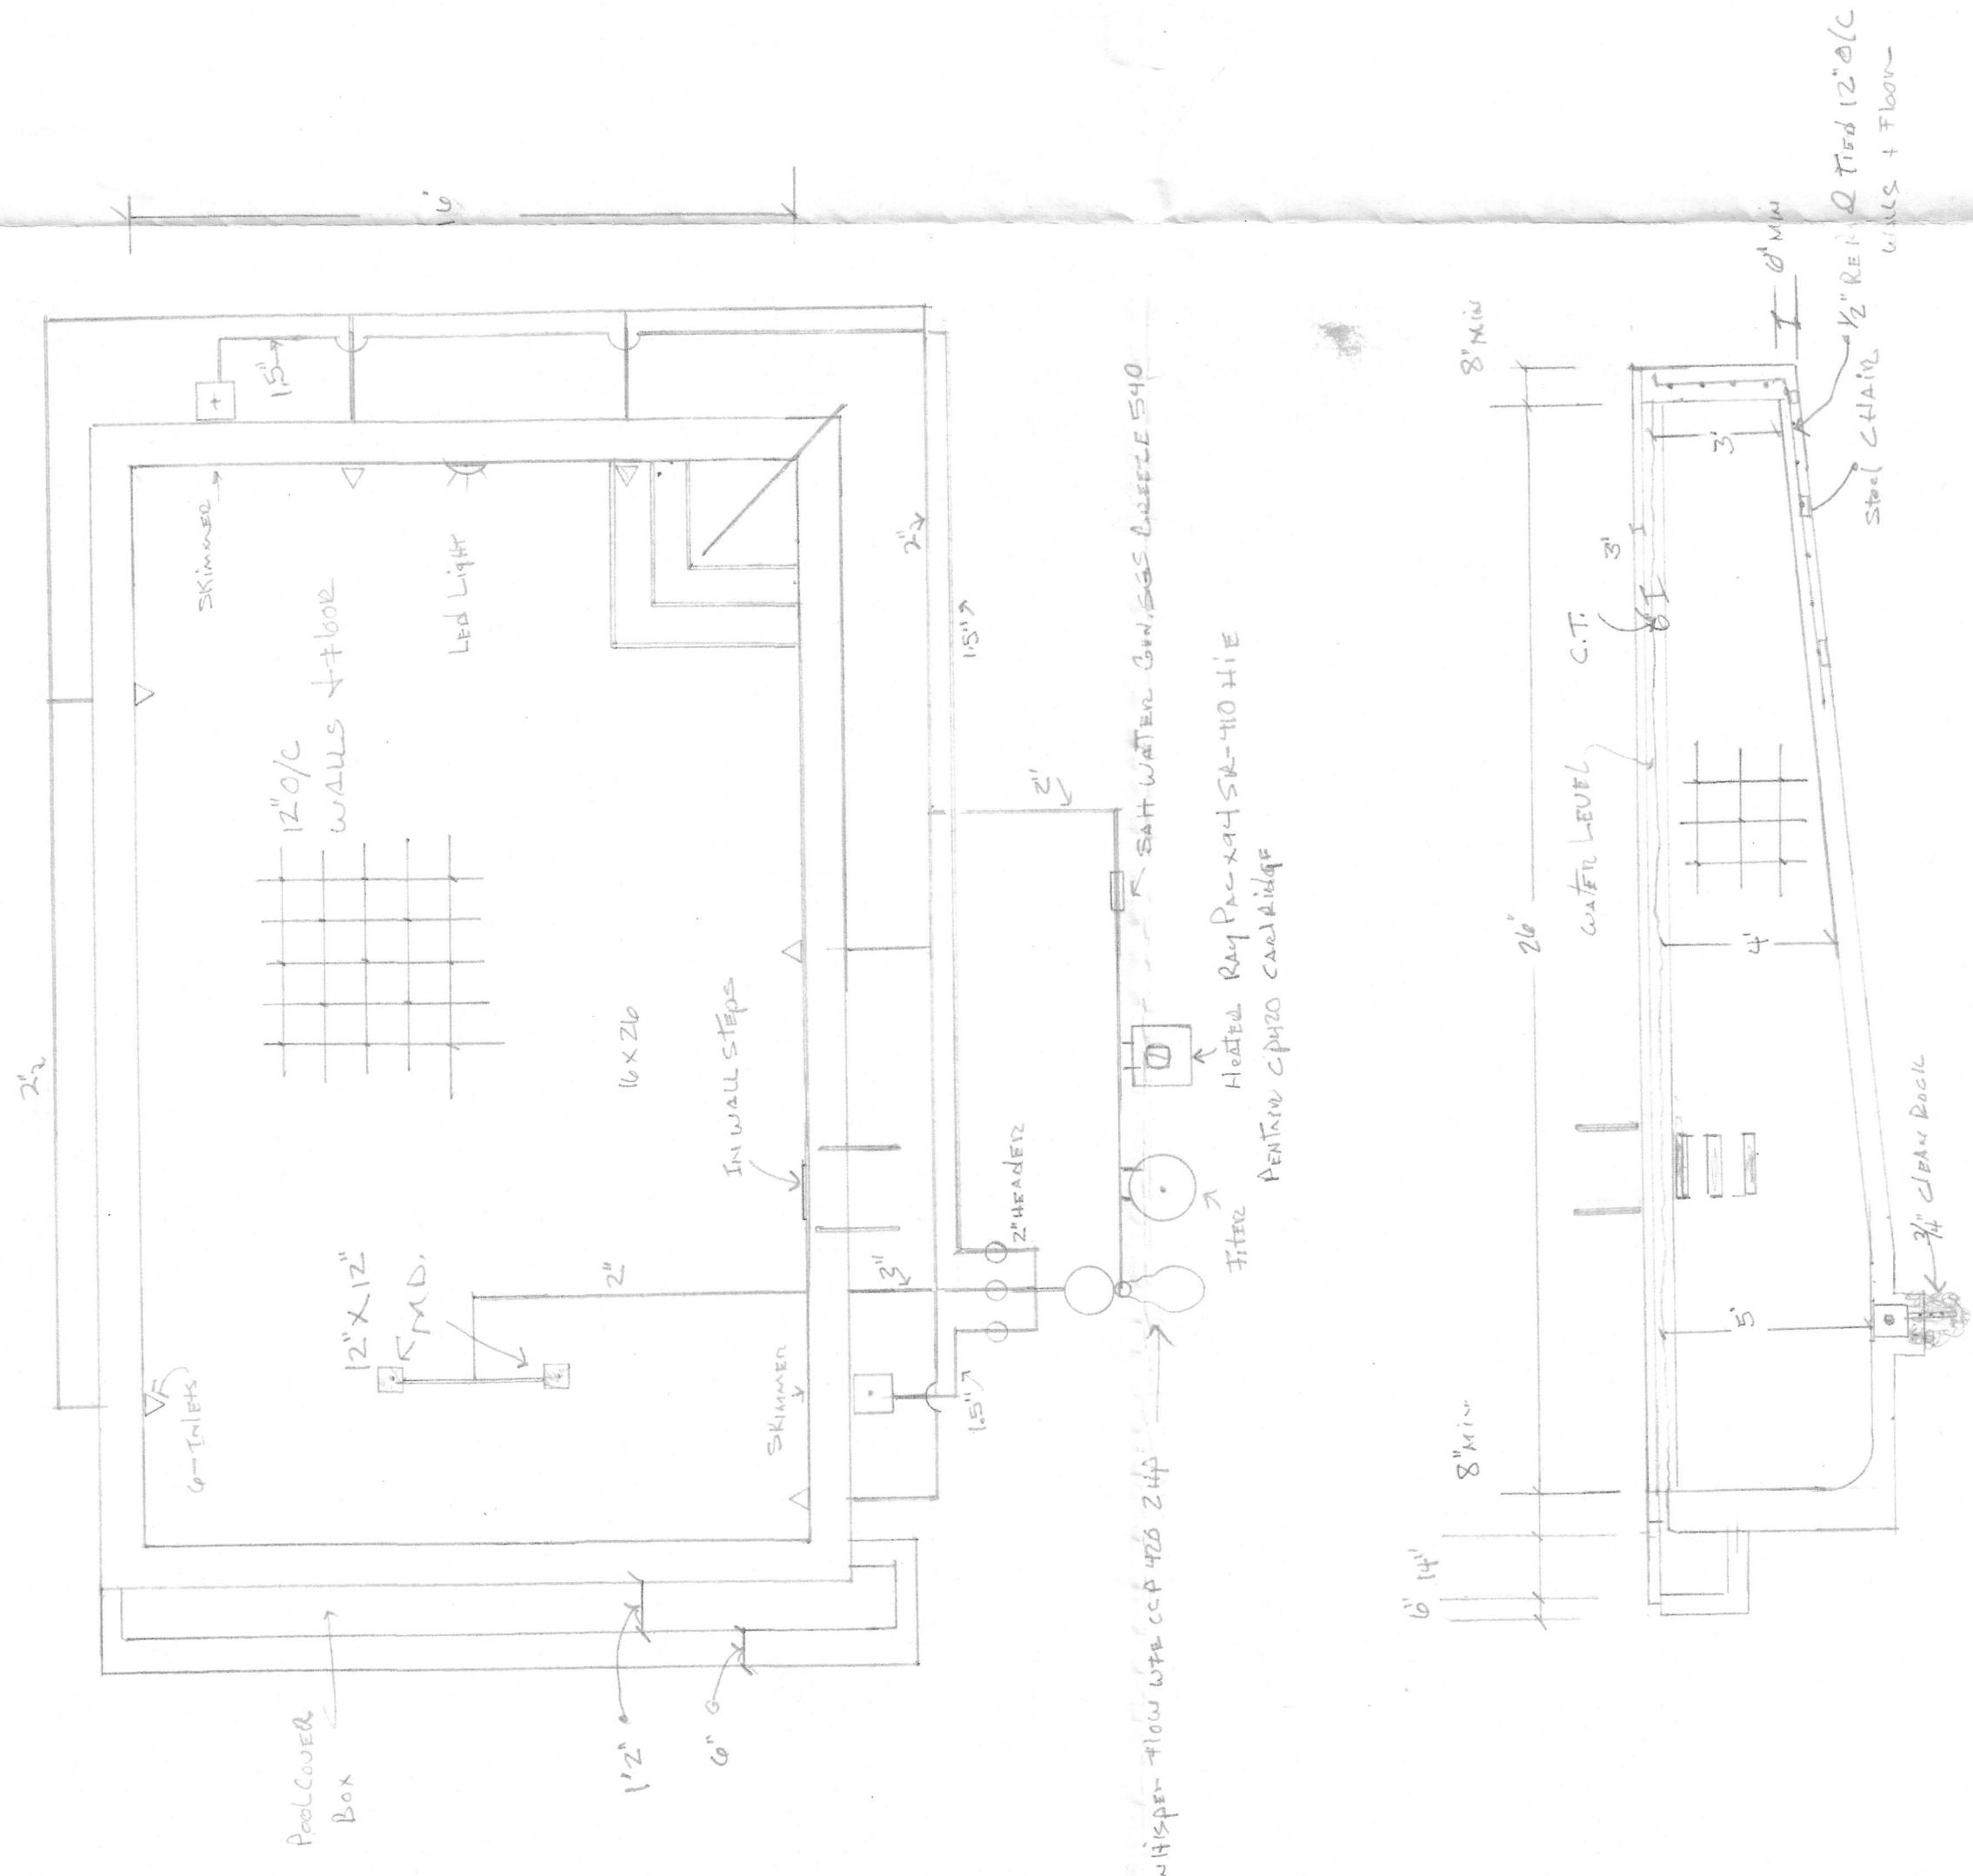

Reviewed for Code
Compliance City of Orono
Date 1/23/18
Reviewer Jason Park

Quality Pools, LLC - Ardy Neutz - 952-985-7665
Hemen Residence
June 20th, 2017
Page 2 of 4

ORONO CITY

Pool Data
Size: 16 x 26 with a 3' to 5' depth
Perimeter: 84 LF
Capacity in Gallons: 12,480
Turnover Rate: 35 GPM
Capacity: N/A

Pool Fittings
(2) Main Drain, 12" X 12" 4720 V Waterway
(2) Skimmer, 1082 Hayward
(6) Inlet Return Fittings, Hayward

Deck Equipment
(2) Handrail, 60" to 80" Stainless Steel SR Smith Custom
(4) Deck Anchors, HANA190B Bronze
(4) Escutcheons, SRSEP100F Stainless Steel
(1) Aqua-Matic Power Cover System - Under Deck Installation

Circulation Equipment
(1) Pentair Clean & Clear Plus CCP420 Cartridge Filter
(1) Filter Pump, Whisper-Flo WFE-8.2 H.P. Pentair
(1) RayPak Heater 266,000 BTU w/Power Vent (See Alternate #2 for upgrade option)
(1) Automatic Water Leveler Controller - Levelor K-1100
(1) Flowmeter 3" Check Valves FlowViz

Water Treatment System
(1) SGS Breeze 540 Salt System (See Alternate #3 for upgrade option)

Maintenance Equipment
(1) Pentair Easy Touch 4 Function 520591 (Option 520592 Includes Salt System - See Alternate #3)

(1) Water Chemistry Test Kit, HACH
(1) Dolphin Electronic Motorized Vacuum DX3 or similar
(1) Brush, 18" Floor & Wall Brush

Lighting Equipment
(1) Pentair IntelliBrite 5g White LED 100' to 200' Cord
(1) Deck Box/Junction Box (Depending On Location)

RECEIVED
JAN 16 2018
CITY OF ORONO
2018-00042

Hemen Res. 2625 KELLY AVE KELLY AVE	
ORONO, ME.	
SCALE:	APPROVED BY: A7
DATE:	REVISED:
Quality Pools 10250 Woodhill Blvd	
LAKESIDE 55044 952-985-7665	
DRAWING NUMBER	