


CERTIFICATE OF SURVEY FOR
CHRIS LAPPEN
 IN LOTS 1 & 2, BLOCK 8, BAYSIDE ADDITION TO LAKE MINNETONKA
 HENNEPIN COUNTY, MINNESOTA

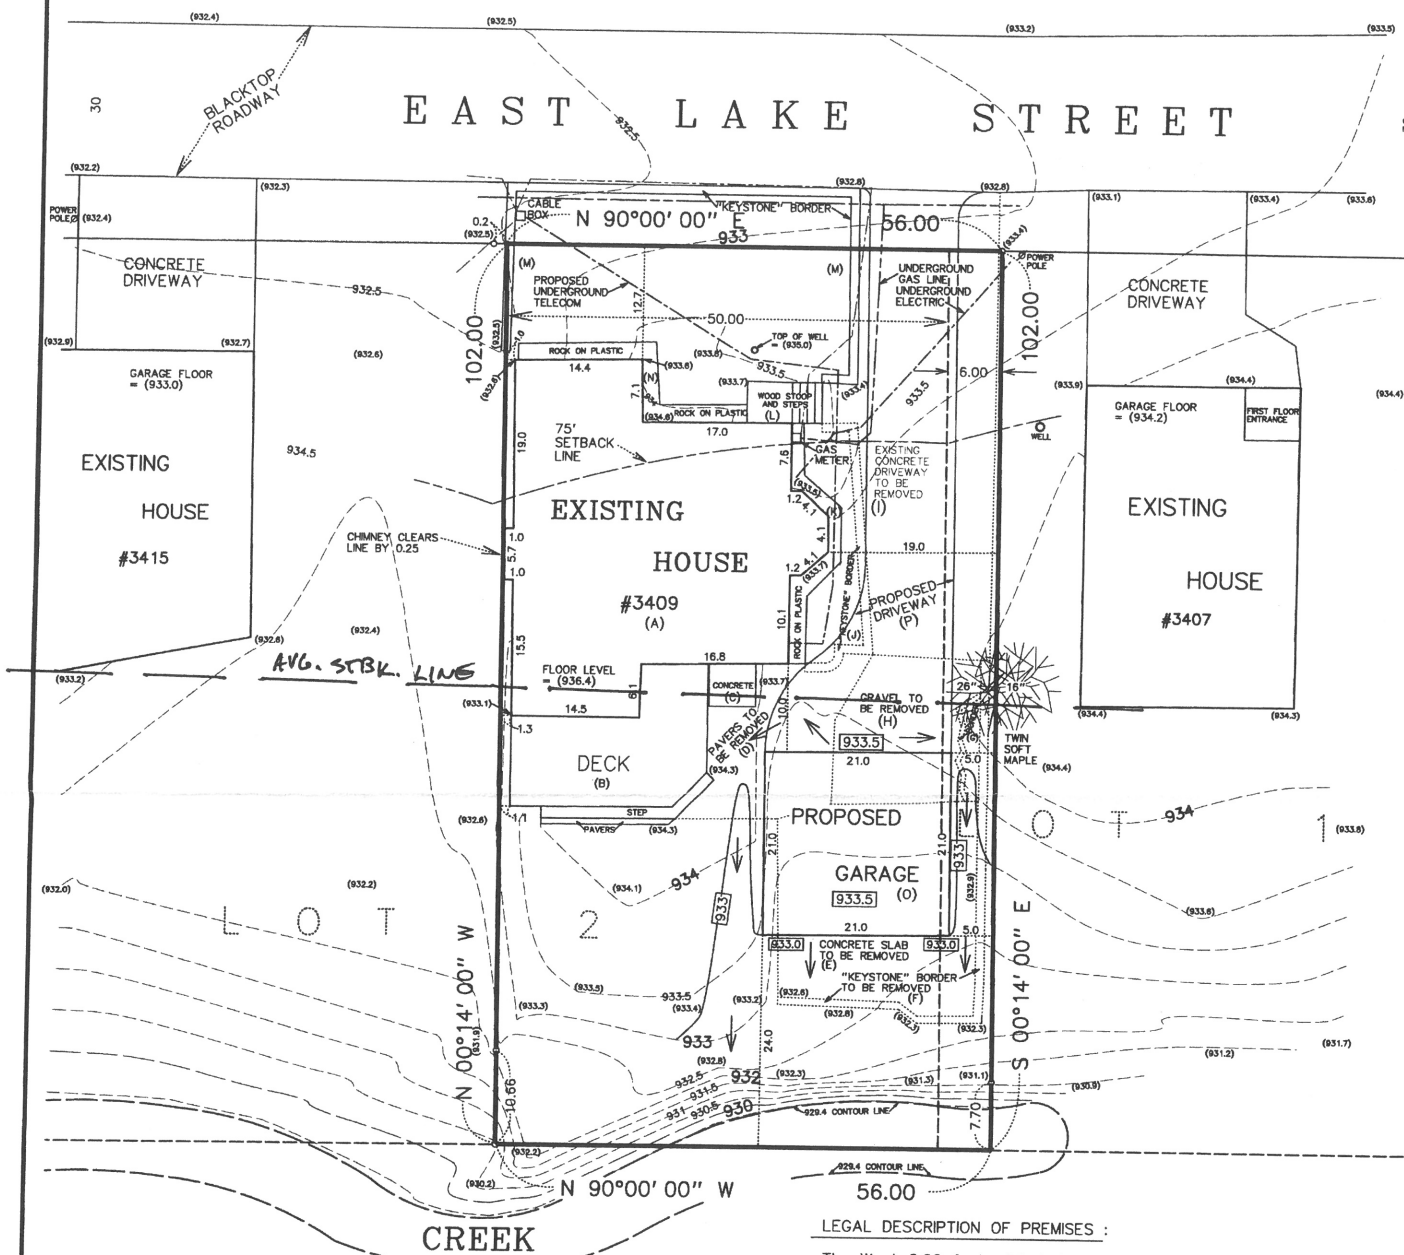

LEGAL DESCRIPTION OF PREMISES :

The West 6.00 feet of Lot 1, and the East 50.00 feet of Lot 2, Block 8, BAYSIDE ADDITION TO LAKE MINNETONKA.

- o : denotes iron marker
- (908.3) : denotes existing spot elevation, mean sea level datum
- [910.8] : denotes proposed spot elevation, mean sea level datum
- 917 — : denotes existing contour line, mean sea level datum
- 904 — : denotes proposed contour line, mean sea level datum

Bearings shown are based upon an assumed datum.

This survey intends to show the boundaries of the above described property, the location of an existing house, topography, twin soft maple tree, all visible "hardcover", and the proposed location of a proposed garage, driveway and grades thereon. It does not purport to show any other improvements or encroachments.

DATE	DESCRIPTION



GRONBERG AND ASSOCIATES, INC.
 CONSULTING ENGINEERS, LAND SURVEYORS, & SITE PLANNERS
 445 NORTH WILLOW DRIVE
 LONG LAKE, MN. 55356
 952-473-4141

I hereby certify that this plan, specification, or report was prepared by me, or under my direct supervision, and that I am a duly Licensed Land Surveyor under the laws of the State of Minnesota.

Mark S. Gronberg
 Mark S. Gronberg Minnesota License Number 12755

SCALE
 1"=10'
 DATE
 9-2-15
 JOB NO.
 15-348