CERTIFICATE OF SURVEY FOR
GORDON JAMES CONSTRUCTION
OF LOT 1, BLOCK 1, PINEVIEW
HENNEPIN COUNTY, MINNESOTA

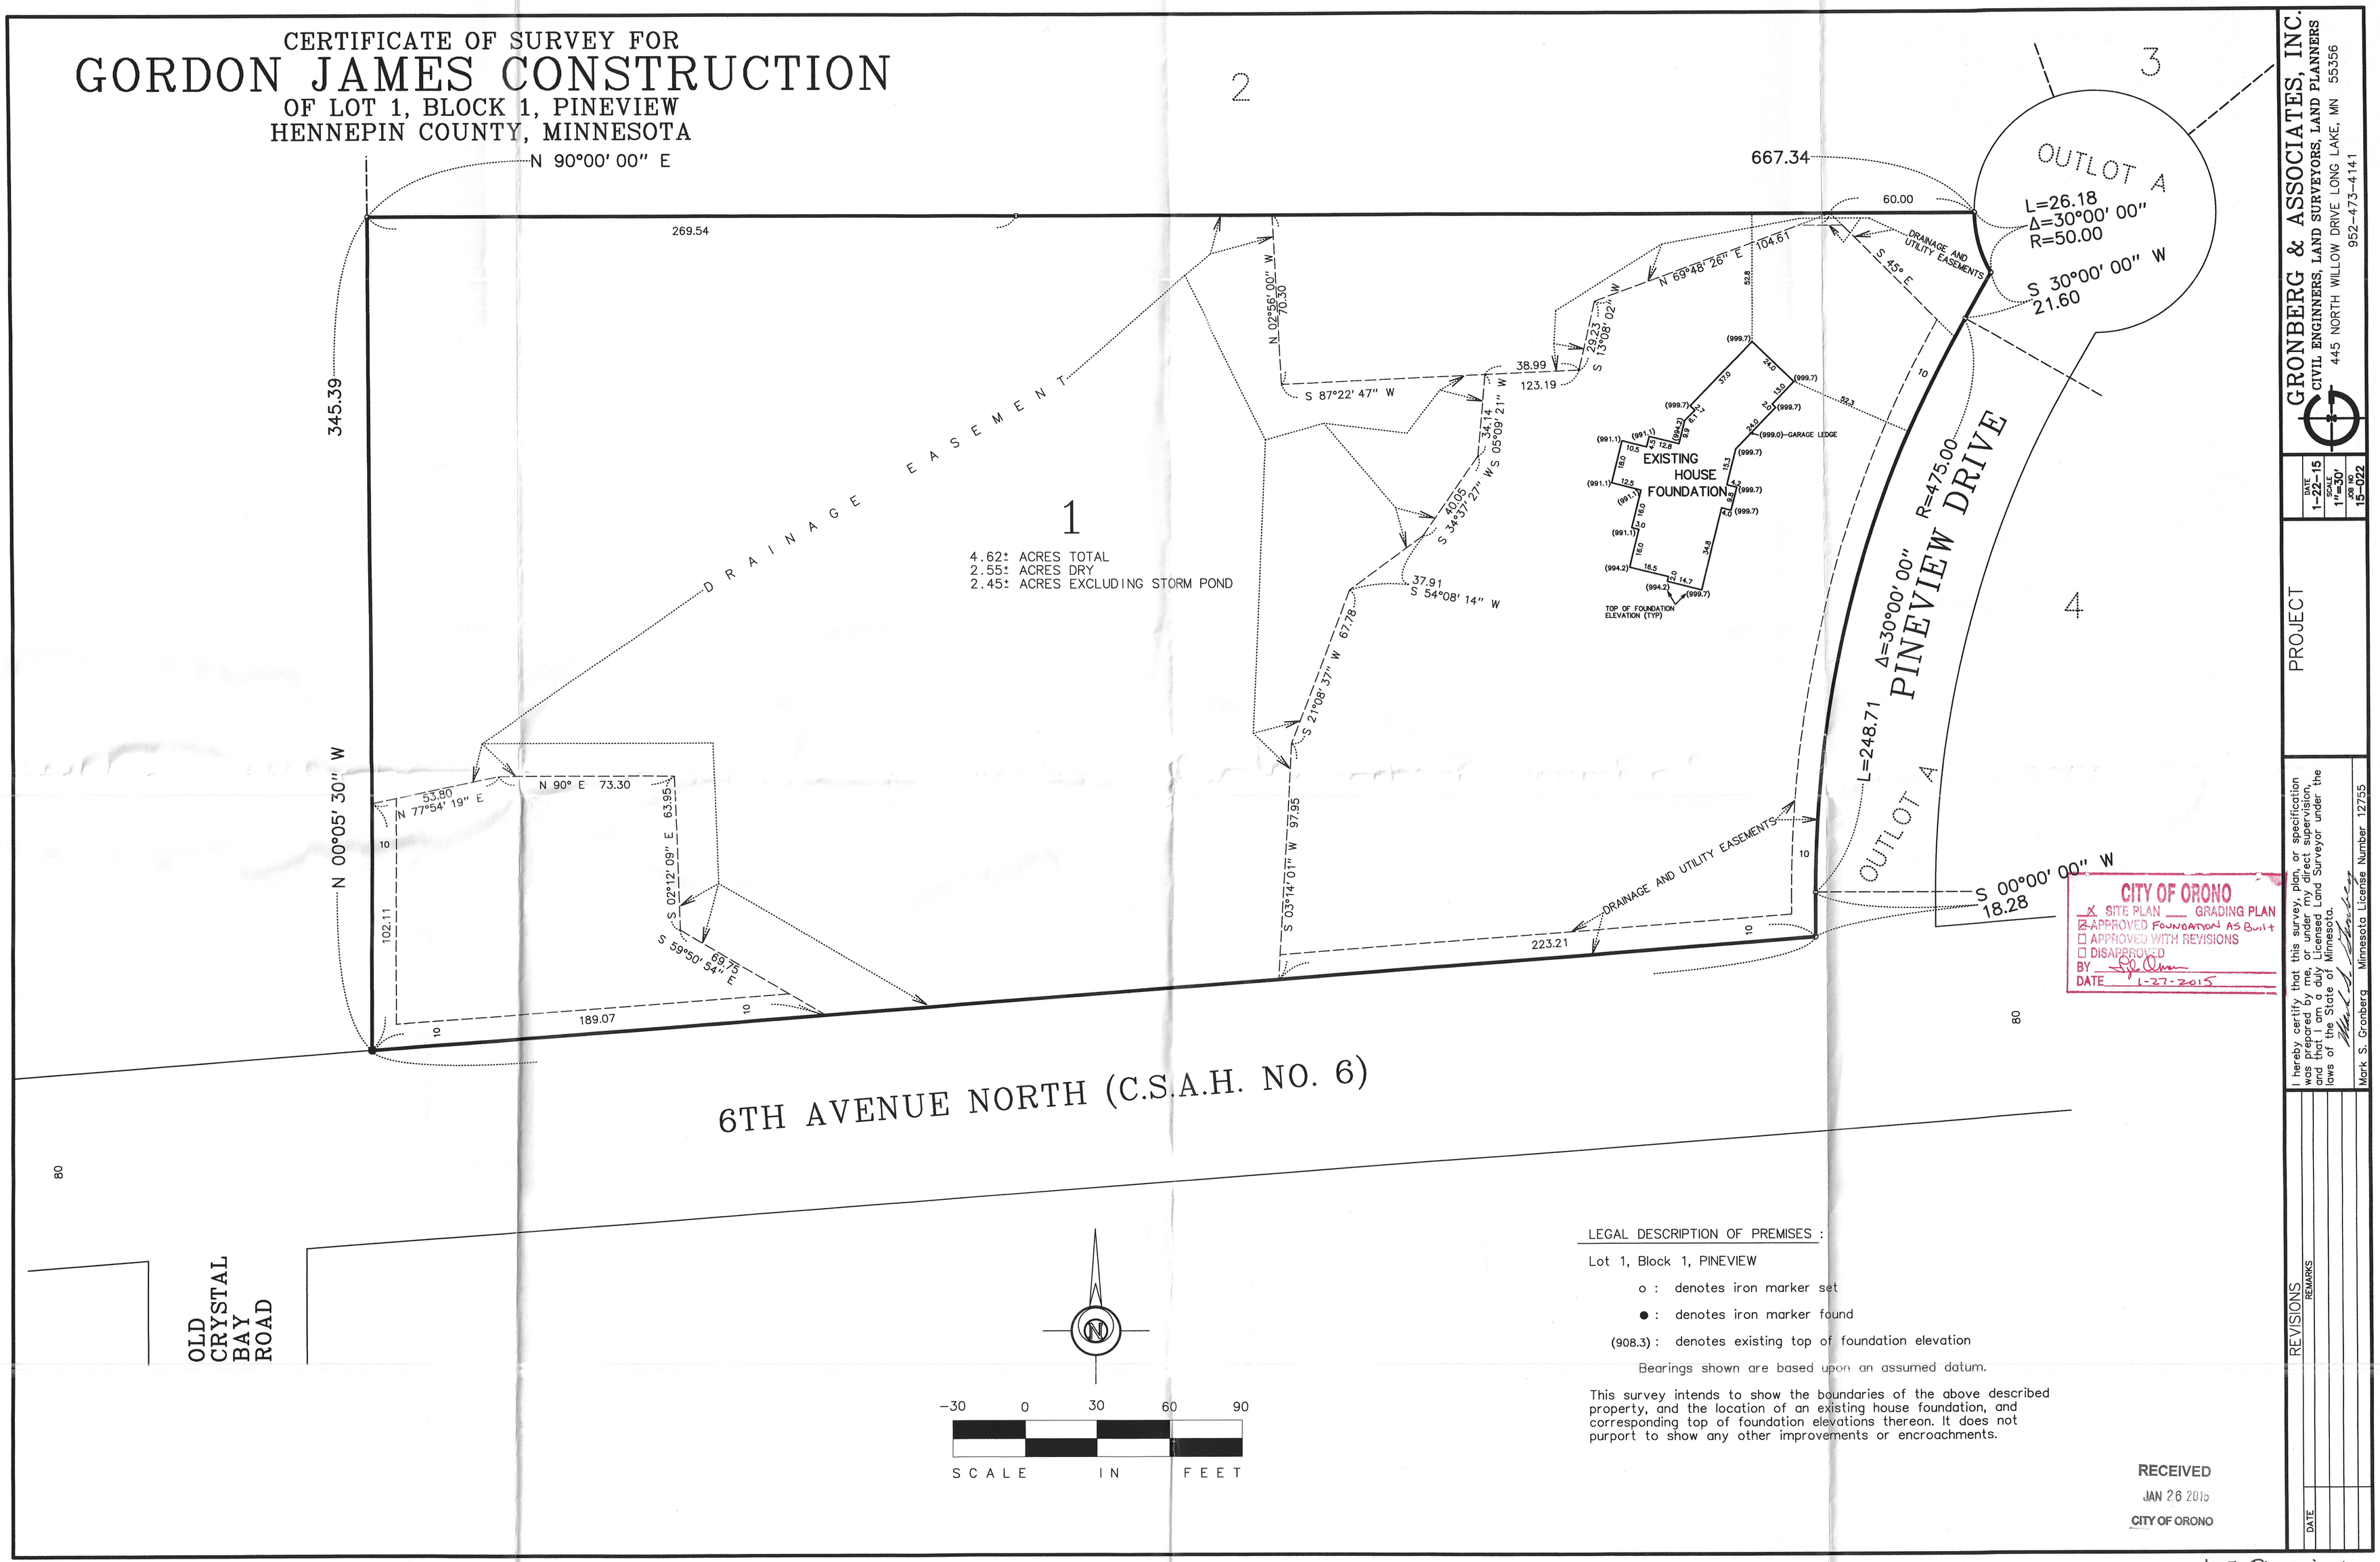

LEGAL DESCRIPTION OF PREMISES :

Lot 1, Block 1, PINEVIEW

o : denotes iron marker set

● : denotes iron marker found

(908.3) : denotes existing top of foundation elevation

Bearings shown are based upon an assumed datum.

This survey intends to show the boundaries of the above described property, and the location of an existing house foundation, and corresponding top of foundation elevations thereon. It does not purport to show any other improvements or encroachments.

CITY OF ORONO
X SITE PLAN ___ GRADING PLAN
APPROVED Foundation As Built
APPROVED WITH REVISIONS
DISAPPROVED
BY
DATE 1-27-2015

RECEIVED
JAN 26 2015
CITY OF ORONO

GRONBERG & ASSOCIATES, INC.
CIVIL ENGINNERS, LAND SURVEYORS, LAND PLANNERS
445 NORTH WILLOW DRIVE LONG LAKE, MN 55356
952-473-4141

DATE 1-22-15 | SCALE 1"=30' | JOB NO 15-022

PROJECT

I hereby certify that this survey, plan, or specification was prepared by me, or under my direct supervision, and that I am a duly Licensed Land Surveyor under the laws of the State of Minnesota.
Mark S. Gronberg Minnesota License Number 12755

REVISIONS
REMARKS
DATE

15-022

1125 Pine view Dr.
2014-01252
Foundation As-Built