


CERTIFICATE OF SURVEY FOR
MATTHEW AND JENNIFER NYQUIST
OF LOT 1, BLOCK 1, PINE VIEW
HENNEPIN COUNTY, MINNESOTA

RECEIVED
OCT 28 2016
CITY OF ORONO

GRONDB COPY

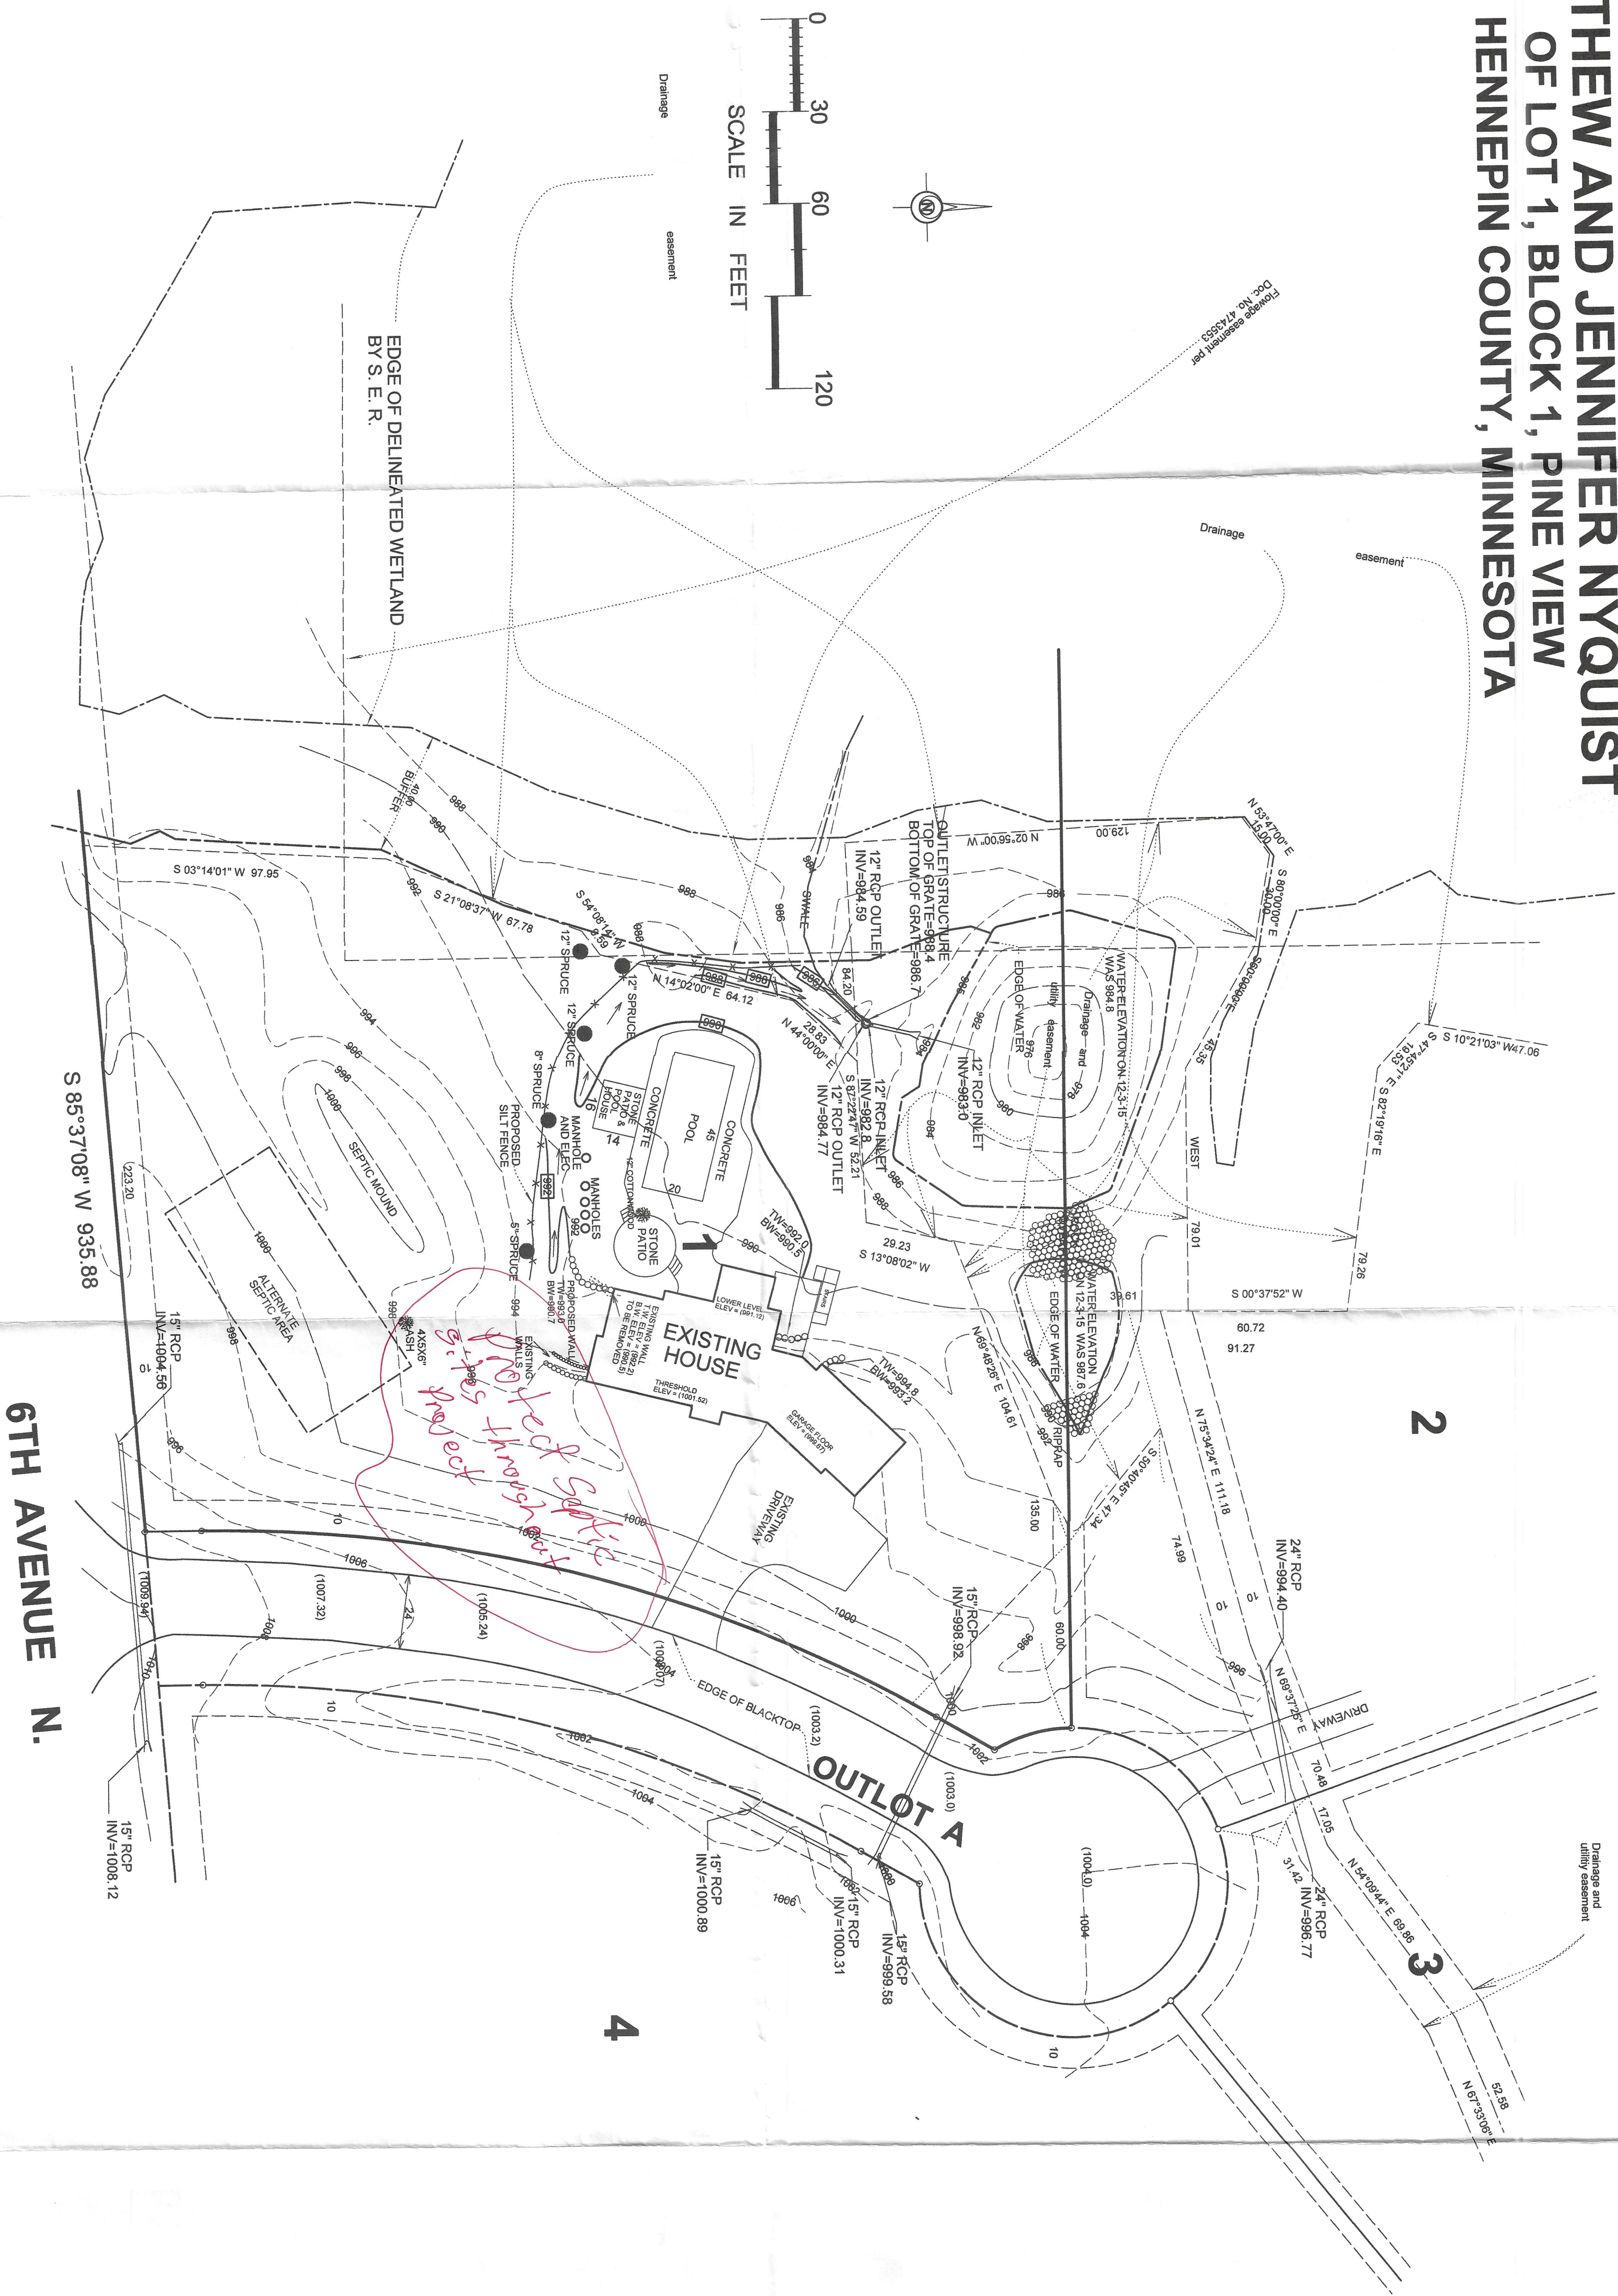

REVISIONS		REMARKS
DATE	BY	
10-14-16		POOL HOUSE ADDED TO STONE PATIO

DESIGNED	I hereby certify that this plan, specification, or report was prepared by me or under my direct supervision and that I am a duly Licensed Land Surveyor under the laws of the State of Minnesota.
DRAWN	<i>Mark J. Hanbury</i>
CHECKED	<i>Mark J. Hanbury</i>
DATE	10-14-16
MINN. LICENSE NUMBER	12755

DATE	10-11-16
SCALE	1"=30'
SHEET NO.	16-391
SHEET	3
SHEETS	3



GRONBERG & ASSOCIATES, INC.
CIVIL ENGINEERS, LAND SURVEYORS, LAND PLANNERS
445 N. WILLOW DRIVE LONG LAKE, MN 55356
PHONE: 952-473-4141 FAX: 952-473-4435

1125 Pine View Drive
Permit 2016-01375
Cancelled