

WELL OR BORING LOCATION

County Name

Henn

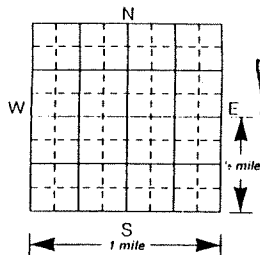
MINNESOTA DEPARTMENT OF HEALTH

WELL AND BORING SEALING RECORD
Minnesota Statutes, Chapter 103IMinnesota Well and Boring
Sealing No.

H 37081

Minnesota Unique No.
or W-series No.
(leave blank if not known)

Township Name Orono	Township No.	Range No.	Section No.	Fraction (sm. - lg.) 1/4 1/4 1/4	Date Sealed 12-29-93	Approximate Date Well or Boring Constructed 1960's
------------------------	--------------	-----------	-------------	-------------------------------------	-------------------------	--

Numerical Street Address, or Line Number, and City of Well or Boring Location
4030 Elm St. OronoShow exact location of well or boring
in section grid with 'X'Sketch map of well or boring
location, showing property lines,
roads, and buildings

Depth Before Sealing 90' ft. Original Depth 90' ft.

Static Water Level ☒ Accurate
☐ Approximate
64 ft. 1 below above land surface☒ Single Aquifer ☐ Multiaquifer

CASING TYPE

☒ Steel ☐ Plastic ☐ Tile ☐ Other

Screen from to ft. Open Hole from to ft.

OBSTRUCTION/DEBRIS/FILL

☒ Obstruction ☐ Debris ☐ Fill

Type of debris/obstruction buried with Cap.

Obstruction/Debris/Fill removed? ☒ Yes ☐ No

PUMP

☐ Removed ☒ Not Present ☐ Other

CASING

Diameter	Depth	Set in oversize hole?	Annular space initially grouted?
3 in.	from 0 to 90' ft.	<input type="checkbox"/> Yes <input checked="" type="checkbox"/> No	<input type="checkbox"/> Yes <input type="checkbox"/> No <input checked="" type="checkbox"/> Unknown
in.	from to ft.	<input type="checkbox"/> Yes <input type="checkbox"/> No	<input type="checkbox"/> Yes <input type="checkbox"/> No <input type="checkbox"/> Unknown
in.	from to ft.	<input type="checkbox"/> Yes <input type="checkbox"/> No	<input type="checkbox"/> Yes <input type="checkbox"/> No <input type="checkbox"/> Unknown

METHOD USED TO SEAL ANNULAR SPACE BETWEEN 2 CASINGS, OR CASING AND BORE HOLE:

☒ No Annular Space Exists
☐ Annular space grouted with tremie pipe
☐ Casing Perforation/Removalin. from to ft. ☐ Perforated ☐ Removedin. from to ft. ☐ Perforated ☐ Removed

Type of perforator

☐ Other

GROUTING MATERIAL

Grouting material	from	to	ft.	yards	bags
Bentonite	0	90'			2

UNSEALED WELLS AND BORINGS

Other unsealed well or boring on property? ☐ Yes ☒ No

LICENSED OR REGISTERED CONTRACTOR CERTIFICATION

This well or boring was sealed in accordance with Minnesota Rules, Chapter 4725. The information contained in this report is true to the best of my knowledge.

Dr. HCO

Contractor Business Name

License or Registration No.

Authorized Representative Signature

12-93 27204

Date

Name of Person Sealing Well or Boring

12-93 27204

PROPERTY OWNER'S NAME

Craig Holm

Mailing Address if different than property address indicated above.

1328 N.E. LK. St Apt 317

Hopkins, MN 55343

GEOLOGICAL MATERIAL COLOR HARDNESS OF FORMATION FROM TO

If not known, indicate estimated formation log from nearby well or boring

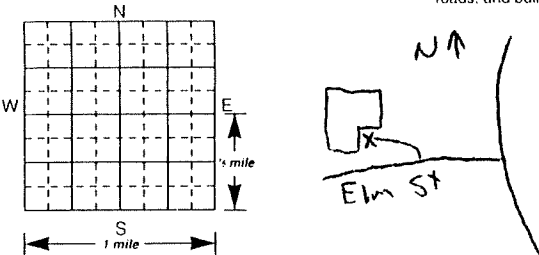
N/A

REMARKS, SOURCE OF DATA, DIFFICULTIES IN SEALING

3" Well Casing.

PRINT NAME, TITLE, AND ADDRESS OF PERSON SEALING WELL OR BORING

H 37081

WELL OR BORING LOCATION				MINNESOTA DEPARTMENT OF HEALTH		Minnesota Well and Boring Sealing No.		H 37082	
County Name <u>Hennepin</u>				WELL AND BORING SEALING RECORD <i>Minnesota Statutes, Chapter 103I</i>		Minnesota Unique No. or W-series No. (Leave blank if not known)			
Township Name <u>Orono</u>		Township No.	Range No.	Section No.	Fraction (sm. lg.) <u>1/4 1/4 1/4</u>	Date Sealed <u>12-29-93</u>		Approximate Date Well or Boring Constructed <u>1940^s</u>	
Numerical Street Address or Fair Number and City of Well or Boring Location <u>4030 Elm St. Orono</u>						Depth Before Sealing <u>72'</u> ft.		Original Depth <u>72'</u> ft.	
Show exact location of well or boring in section grid with 'X'				Sketch map of well or boring location, showing property lines, roads, and buildings.		Static Water Level <input checked="" type="checkbox"/> Accurate <input type="checkbox"/> Approximate <u>64</u> ft. <u>X</u> below _____ above land surface			
						<input checked="" type="checkbox"/> Single Aquifer <input type="checkbox"/> Multiaquifer			
PROPERTY OWNER'S NAME <u>Craig Helm</u>						CASING TYPE <input checked="" type="checkbox"/> Steel <input type="checkbox"/> Plastic <input type="checkbox"/> Tile <input type="checkbox"/> Other <u>3"</u>			
Mailing Address if different than property address indicated above. <u>1328 N.E. Lk. St. Apt 317</u> <u>Hopkins, Mn. 55343</u>						Screen from _____ to _____ ft. Open Hole from _____ to _____ ft.			
GEOLOGICAL MATERIAL						OBSTRUCTION/DEBRIS/FILL <input checked="" type="checkbox"/> Obstruction <input type="checkbox"/> Debris <input type="checkbox"/> Fill Type of debris/obstruction <u>Clay Plug Removed</u> Obstruction/Debris/Fill removed? <input checked="" type="checkbox"/> Yes <input type="checkbox"/> No			
if not known, indicate estimated formation log from nearby well or boring.						PUMP <input type="checkbox"/> Removed <input checked="" type="checkbox"/> Not Present <input type="checkbox"/> Other _____			
Diameter						CASING			
Depth						Set in oversize hole? Annular space initially grouted?			
<u>3</u> in. from <u>0</u> to <u>72</u> ft.						<input type="checkbox"/> Yes <input checked="" type="checkbox"/> No <input type="checkbox"/> Yes <input type="checkbox"/> No <input checked="" type="checkbox"/> Unknown			
_____ in. from _____ to _____ ft.						<input type="checkbox"/> Yes <input type="checkbox"/> No <input type="checkbox"/> Yes <input type="checkbox"/> No <input type="checkbox"/> Unknown			
_____ in. from _____ to _____ ft.						<input type="checkbox"/> Yes <input type="checkbox"/> No <input type="checkbox"/> Yes <input type="checkbox"/> No <input type="checkbox"/> Unknown			
METHOD USED TO SEAL ANNULAR SPACE BETWEEN 2 CASINGS, OR CASING AND BORE HOLE:									
<input checked="" type="checkbox"/> No Annular Space Exists									
<input type="checkbox"/> Annular space grouted with tremie pipe									
<input type="checkbox"/> Casing Perforation/Removal									
_____ in. from _____ to _____ ft.						<input type="checkbox"/> Perforated <input type="checkbox"/> Removed			
_____ in. from _____ to _____ ft.						<input type="checkbox"/> Perforated <input type="checkbox"/> Removed			
Type of perforator _____									
<input type="checkbox"/> Other _____									
GROUTING MATERIAL									
Grouting material <u>Bentonite</u> from <u>0</u> to <u>72</u> ft. _____ yards <u>1 1/2</u> bags									
_____ from _____ to _____ ft. _____ yards _____ bags									
_____ from _____ to _____ ft. _____ yards _____ bags									
_____ from _____ to _____ ft. _____ yards _____ bags									
REMARKS, SOURCE OF DATA, DIFFICULTIES IN SEALING <u>3" Well Casing.</u>						UNSEALED WELLS AND BORINGS Other unsealed well or boring on property? <input type="checkbox"/> Yes <input checked="" type="checkbox"/> No			
IMPORTANT: THE WELL PROPERTY OF THE USER OF THIS COPY						LICENSED OR REGISTERED CONTRACTOR CERTIFICATION This well or boring was sealed in accordance with Minnesota Rules, Chapter 4725. The information contained in this report is true to the best of my knowledge.			
H 37082						Contractor Business Name <u>Driller</u> <u>John Uron</u> Date <u>12-29-93</u>			
						Name of Person Sealing Well or Boring <u>John Uron</u>			