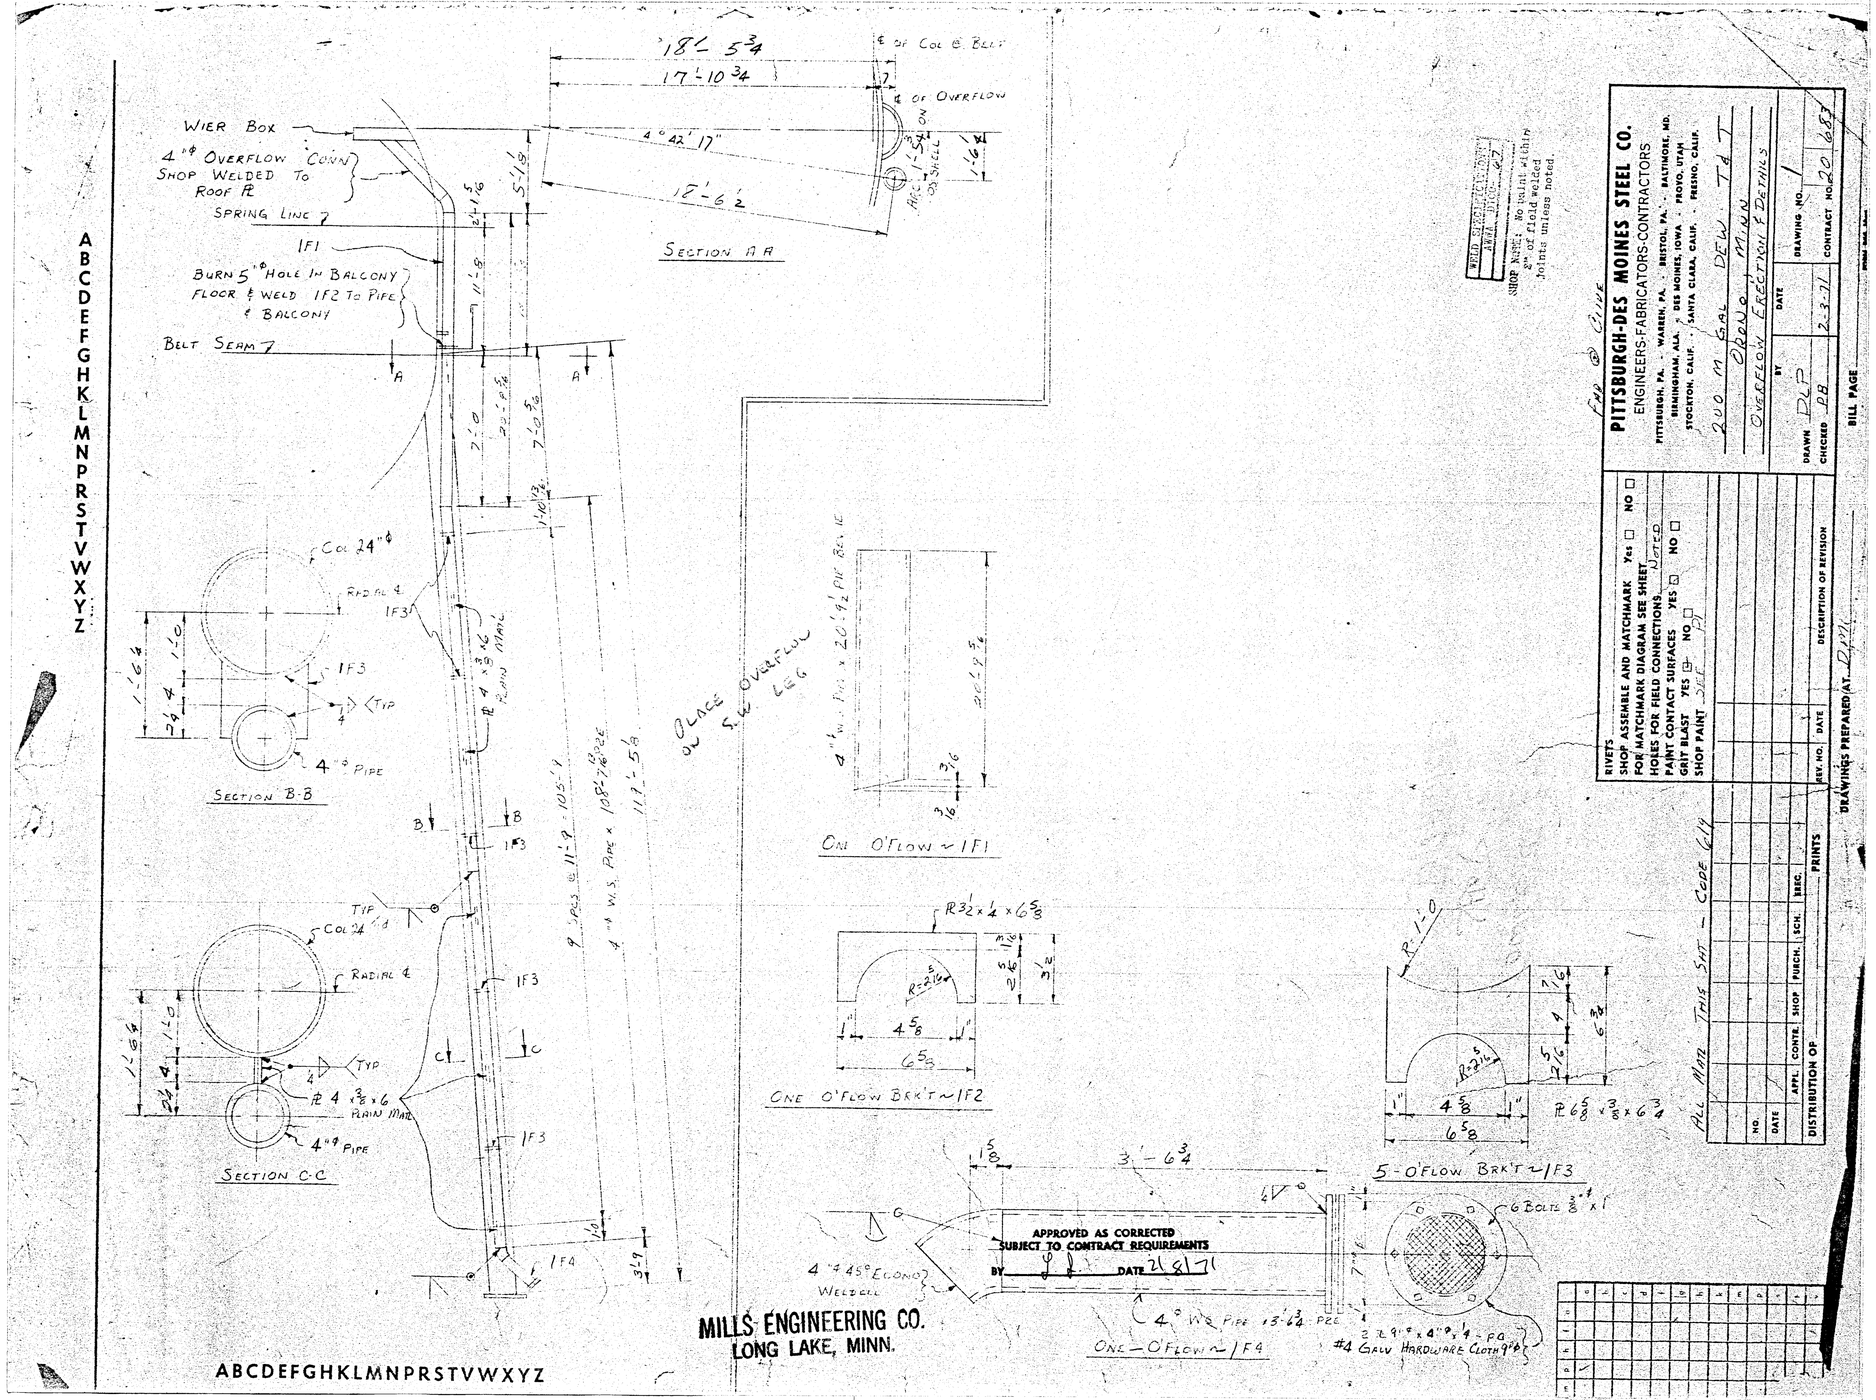
WIER BOX
4" ϕ OVERFLOW CONN SHOP WELDED TO ROOF PL
SPRING LINE
1F1
BURN 5" ϕ HOLE IN BALCONY FLOOR & WELD 1F2 TO PIPE & BALCONY
BELT SEAM
SECTION A-A
SECTION B-B
SECTION C-C
COL 24" ϕ
RADIAL ℄
1F3
TYP
4" ϕ PIPE
PL 4 x 3/8 x 6 PLAIN MATL
9 SPCS @ 11'-9" = 105'-1"
4" ϕ W.S. PIPE x 108'-1 1/16" PER
11'-5 5/8"
1F4
PLACE ON S.W. LEG
4" ϕ W.S. PIPE x 26'-9 1/2" PER LN
ONE O'FLOW ~ 1F1
R 3 1/2 x 1/4 x 6 5/8
ONE O'FLOW BRK'T ~ 1F2
5 - O'FLOW BRK'T ~ 1F3
PL 6 5/8 x 3/8 x 6 3/4
6 BOLTS 3/8" ϕ x 1"
4" ϕ 45° ELCOND WELDOLL
4" ϕ W.S. PIPE 13'-6 3/4" PER
ONE - O'FLOW ~ 1F4
#4 GALV HARDWARE CLOTH 9" ϕ
APPROVED AS CORRECTED
SUBJECT TO CONTRACT REQUIREMENTS
BY
DATE 2/8/71
MILLS ENGINEERING CO.
LONG LAKE, MINN.
PITTSBURGH-DES MOINES STEEL CO.
ENGINEERS-FABRICATORS-CONTRACTORS
PITTSBURGH, PA. · WARREN, PA. · BRISTOL, PA. · BALTIMORE, MD.
BIRMINGHAM, ALA. · DES MOINES, IOWA · PROVO, UTAH
STOCKTON, CALIF. · SANTA CLARA, CALIF. · FRESNO, CALIF.
200 M GAL DEW T & T
OVERFLOW ERECTION & DETAILS
DRAWN BLP
CHECKED DB
DATE 2-3-71
DRAWING NO. 1
CONTRACT NO. 20 683
BILL PAGE
RIVETS
SHOP ASSEMBLE AND MATCHMARK Yes ☐ NO ☐
FOR MATCHMARK DIAGRAM SEE SHEET
HOLES FOR FIELD CONNECTIONS
PAINT CONTACT SURFACES YES ☐ NO ☐
GRIT BLAST YES ☐ NO ☐
SHOP PAINT
DISTRIBUTION OF
PRINTS
DRAWINGS PREPARED AT
ALL MATL THIS SHT - CODE 619