

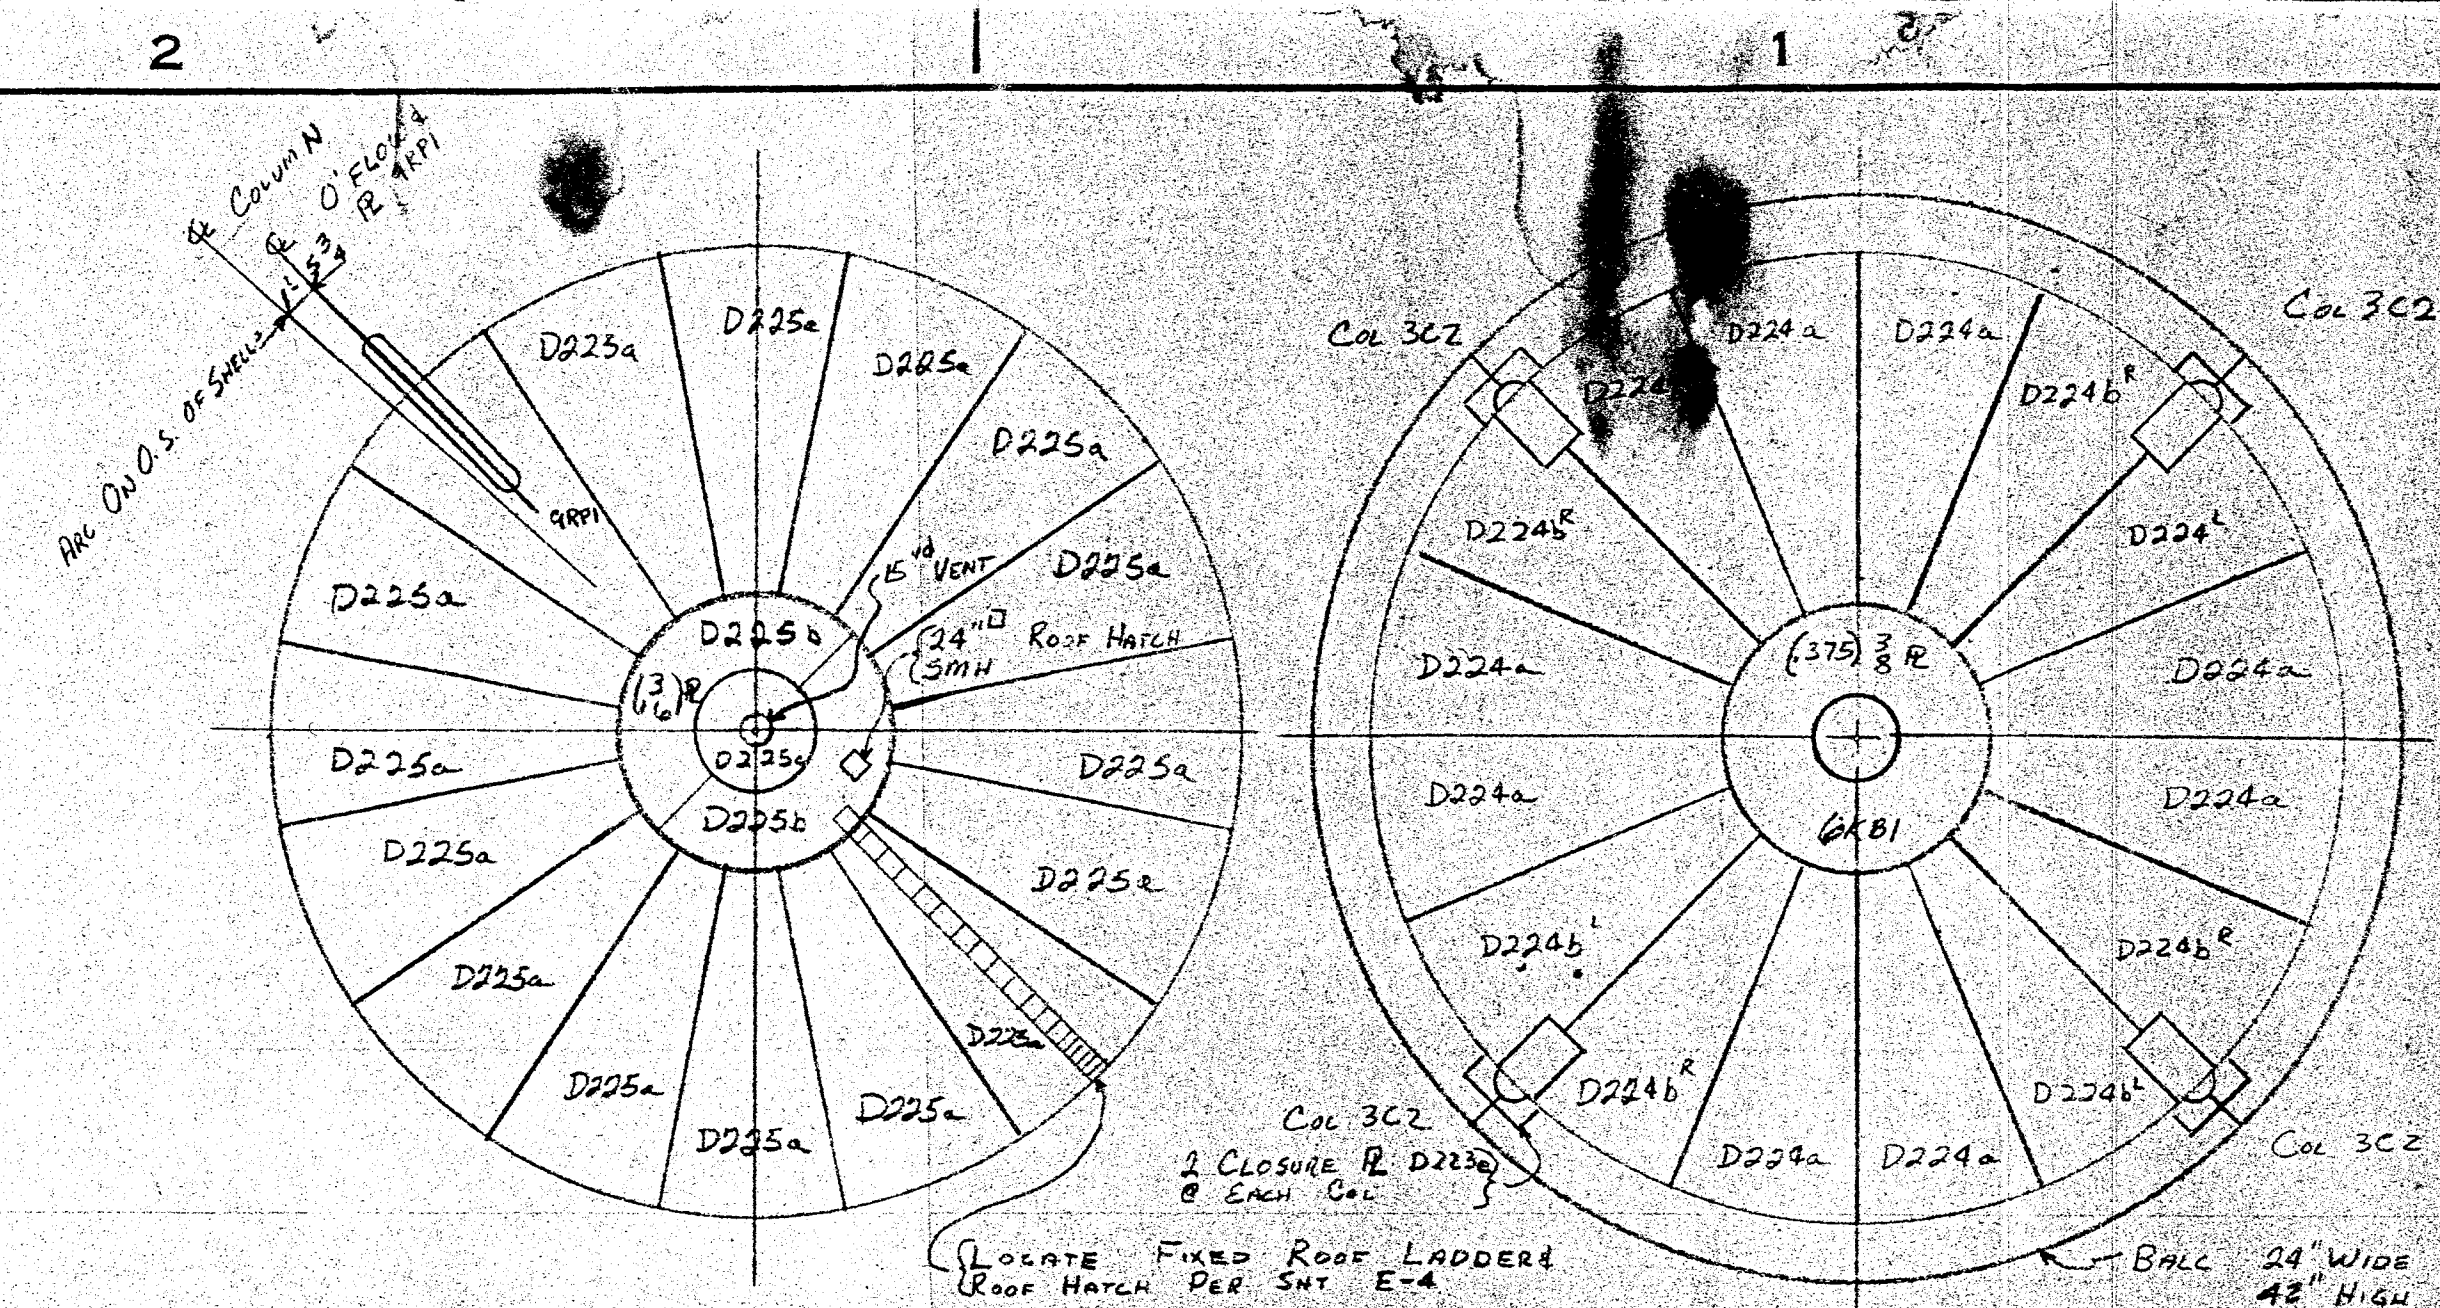


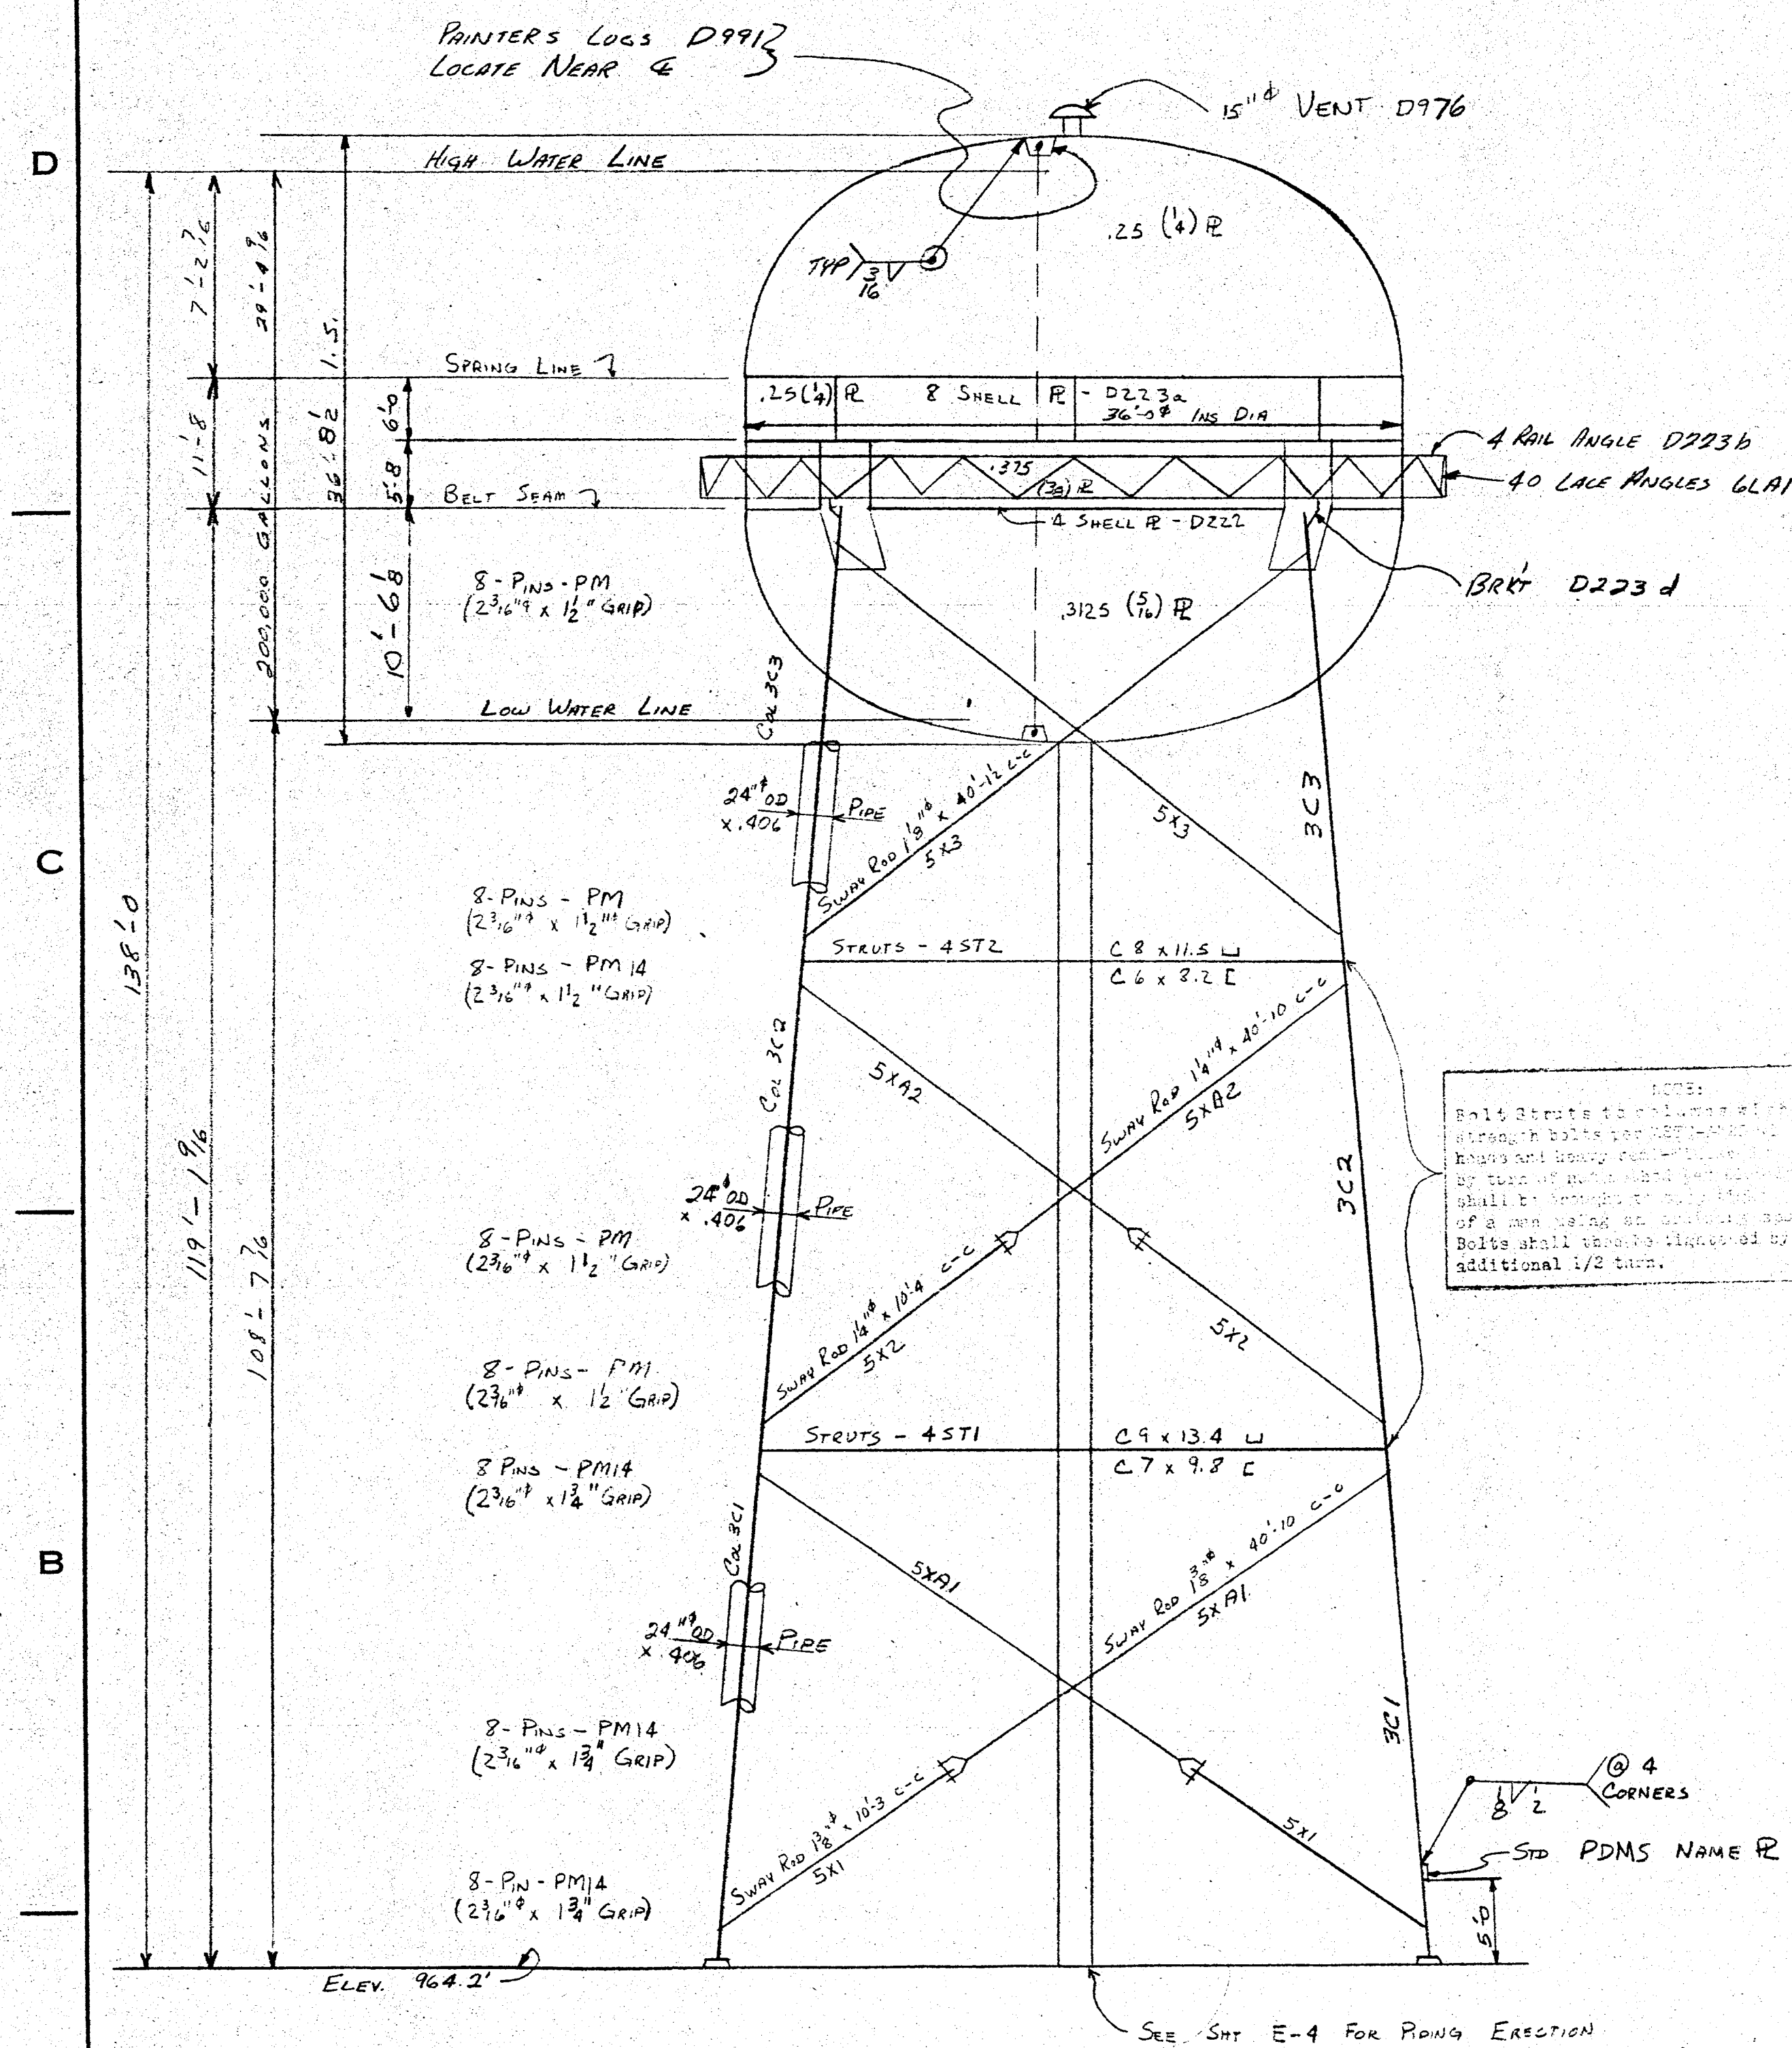

PLAN OF ROOF

PLAN OF BOTTOM & BALCONY

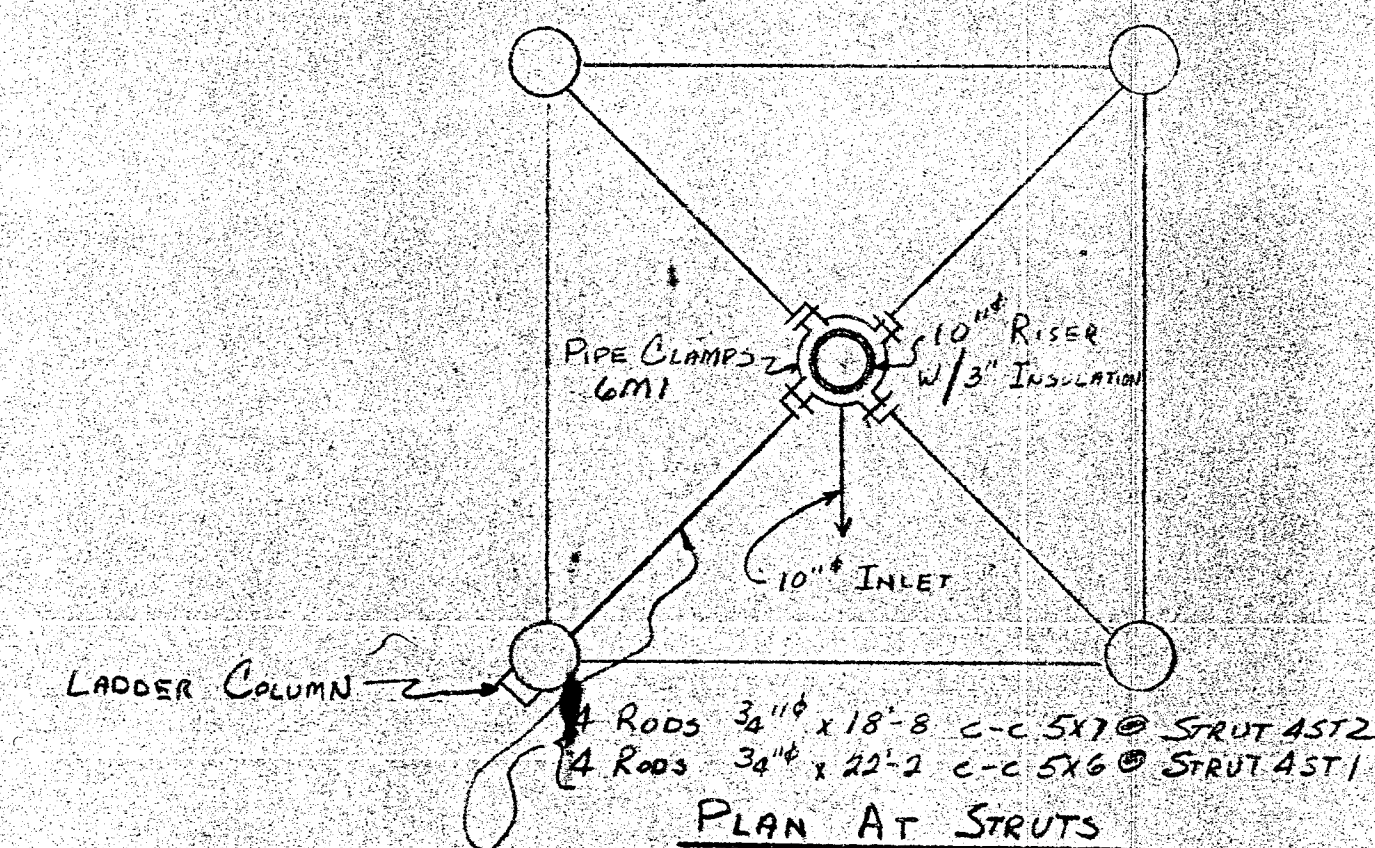

NOTE

- ALL CONNECTIONS WELDED EXCEPT AS NOTED
- BOLT LUGS ANGLES TO HANDRAIL & GIRDER
- BOLT LADDER SLICES
- BOLT SPIDER RODS TO COLUMN
- BOLT STRUTS TO COLUMN PER NOTE
- BOLT PIPE CLAMPS TOGETHER

WELD SPECS AWS/A D100 - 67

SEE SHEET E4 FOR LADDER & PIPING ERECTION.
SEE SHEET E5 FOR WELDING DIAGRAM
SEE SHEET P1 FOR STERILIZATION INSTRUCTIONS
SEE SHEET P1 FOR PRINTING INSTRUCTIONS

ALL LABOR & MATERIAL FOR FIELD PAINTING SUBJECT

ELEVATION

NOTE: USE SHIMS T242, T243, T244 & T245 TO PROMB COLUMNS.

a	b	c	d	e	f	g	h	i	j	k	l	m	n	p	q	r	s	t	u	v	w	x	y	z
a																								
f																								
h																								
p																								
m																								
NO. _____ DATE _____ DISTR. _____ APPL. _____ CONTR. _____ SHOP _____ PROD. _____ SCH. _____ EREC. _____ MACH. _____ BLD. _____ METH. _____ GRIT BLAST YES ☐ NO ☐ SHOP PAINT _____ SHOP ASSEMBLE AND MATCHMARK Yes ☐ NO ☐ MATERIAL _____ FOR MATCHMARK DIAGRAM SEE SHEET _____ OPEN HOLES _____																								
A	B	C	D	E	F	G	H	I	J	K	L	M	N	P	R									
C	V	W	V	V	V	V																		

APPROVED AS CORRECTED
SUBJECT TO CONTRACT REQUIREMENT
BY J. J. DATE 21/8/7

WILLS ENGINEERING CO
LONG LAKE, MINN.

PITTSBURGH-DES MOINES STEEL CO.
ENGINEERS-FABRICATORS-CONTRACTORS
PITTSBURGH, PA. ST. LOUIS, PA. BRISTOL, PA. BALTIMORE, MD.
BIRMINGHAM, AL. DES MOINES, IOWA. PROVO, UTAH
STOCKTON, CALIF. SANTA CLARA, CALIF. FRESNO, CALIF.

200 MG. PER DAY T & T
ORONO MINN.
EJECTION

DWG. PREPARED AT <u>D.M.</u>	
FABRICATED AT <u>CLU</u>	
B'Y	DATE
DRAWN <u>DLP</u>	
CHECKED <u>PB</u>	<u>2-9-7</u>
DRAWING NO. <u>E3</u>	
CONTRACT NO. <u>90683</u>	