
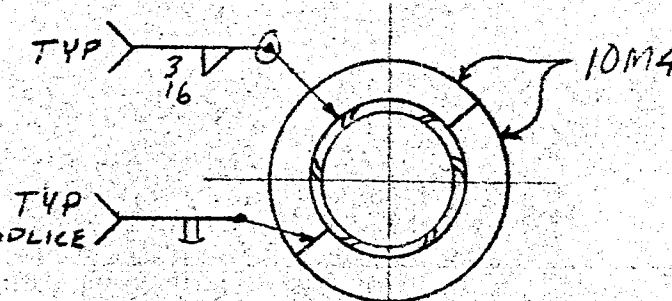
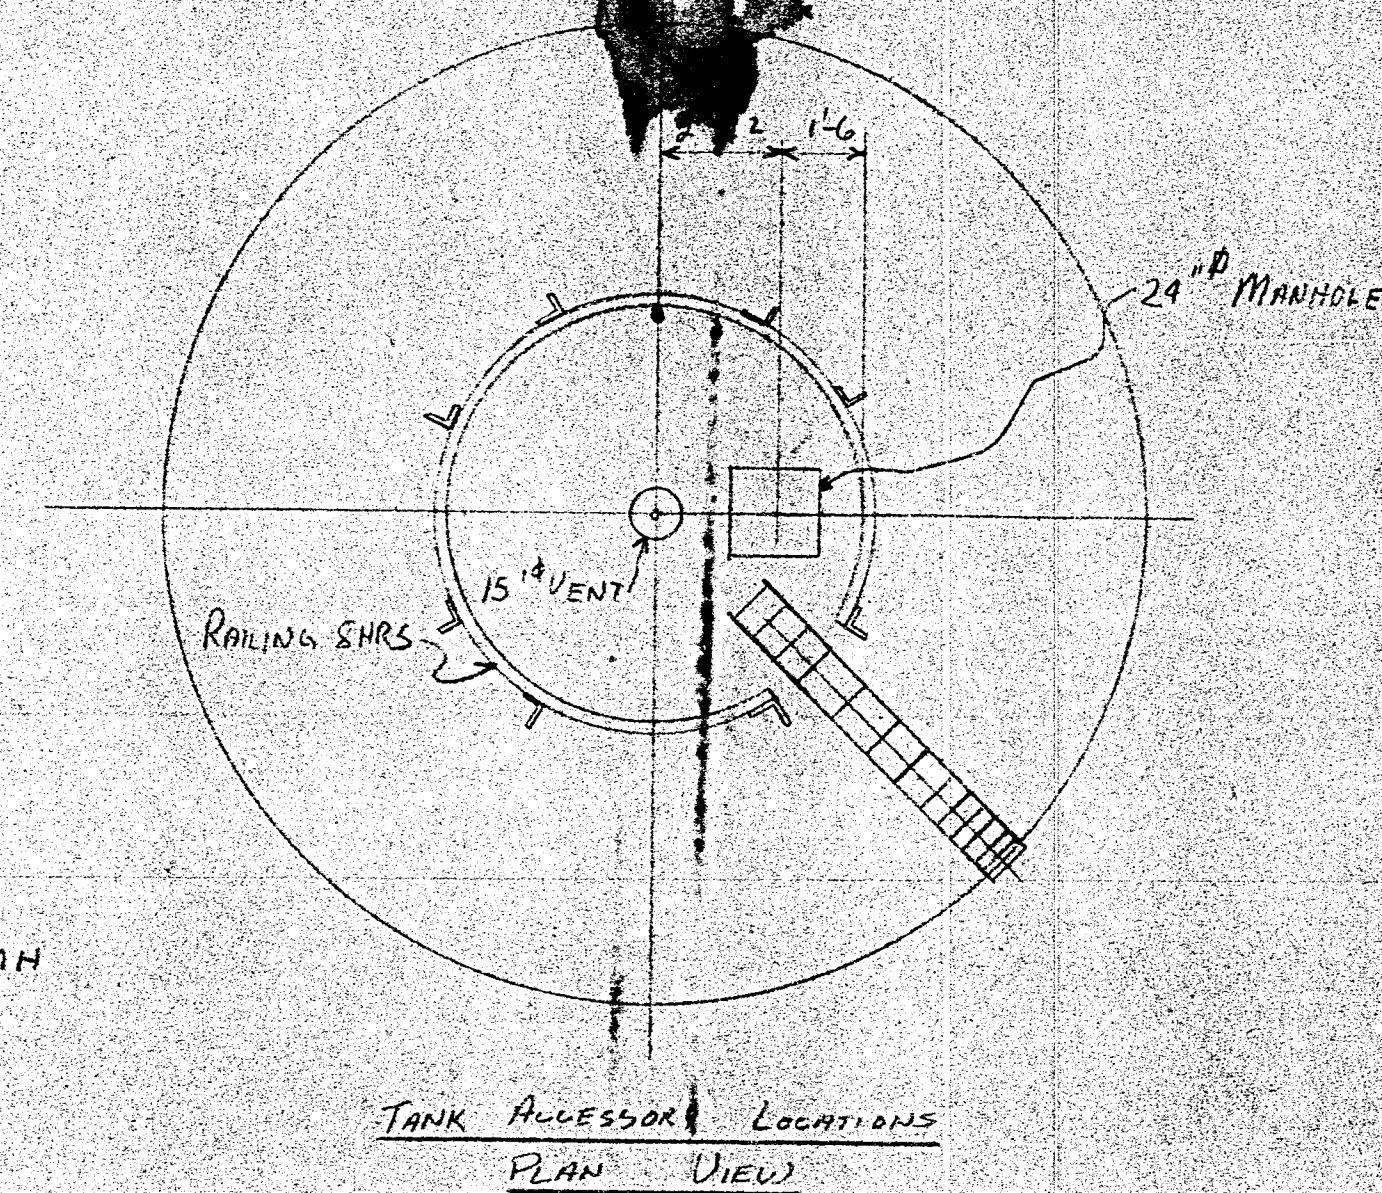
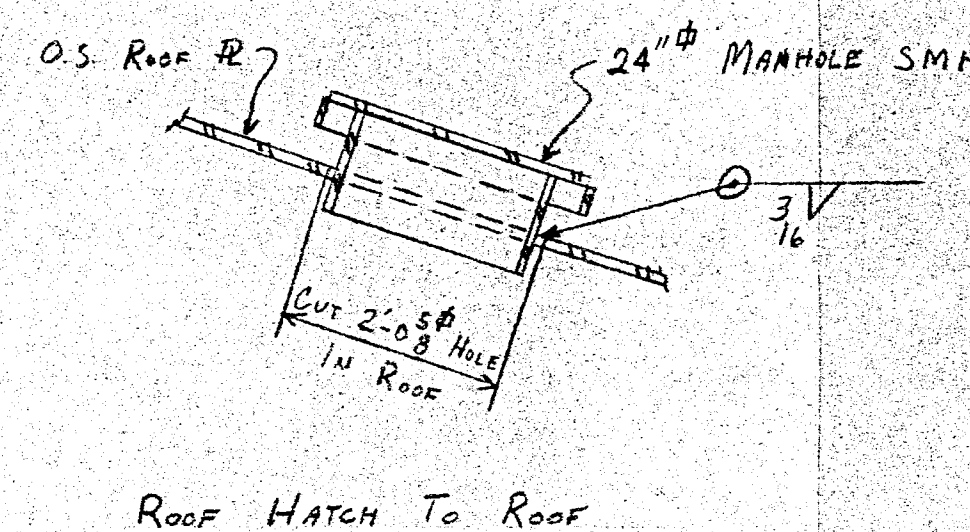
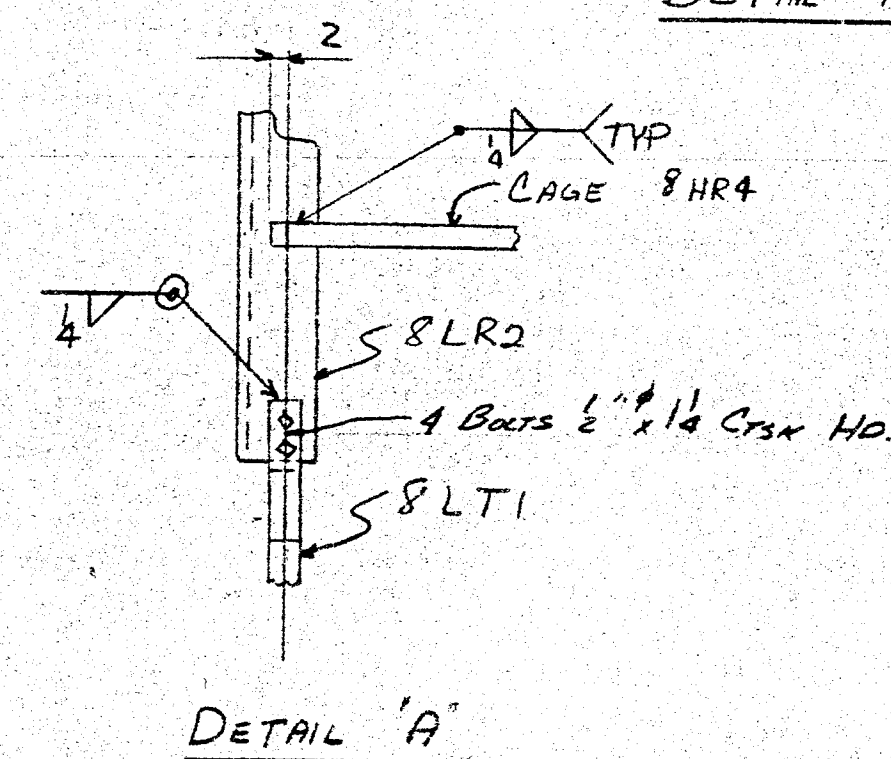
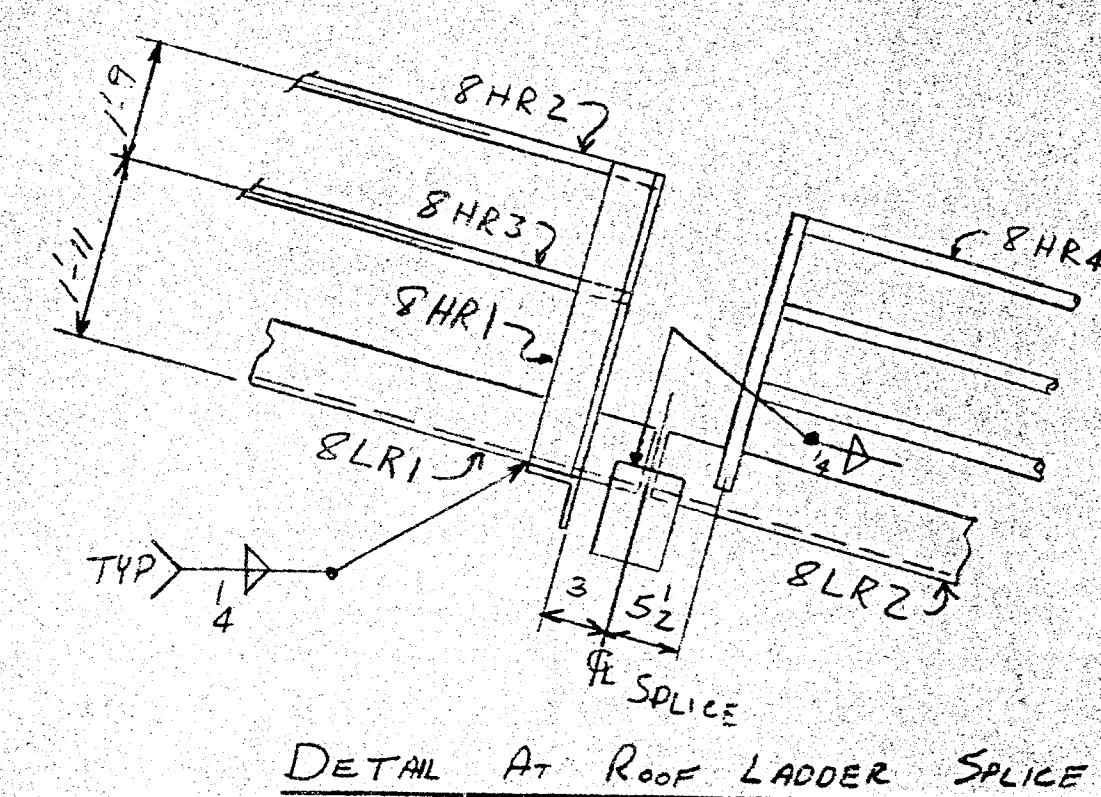


D


C

B


A

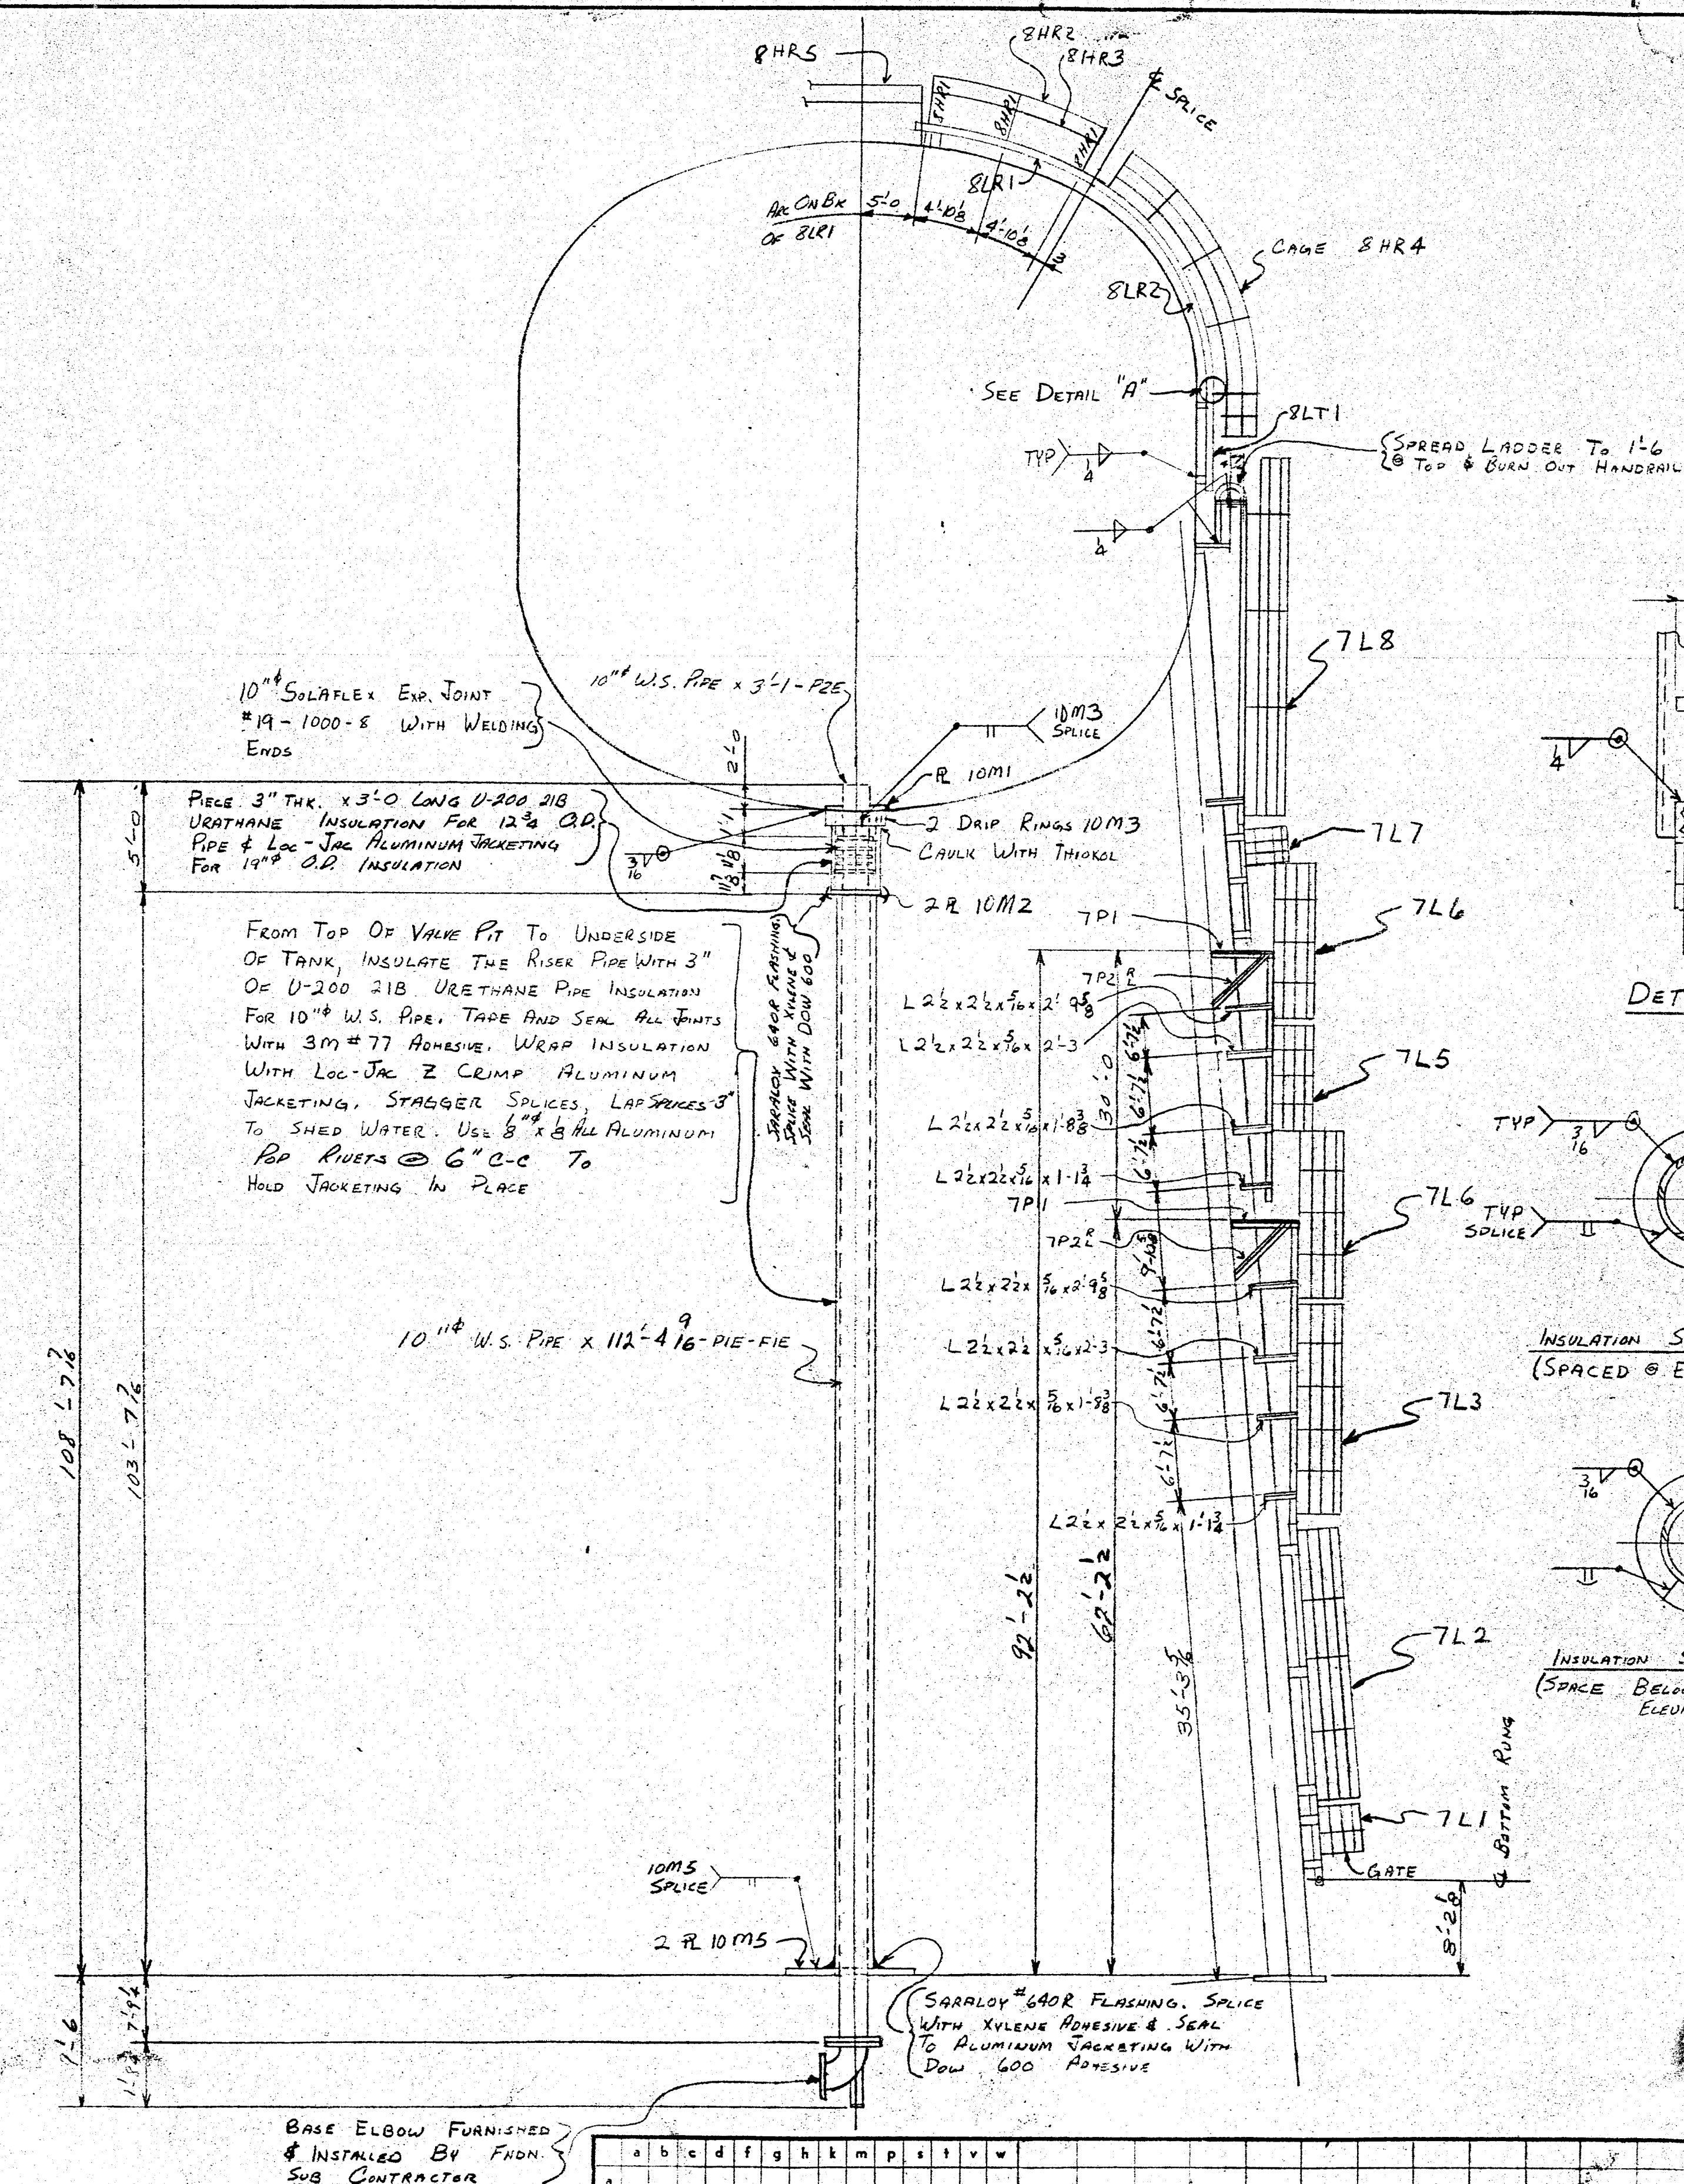

INSULATION SUPPORT RING TO PIPE
(SPACED @ EVERY 8'-0" C-C)

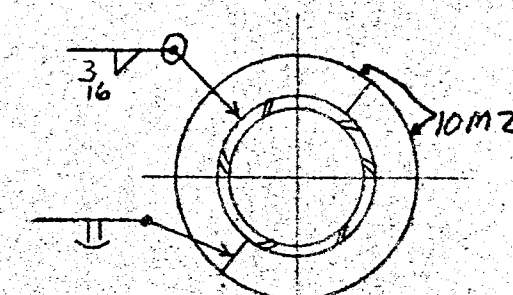

INSULATION SUPPORT RING TO PIPE
(SPACE BELOW EXPANSION JOINT PER
ELEVATION)

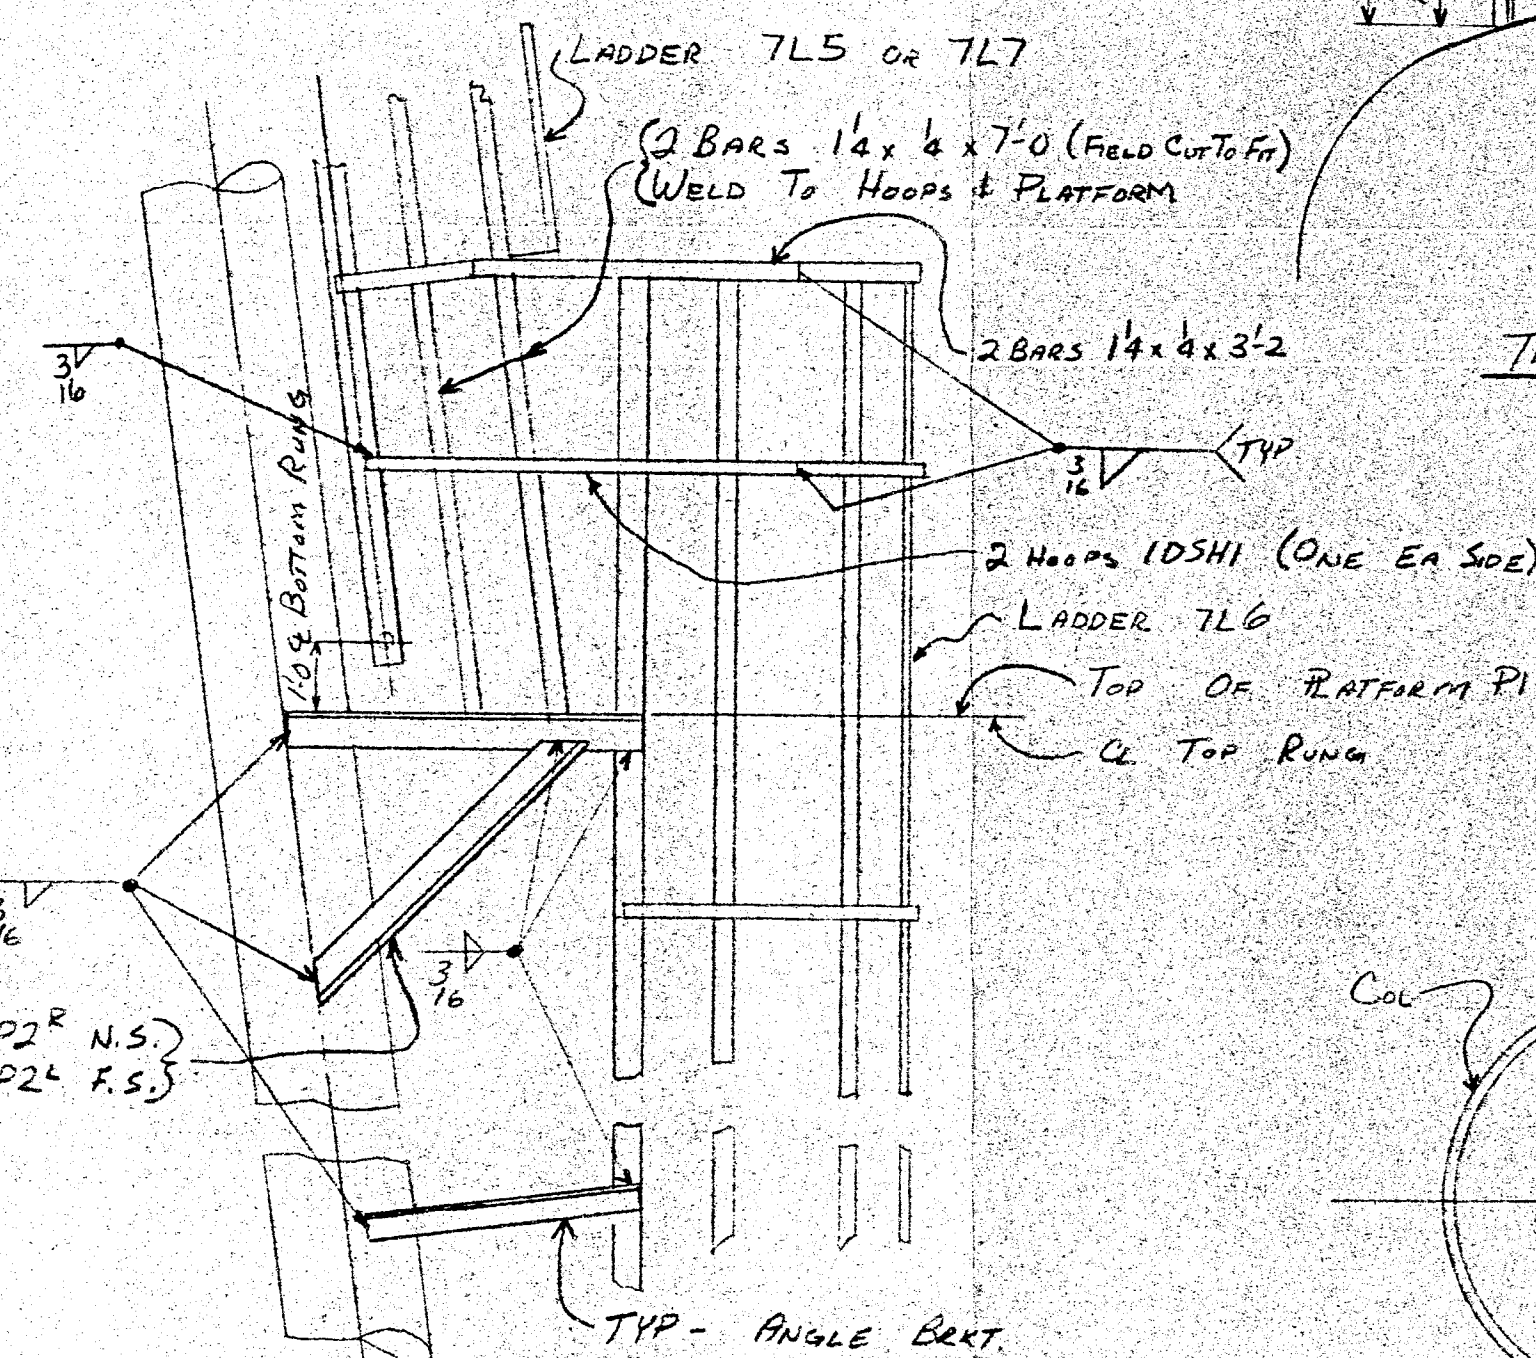

DETAIL AT PLATFORM

APPROVED AS CORRECTED
SUBJECT TO CONTRACT REQUIREMENTS
BY Y DATE 2/8/71

BASE ELBOW FURNISHED
SUB CONTRACTOR

a																						
b																						
c																						
MILLS ENGINEERING CO.
LONG LAKE, MINN.

PITTSBURGH-DES MOINES STEEL CO.
ENGINEERS-FABRICATORS-CONTRACTORS
PITTSBURGH, PA. DES MOINES, IOWA
BIRMINGHAM, ALA. ST. LOUIS, MO. CHICAGO, ILL.
STOCKTON, CALIF. LOS ANGELES, CALIF. PHOENIX, ARIZ.

200 M GA DEW T & T
ORINA MINN.
ERECTION

DWG. PREPARED AT DM
FABRICATED AT CLV
BY DP DATE 2-9-71
CHECKED PB
DRAWING NO. E-4
CONTRACT NO. 20.683