

D

C

B


A

D

C

B

A

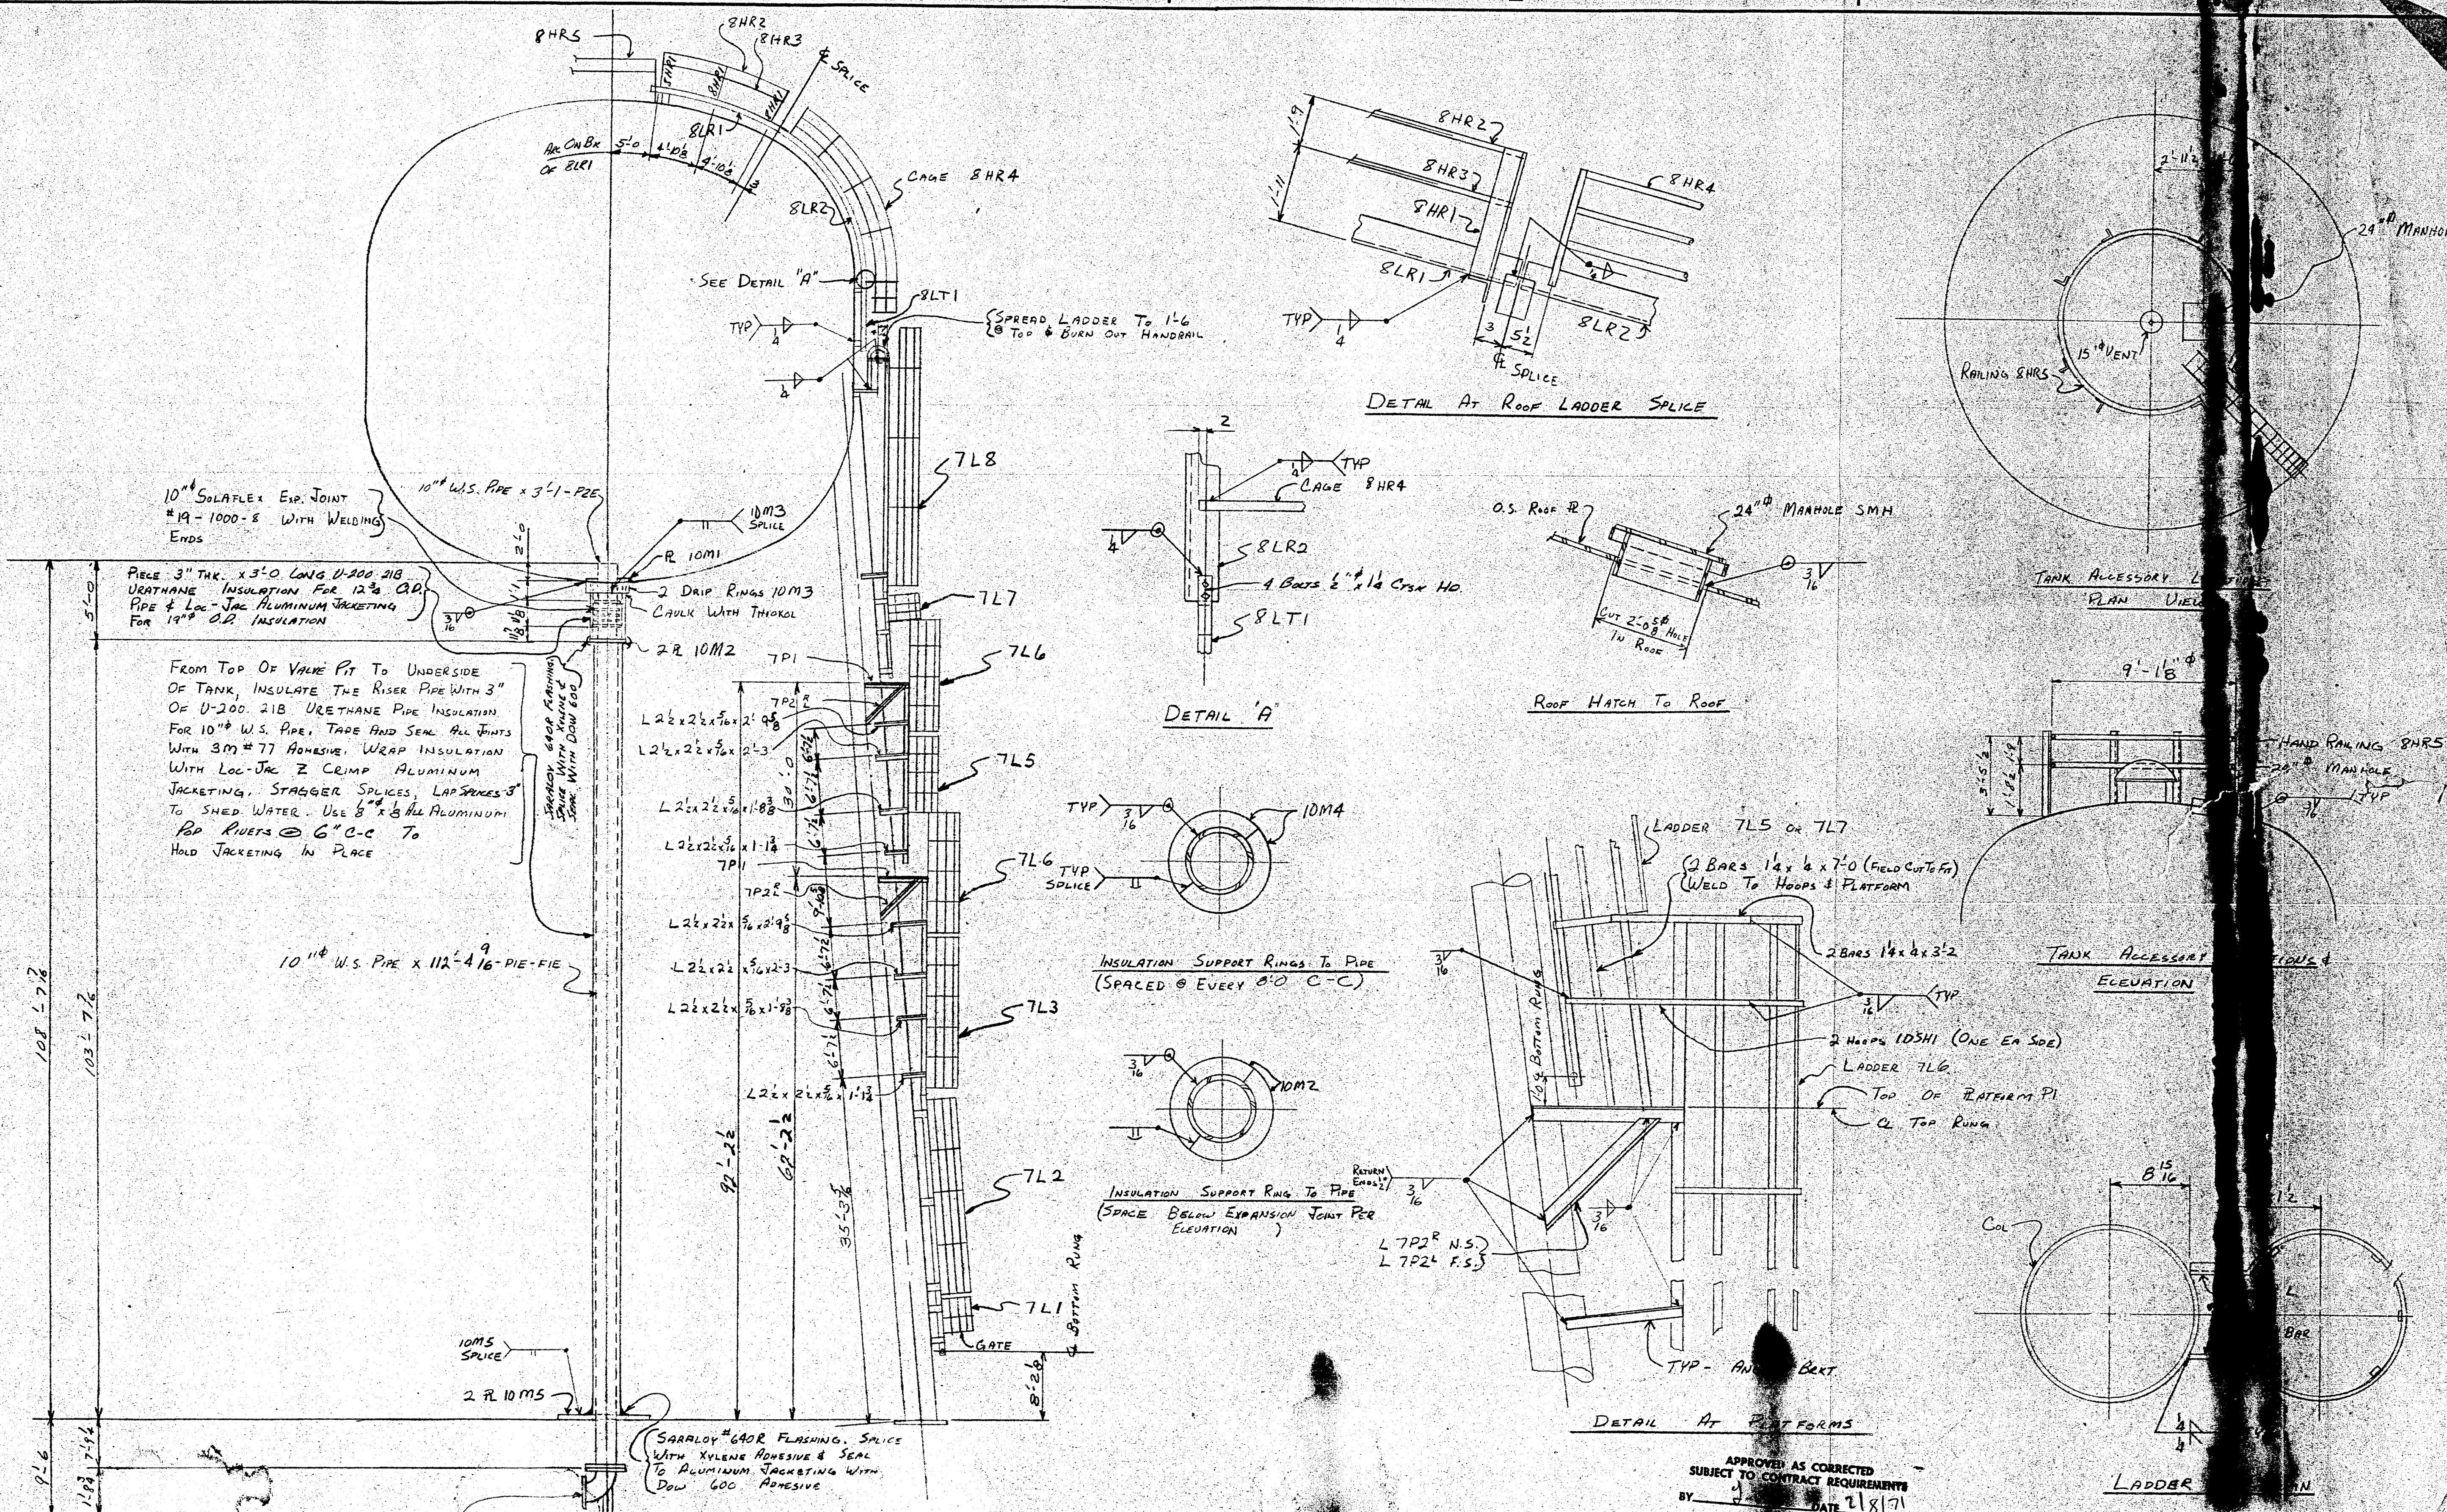

NO.	
DATE	
DISTR.																										APPL.																										CONTR.																										SHOP																										PROD.																										SCH.																										EREQ.																										MACH.																										BLD.																										9																										METH.	
GRIT BLAST																										YES																										☐																										NO																										☐	
SHOP PAINT	

MILLS ENGINEERING CO.
LONG LAKE, MINN.

PITTSBURGH-DES MOINES STEEL CO.
ENGINEERS-FABRICATORS-CONTRACTORS
PITTSBURGH, PA. WARREN, PA. BUTTE, PA. BILTMORE, NC.
BETHLEHEM, ALA. DES MOINES, IOWA. PUEBLO, UTAH
STOCKTON, CALIF. SANTA CLARA, CALIF. FRESNO, CALIF.

DWG. PREPARED AT DM
FABRICATED AT PLU
DRAWN DLP BY DATE
CHECKED PB 2-9-71
DRAWING NO. E-4
CONTRACT NO. 20583

200 M GAL DEW T & T
ORD. MINN.
FRETION