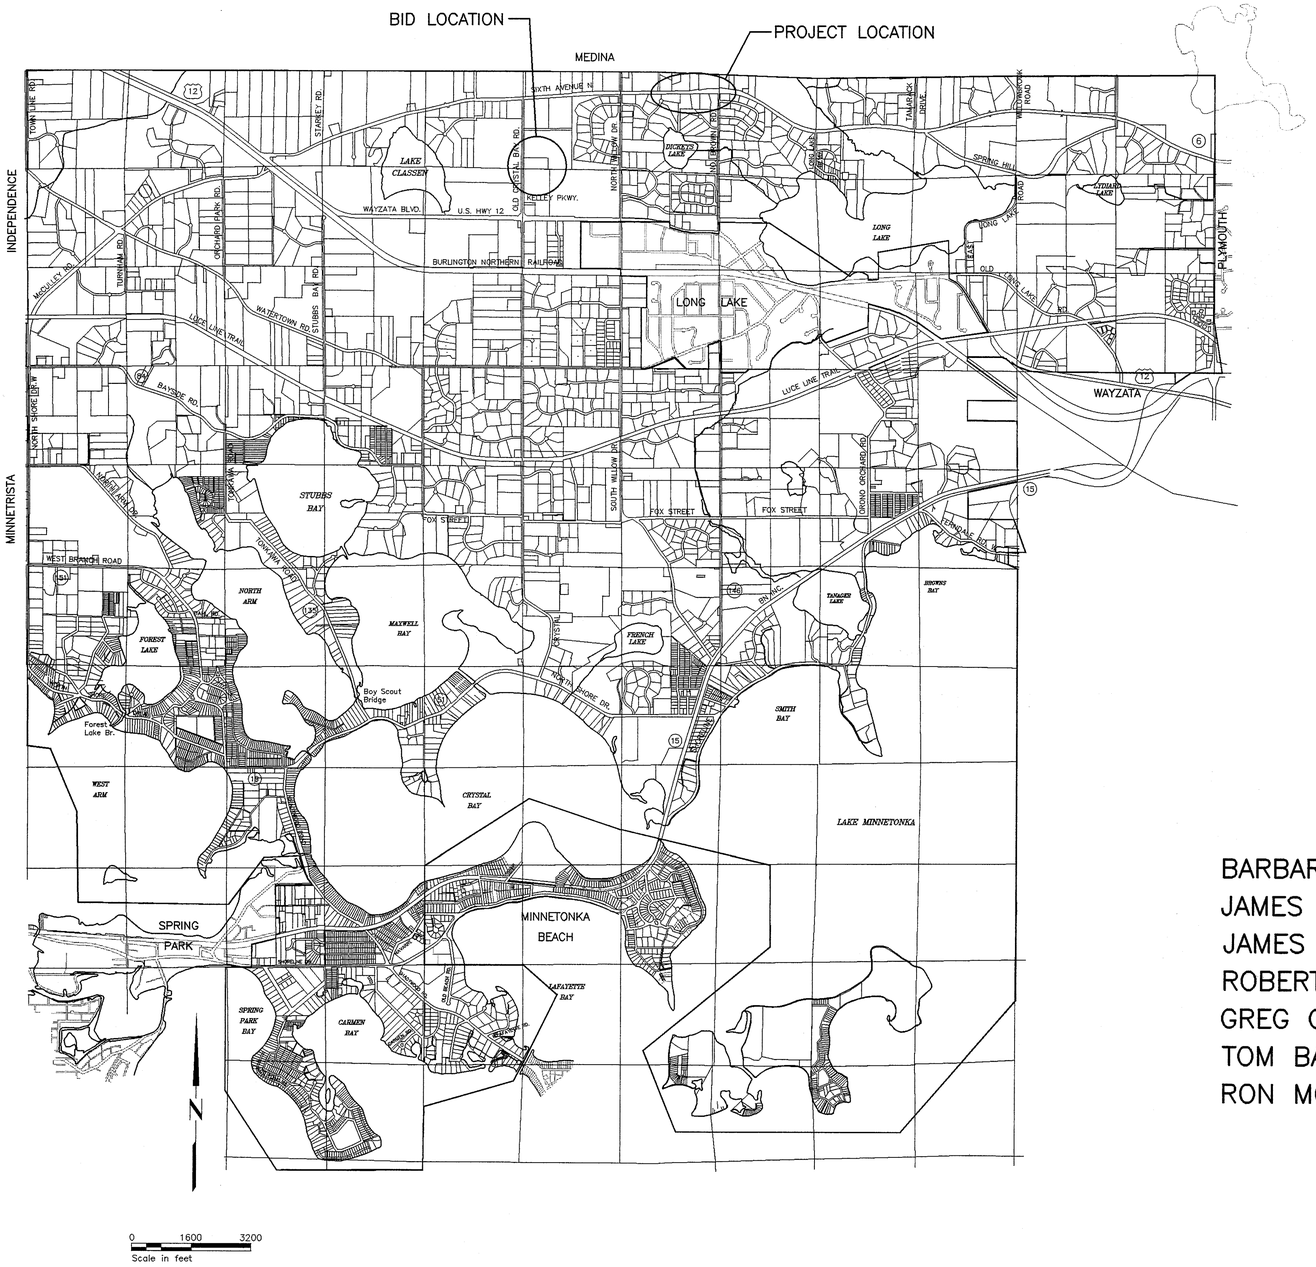

ORONO, MINNESOTA

PHILLIPS
SANITARY SEWER EXTENSION

SHEET INDEX

G1.01 TITLE SHEET
C8.01 LOCATION PLAN, DETAILS
C4.01 PLAN AND PROFILE

2003

COUNCIL

BARBARA PETERSON	MAYOR
JAMES MURPHY	COUNCILMEMBER
JAMES WHITE	COUNCILMEMBER
ROBERT SANSEVERE	COUNCILMEMBER
GREG GAPPA	PUBLIC SERVICES DIRECTOR
TOM BARRETT	CITY ATTORNEY
RON MOORSE	CITY ADMINISTRATOR

RECORD PLAN NOV. 2003
CONTRACTOR: RED
PETERSON UTILITIES INC.

SURVEY	
DRAWN	MJB
DESIGNED	TPK
APPROVED	TPK
DATE	8/18/2003
PROJ. NO.	13903140

I HEREBY CERTIFY THAT THIS PLAN, SPECIFICATION, OR REPORT WAS PREPARED BY ME OR UNDER MY DIRECT SUPERVISION AND THAT I AM A DULY LICENSED PROFESSIONAL ENGINEER UNDER THE LAWS OF THE STATE OF MINNESOTA.
PRINT NAME: Thomas P. Kellogg
SIGNATURE: Thomas P. Kellogg
DATE August 18, 2003 LIC. NO. 26817

St. Paul Office
2335 West Highway 36
St. Paul, MN 55113
Phone: 651-636-4600
Fax: 651-636-1311

©BONESTROO, ROSENE, ANDERLIK & ASSOCIATES, INC. 2003

Bonestroo Rosene Anderlik & Associates
Engineers & Architects
www.bonestroo.com

ORONO, MINNESOTA
PHILLIPS SANITARY SEWER EXTENSION
TITLE SHEET

13903140G101.DWG
SHEET NUMBER
G1.01