



Task # 93010

Date Called in	
Date Scheduled	4/9/25 10am

City Of Orono  
Point of Sale Sanitary Sewer Service I&I Compliance Inspection Form

4/9/25  
2:00 pm


Property Address:	1971 Fagerness Point Road
PID:	1811723140007

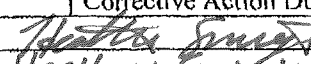
Owner Information	
Name:	James Schugel + Jennifer Schugel
Mailing Address: (if different from Property)	612-432-2025
Phone:	612-257-0347
Email:	Jimmymalibu59@gmail.com

Inspector Information	
Name:	
Company/ Organization	City of Orono Highview Plumbing
License number:	
Phone:	952-249-4686
Email:	

612-916-1685

Inspection			
System	Standard	Pass	Fail
Roof Drains	Roof drains and leaders Roof drains should not be connected to the sanitary sewer but should discharge to the ground outside of a building. If the roof drains are connected to the sanitary sewer, disconnect them, plug any open connections to the sanitary sewer using a non-shrink permanent material, and redirect the roof drains onto the ground outside the building.	X	
Foundation Drains	Foundation drains are underground pipes that collect storm water from around the base of a building and into a sump basket, where it is then pumped outside of the building. Foundation drains should not be connected to the sanitary sewer.	X	
Sump Pumps	Sump pumps are designed to capture surface or ground water that enters basements or crawl spaces and pump it away from the house. The basic sump system includes drain tile, a sump pit, a sump pump, a float or switch, and a drain line. Sump pumps should not be connected to the sanitary sewer.	X	
Sewer Service Line	Sanitary Sewer Inflow & Infiltration (I/I) Compliance Inspection Sanitary Sewer Lines. All sanitary sewer lines serving Property, from the house to the main line, shall be in a safe and functional condition and shall be free from all leaks, failures including but not limited to partially collapsed sections or tree root intrusion. The sanitary sewer lines shall meet the City Code standards and specifications. (Details on back of this sheet)		✓
Notes:	- Video reviewed by Jimmy Nelson - Public Works Utilities Supervisor and failed due to roots in multiple joints.		
Toilet Removed For Inspection:	o Yes <del>No</del>		

Inspectors Signature: 	Date: 4-9-25
Owners Signature:	Date:

City Review	
<input type="checkbox"/> Compliant	<input checked="" type="checkbox"/> Corrective Action Required
Certificate of Compliance Expires:	Corrective Action Due by: 7/4/25
Date: 4-9-25	Signature: 
	Name: Heather Smith

### Service Line Inspection Details

Weather Conditions:	
Approximate Depth of Service	
Type and Size of Service	
Overall Condition of Service Pipe	

Please note all connections, fittings, points of concern on service line including infiltration, tree root, cracks, misaligned joints, etc. This report must include a digital copy of the televising.	
Feet	Comment
Example: 0 1-10	Start for 4" cleanout in NE corner of Basement Misaligned joint -Infiltration
0          14' 46' 47 50' 70' 76' 84' 100'	C.O. Root Root ? Root 4" CASS → 4" CLAY Root 4" CLAY → 6" ABS ROOT MANH
Notes:	