


CERTIFICATE OF SURVEY FOR
RONALD RIDGEWAY
IN LOT 1, BLOCK 1, ORONO OAKS
HENNEPIN COUNTY, MINNESOTA

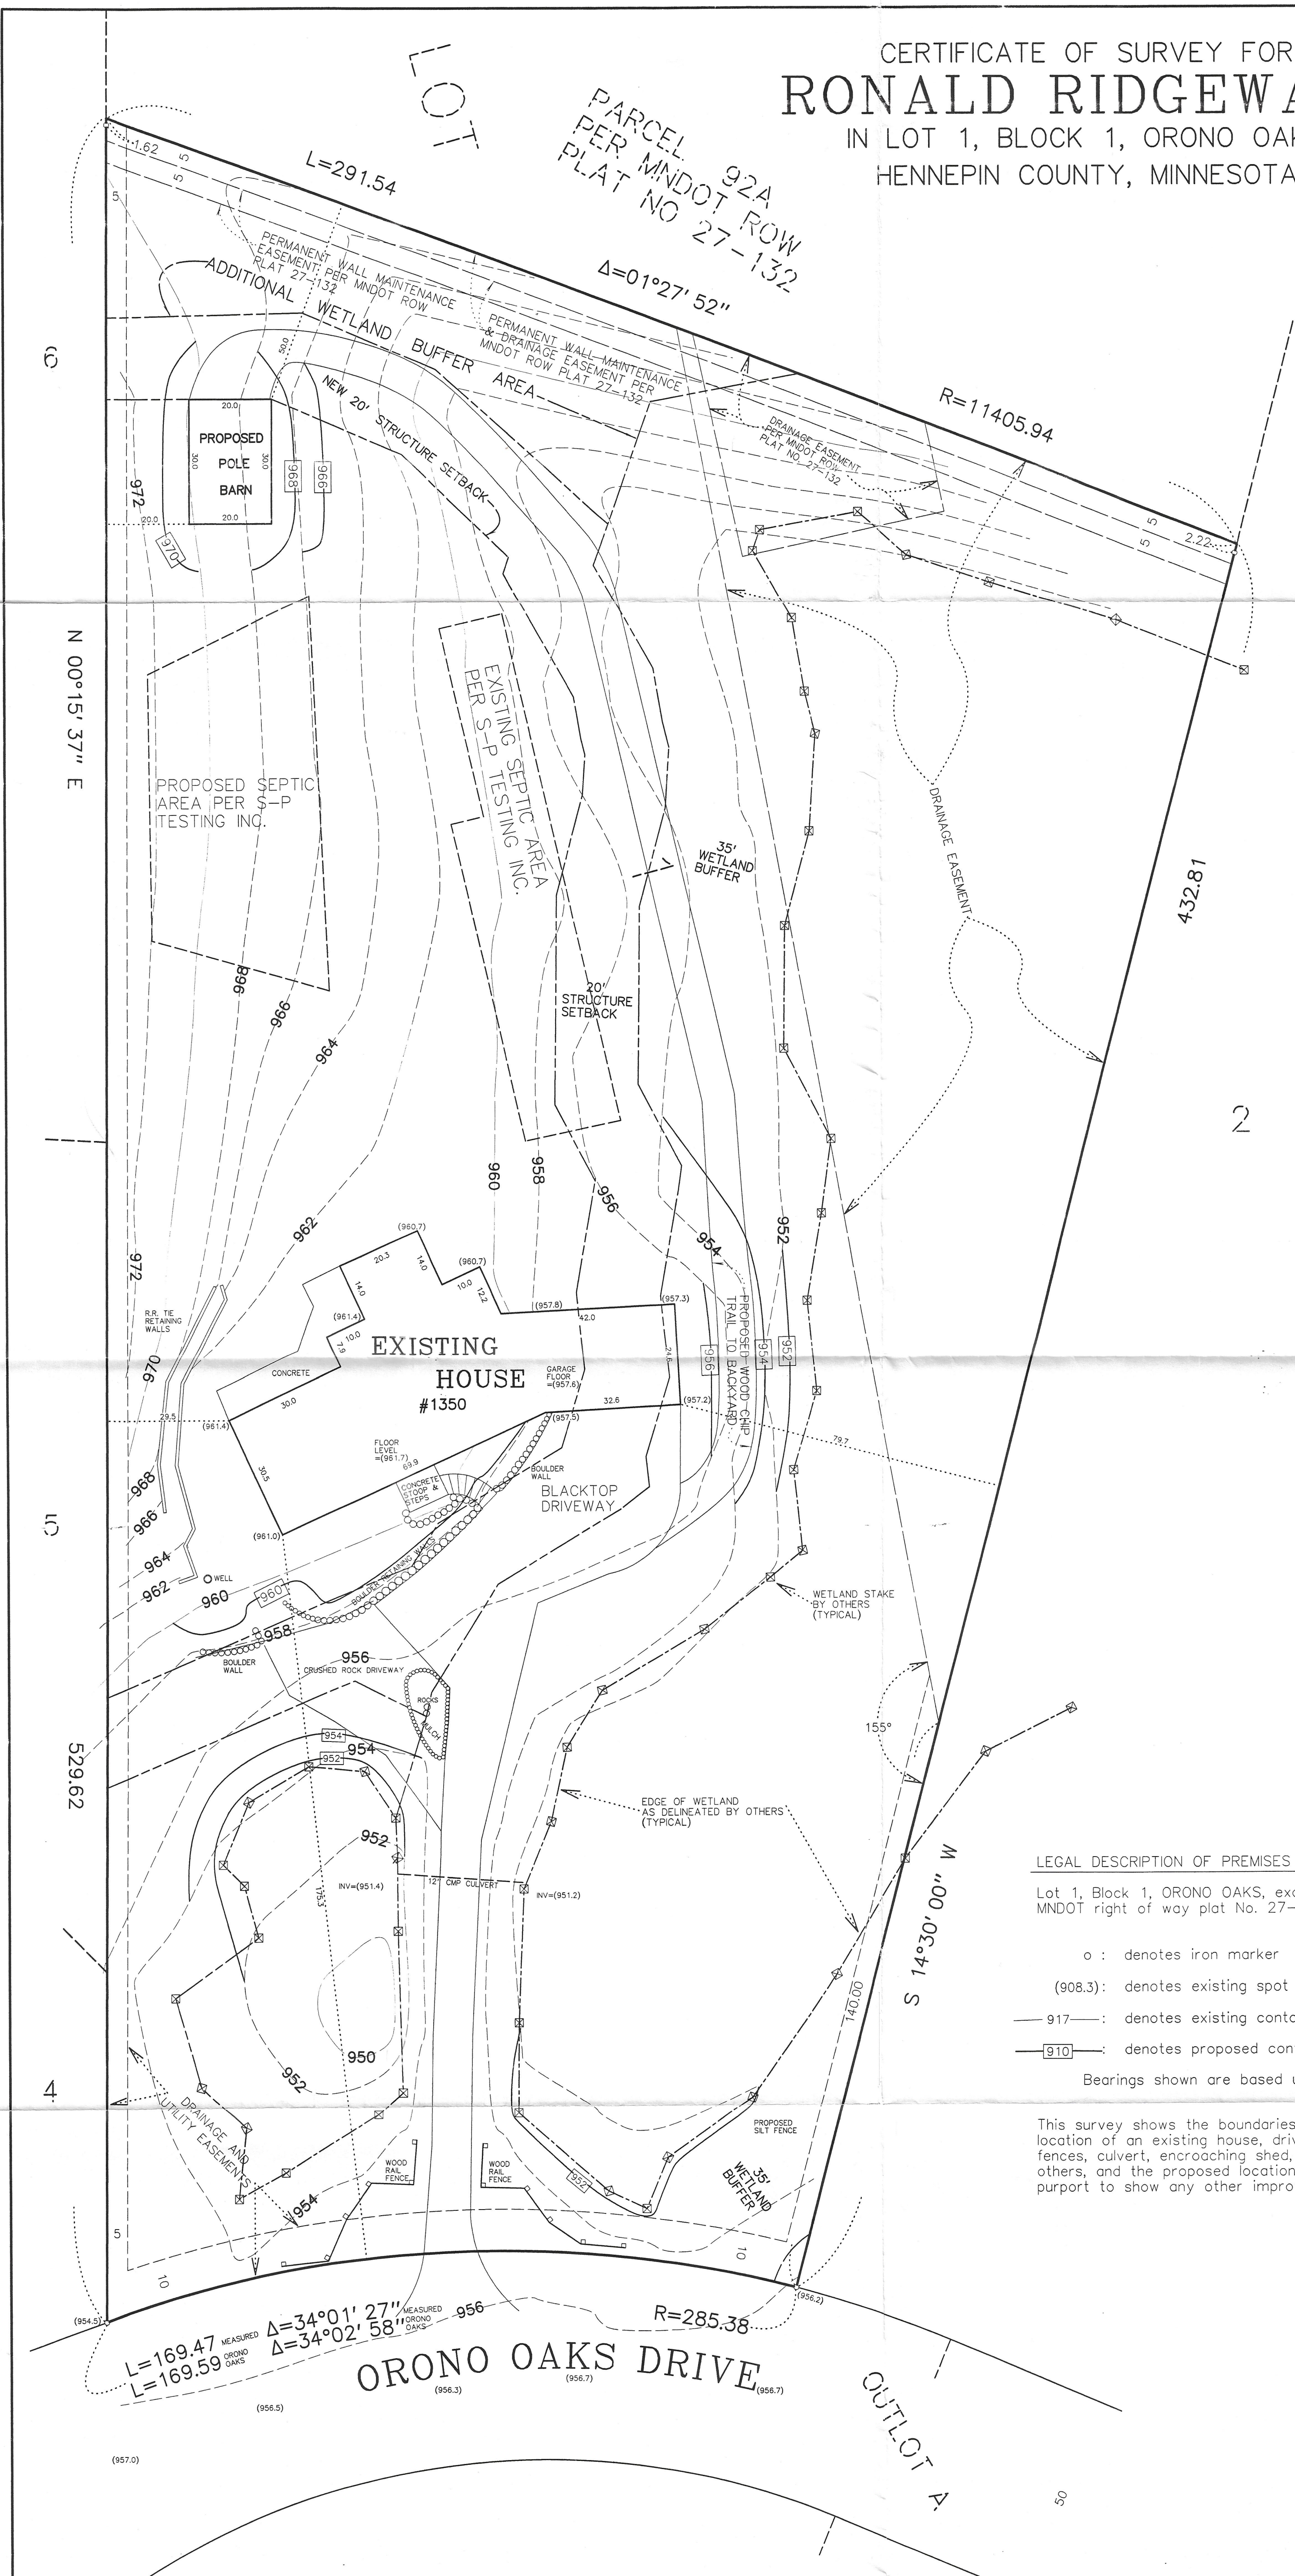

LEGAL DESCRIPTION OF PREMISES :

Lot 1, Block 1, ORONO OAKS, except parcel 92A, as shown on MNDOT right of way plat No. 27-132.

- o : denotes iron marker
(908.3) : denotes existing spot elevation, mean sea level datum
— 917 — : denotes existing contour line, mean sea level datum
— 910 — : denotes proposed contour line, mean sea level datum
Bearings shown are based upon an assumed datum.

This survey shows the boundaries of the above described property, and the location of an existing house, driveway, patio, sidewalk, two retaining walls, wood fences, culvert, encroaching shed, fill areas, edge of wetlands, as delineated by others, and the proposed location of a proposed pole barn thereon. It does not purport to show any other improvements or encroachments.

RECEIVED
SEP 18 2008
CITY OF ORONO

REVISIONS	
DATE	REMARKS

DESIGNED	I HEREBY CERTIFY THAT THIS PLAN, SPECIFICATION OR REPORT WAS PREPARED BY ME OR UNDER MY DIRECT SUPERVISION, AND THAT I AM A DULY LICENSED PROFESSIONAL ENGINEER AND LAND SURVEYOR UNDER THE LAWS OF THE STATE OF MINNESOTA. <i>Michael J. Johnson</i>
DRAWN	
CHECKED	
DATE	7-2-08
MINN. LICENSE NUMBER	11757

DATE	7-2-08
SCALE	1"=20'
JOB NO.	08-167
SHEET	OF 1



GRONBERG & ASSOCIATES, INC.
CIVIL ENGINEERS, LAND SURVEYORS, LAND PLANNERS
445 N. WILLOW DRIVE LONG LAKE, MN 55356
PHONE: 952-473-4141 FAX: 952-473-4435